


- WIRED CONDUIT (2") (PVC)**
- STA. 100+50, 40' RT - STA. 100+80, 54' LT: 109'
  - STA. 100+65, 71' LT - STA. 100+80, 53' LT: 23'
  - STA. 100+80, 54' LT - STA. 101+06, 31' LT: 33'
  - STA. 101+06, 31' LT - STA. 101+46, 40' LT: 62'
  - STA. 101+46, 40' LT - STA. 101+58, 54' LT: 28'
  - STA. 101+58, 54' LT - STA. 101+84, 28' LT: 52'
  - STA. 101+84, 28' LT - STA. 102+25, 22' LT: 52'
- ELECTRICAL CONDUIT SLEEVE (4") (PVC) (SCH. 80)**
- STA. 100+70, 25' RT - STA. 100+77, 37' LT: 62'
  - STA. 101+59, 50' LT - STA. 101+84, 26' LT: 46'
- JUNCTION BOX**
- HH-1: STA. 100+82, 54' LT
  - HH-2: STA. 101+58, 54' LT
  - HH-1A: STA. 100+69, 26' RT

SITE LIGHTING SCHEDULE - SHEET 1

SITE LIGHT NO.	LOCATION	OFFSET	TYPE	FEED OVERHEAD-OH UNDERGROUND-UG	LUMINAIRE		MOUNTING TYPE & HEIGHT	LUMINAIRE & ARM QUANTITY	ARM STYLE LENGTH OF ARM
					WATTS	TYPE			
SL-1	100+63.0	LT52.0'	A	UG	85	QL	POLE - 14'	I	NONE - POST TOP
SL-2	100+50.9	RT37.7'	A	UG	85	QL	POLE - 14'	I	NONE - POST TOP
SL-3	101+16.0	LT29.4'	A	UG	85	QL	POLE - 14'	I	NONE - POST TOP
SL-4	101+53.6	LT46.4'	A	UG	85	QL	POLE - 14'	I	NONE - POST TOP
SL-5	101+83.3	LT27.9'	A	UG	85	QL	POLE - 14'	I	NONE - POST TOP

NOTES:  
 1. SEE DEMOLITION NOTES ON LIGHTING DETAIL LID-3 FOR ELECTRICAL DEMOLITION REQUIREMENTS

REVISION	BY	DATE
2 DRAINAGE REV. ADDED WATER LINE	JBL	04/22/11

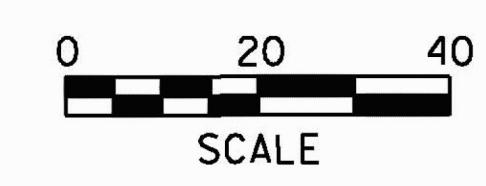

**RECORD DRAWING**  
**DATE: DECEMBER 21, 2012**

PROJECT NAME: COLCHESTER CAMPUS CONNECTOR  
 PROJECT NUMBER: TCSP TCSE (007)  
 FILE NAME: ...plotfiles\115-122.Light.pxf PLOT DATE: 4/22/2011  
 PROJECT LEADER: JBL DRAWN BY: PZA  
 DESIGNED BY: MLC CHECKED BY: GGG  
**LIGHTING & UTILITY PLAN LUP-1** SHEET 111 OF 153