

SITE LIGHTING SCHEDULE - SHEET 2

SITE LIGHT NO.	LOCATION	OFFSET	TYPE	FEED OVERHEAD-OH UNDERGROUND-UG	LUMINAIRE		MOUNTING TYPE & HEIGHT	LUMINAIRE & ARM QUANTITY	ARM STYLE LENGTH OF ARM
					WATTS	TYPE			
SL-6	102+52	LT22'	A	UG	85	QL	POLE - 14'	1	NONE - POST TOP
SL-7	103+31	LT22'	A	UG	85	QL	POLE - 14'	1	NONE - POST TOP
SL-8	104+08	LT22'	A	UG	85	QL	POLE - 14'	1	NONE - POST TOP
SL-9	104+94	LT18'	A	UG	85	QL	POLE - 14'	1	NONE - POST TOP
SL-10	105+66	LT18'	A	UG	85	QL	POLE - 14'	1	NONE - POST TOP
SL-11	106+37	LT18'	A	UG	85	QL	POLE - 14'	1	NONE - POST TOP

STREET LIGHTING LEGEND


SYMBOL	DESCRIPTION
○	SL-X TYPE A STREET LIGHT
□	HH-X HAND HOLE #X
⊠	ELECTRIC METER & PANEL BOARD
⊞	POLE MOUNTED UTILITY TRANSFORMER
---	WIRED CONDUIT

- WIRED CONDUIT (2") (PVC)**
- STA. 102+25, 22' LT - STA. 102+52, 22' LT: 30'
 - STA. 102+52, 22' LT - STA. 103+31, 22' LT: 83'
 - STA. 103+31, 22' LT - STA. 104+08, 22' LT: 86'
 - STA. 104+08, 22' LT - STA. 104+94, 18' LT: 84'
 - STA. 104+94, 18' LT - STA. 105+66, 18' LT: 77'
 - STA. 105+66, 18' LT - STA. 105+90, 22' LT: 29'
 - STA. 105+90, 22' LT - STA. 106+01, 18' LT: 14'
 - STA. 105+90, 22' LT - STA. 106+37, 18' LT: 51'
 - STA. 105+90, 22' LT - STA. 106+75, 22' LT: 85'
 - STA. 106+01, 18' LT - STA. 106+18, 19' LT: 25'
 - STA. 106+38, 19' LT - STA. 106+75, 22' LT: 40'
- ELECTRICAL CONDUIT SLEEVE (4") (PVC) (SCH. 80)**
- STA. 102+94, 22' LT - STA. 103+30, 23' LT: 37'
 - STA. 104+96, 18' LT - STA. 105+27, 18' LT: 31'
 - STA. 106+40, 19' LT - STA. 106+77, 21' LT: 36'
- ELECTRICAL CONDUIT SLEEVE (6") (PVC) (SCH. 80)**
- STA. 106+40, 19' LT - STA. 106+77, 21' LT: 36'
- JUNCTION BOX**
- HH-31 STA. 105+90, 18' LT

- NOTES:**
- ELECTRICAL METER AND PANEL BOARD SHALL BE A MIN. 2' FROM EDGE OF SIDEWALK AND 4' FROM EDGE OF PAVEMENT. SEE LIGHTING DETAIL LID-3 FOR MORE INFORMATION. REFER TO ONE LINE DIAGRAM FOR WIRE SPECIFICATIONS. THE ELECTRICAL METER AND POWER BOARD SHALL BE PAID AS ITEM 900.6452 - SPECIAL PROVISION (ELECTRIC POWER BOARD AND CABINET).
 - GMP HAS STREET LIGHT ON THIS POLE. GMP WILL REMOVE LIGHT AND CABLE. MAIN LINE ACROSS ROAD IS NOT ATTACHED TO THIS POLE. FAIRPOINT AND COMCAST NEED TO RELOCATE POLE OR BURY IN THIS AREA.
 - THIS POLE IS OK FOR GMP USE ONLY. IF FAIRPOINT AND COMCAST WANT TO RELOCATE FROM ACROSS ROAD POLE WILL NEED TO BE REPLACED.

REVISION

REVISION	BY	DATE
△ DRAINAGE REV. LIGHTING REV. ADDED WATER LINE	JBL	04/22/11

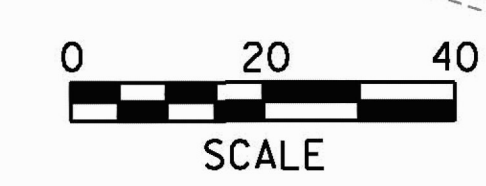

RECORD DRAWING
DATE: DECEMBER 21, 2012

PROJECT NAME:	COLCHESTER CAMPUS CONNECTOR
PROJECT NUMBER:	TCSP TCSE (007)
FILE NAME: ... \plotfiles\115-122.Light.plt	PLOT DATE: 4/22/2011
PROJECT LEADER: JBL	DRAWN BY: PZA
DESIGNED BY: MLC	CHECKED BY: GGG
LIGHTING & UTILITY PLAN LUP-2	SHEET 112 OF 153