

SITE LIGHTING SCHEDULE - SHEET 5

SITE LIGHT NO.	LOCATION	OFFSET	TYPE	FEED OVERHEAD-OH UNDERGROUND-UG	LUMINAIRE		MOUNTING TYPE & HEIGHT	LUMINAIRE & ARM QUANTITY	ARM STYLE LENGTH OF ARM
					WATTS	TYPE			
SL-20	113+11	LT16.3'	A	UG	85	QL	POLE - 14'	1	NONE - POST TOP
SL-21	113+76	LT16.3'	A	UG	85	QL	POLE - 14'	1	NONE - POST TOP
SL-22	114+43	LT16.3'	A	UG	85	QL	POLE - 14'	1	NONE - POST TOP
SL-23	115+28	LT16.3'	A	UG	85	QL	POLE - 14'	1	NONE - POST TOP
SL-24	116+09	LT16.3'	A	UG	85	QL	POLE - 14'	1	NONE - POST TOP
SL-25	116+91	LT16.3'	A	UG	85	QL	POLE - 14'	1	NONE - POST TOP
SL-26	117+72	LT16.3'	A	UG	85	QL	POLE - 14'	1	NONE - POST TOP
SL-27	118+52	LT16.3'	A	UG	85	QL	POLE - 14'	1	NONE - POST TOP


WIRED CONDUIT (2") (PVC)

△	STA. 112+75	16.3'	LT - STA. 113+11	16.3'	LT: 37'
△	STA. 112+75	16.8'	LT - STA. 114+96	16.8'	LT: 221'
△	STA. 113+11	16.3'	LT - STA. 113+76	16.3'	LT: 63'
△	STA. 113+76	16.3'	LT - STA. 114+43	16.3'	LT: 64'
△	STA. 114+43	16.3'	LT - STA. 114+96	16.3'	LT: 51'
△	STA. 114+96	16.3'	LT - STA. 115+28	16.3'	LT: 35'
△	STA. 114+96	16.8'	LT - STA. 118+75	16.8'	LT: 379'
△	STA. 115+28	16.3'	LT - STA. 116+09	16.3'	LT: 86'
△	STA. 116+09	16.3'	LT - STA. 116+91	16.3'	LT: 88'
△	STA. 116+91	16.3'	LT - STA. 117+72	16.3'	LT: 87'
△	STA. 117+72	16.3'	LT - STA. 118+52	16.3'	LT: 88'
△	STA. 118+52	16.3'	LT - STA. 118+75	16.3'	LT: 27'

JUNCTION BOX
HH-5: STA. 114+98 17' LT

STREET LIGHTING LEGEND

SYMBOL	DESCRIPTION
○	SL-X TYPE A STREET LIGHT
□	HH-X HAND HOLE #X
■	ELECTRIC METER & PANEL BOARD
▲	POLE MOUNTED UTILITY TRANSFORMER
---	WIRED CONDUIT

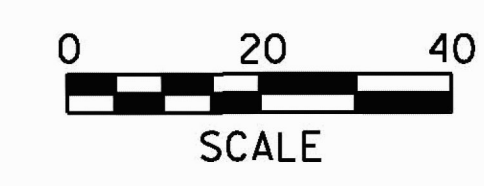

RECORD DRAWING
DATE: DECEMBER 21, 2012

REVISION	BY	DATE
△	JBL	01/24/11
△	JBL	04/22/11

PROJECT NAME:	COLCHESTER CAMPUS CONNECTOR
PROJECT NUMBER:	TCSP TCSE (007)
FILE NAME:	...\\plotfiles\\115-122.Light.plt
PROJECT LEADER:	JBL
DESIGNED BY:	MLC
CHECKED BY:	GGG
PLOT DATE:	4/22/2011
DRAWN BY:	PZA
CHECKED BY:	GGG
LIGHTING & UTILITY PLAN LUP-5	SHEET 115 OF 153

