

SITE LIGHTING SCHEDULE - SHEET 6

SITE LIGHT NO.	LOCATION	OFFSET	TYPE	FEED OVERHEAD-OH UNDERGROUND-UG	LUMINAIRE		MOUNTING TYPE & HEIGHT	LUMINAIRE & ARM QUANTITY	ARM STYLE LENGTH OF ARM
					WATTS	TYPE			
SL-28	119+33	LT 16.3'	A	UG	85	QL	POLE - 14'	I	NONE - POST TOP
SL-29	120+14	LT 16.3'	A	UG	85	QL	POLE - 14'	I	NONE - POST TOP
SL-30	120+96	LT 16.3'	A	UG	85	QL	POLE - 14'	I	NONE - POST TOP
SL-31	121+76	LT 16.3'	A	UG	85	QL	POLE - 14'	I	NONE - POST TOP
SL-32	122+55	LT 16.3'	A	UG	85	QL	POLE - 14'	I	NONE - POST TOP
SL-33	123+35	LT 16.3'	A	UG	85	QL	POLE - 14'	I	NONE - POST TOP
SL-34	124+14	LT 16.3'	A	UG	85	QL	POLE - 14'	I	NONE - POST TOP


W I R E D C O N D U I T (2 ") (P V C)

△ STA. 118+75, 16.3' LT	- STA. 119+33, 16.3' LT	59'
△ STA. 118+75, 16.8' LT	- STA. 121+58, 16.8' LT	283'
△ STA. 119+33, 16.3' LT	- STA. 120+14, 16.3' LT	87'
△ STA. 120+14, 16.3' LT	- STA. 120+96, 16.3' LT	87'
△ STA. 120+96, 16.3' LT	- STA. 121+63, 16.3' LT	67'
△ STA. 120+96, 16.3' LT	- STA. 121+76, 16.3' LT	80'
△ STA. 121+63, 16.3' LT	- STA. 122+55, 16.3' LT	92'
△ STA. 122+55, 16.3' LT	- STA. 123+35, 16.3' LT	86'
△ STA. 123+35, 16.3' LT	- STA. 124+14, 16.3' LT	85'
△ STA. 124+14, 16.3' LT	- STA. 124+50, 16.3' LT	39'

JUNCTION BOX
HH-6: STA. 121+63, 17' LT

STREET LIGHTING LEGEND

SYMBOL	DESCRIPTION
○	SL-X TYPE A STREET LIGHT
□	HH-X HAND HOLE #X
■	ELECTRIC METER & PANEL BOARD
▲	POLE MOUNTED UTILITY TRANSFORMER
---	W I R E D C O N D U I T

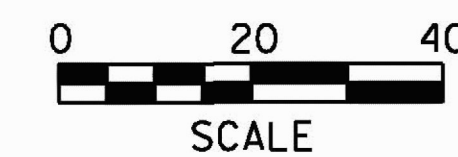

RECORD DRAWING
DATE: DECEMBER 21, 2012

REVISION	BY	DATE
△ ADDENDUM - 1	JBL	01/24/11
△ LIGHTING REV.	JBL	04/22/11

PROJECT NAME:	COLCHESTER CAMPUS CONNECTOR
PROJECT NUMBER:	TCSP TCSE (007)
FILE NAME: ... \plotfiles\115-122.Light.ptf	PLOT DATE: 4/22/2011
PROJECT LEADER: JBL	DRAWN BY: PZA
DESIGNED BY: MLC	CHECKED BY: GGG
LIGHTING & UTILITY PLAN LUP-6	SHEET 116 OF 153