

SITE LIGHT NO.	LOCATION	OFFSET	TYPE	FEED OVERHEAD-OH UNDERGROUND-UG	LUMINAIRE		MOUNTING TYPE & HEIGHT	LUMINAIRE & ARM QUANTITY	ARM STYLE LENGTH OF ARM
					WATTS	TYPE			
SL-35	124+94	LT16.3'	A	UG	85	QL	POLE - 14'	1	NONE - POST TOP
SL-36	125+73	LT16.3'	A	UG	85	QL	POLE - 14'	1	NONE - POST TOP
SL-37	126+54	LT16.3'	A	UG	85	QL	POLE - 14'	1	NONE - POST TOP
SL-38	127+33	LT16.3'	A	UG	85	QL	POLE - 14'	1	NONE - POST TOP
SL-39	128+01	LT35'	A	UG	85	QL	POLE - 14'	1	NONE - POST TOP
SL-40	128+12	RT37'	A	UG	85	QL	POLE - 14'	1	NONE - POST TOP

WIRED CONDUIT (2") (PVC)
 STA. 124+50, 24' LT - STA. 124+94, 16.3' LT: 47'
 STA. 124+94, 16.3' LT - STA. 125+73, 16.3' LT: 84'
 STA. 125+73, 16.3' LT - STA. 126+54, 16.3' LT: 86'
 STA. 126+54, 16.3' LT - STA. 127+33, 16.3' LT: 85'
 STA. 127+33, 16.3' LT - STA. 127+90, 34' LT: 70'
 STA. 127+90, 34' LT - STA. 127+96, 35' LT: 8'
 STA. 127+90, 34' LT - STA. 128+04, 24' RT: 57'
 STA. 128+04, 24' RT - STA. 128+12, 37' RT: 27'


ELECTRICAL CONDUIT SLEEVE (4") (PVC) (SCH. 80)
 STA. 127+91, 21' LT - STA. 127+94, 18' RT: 39'

JUNCTION BOX
 HH-7: STA. 127+90, 34' LT
 HH-8: STA. 128+04, 24' RT


NOTES:
 1. SEE DEMOLITION NOTES ON LIGHTING DETAIL LID-3 FOR ELECTRICAL DEMOLITION REQUIREMENT.

STREET LIGHTING LEGEND

SYMBOL	DESCRIPTION
○	SL-X TYPE A STREET LIGHT
⊗	HH-X HAND HOLE #X
□	ELECTRIC METER & PANEL BOARD
▲	POLE MOUNTED UTILITY TRANSFORMER
---	WIRED CONDUIT

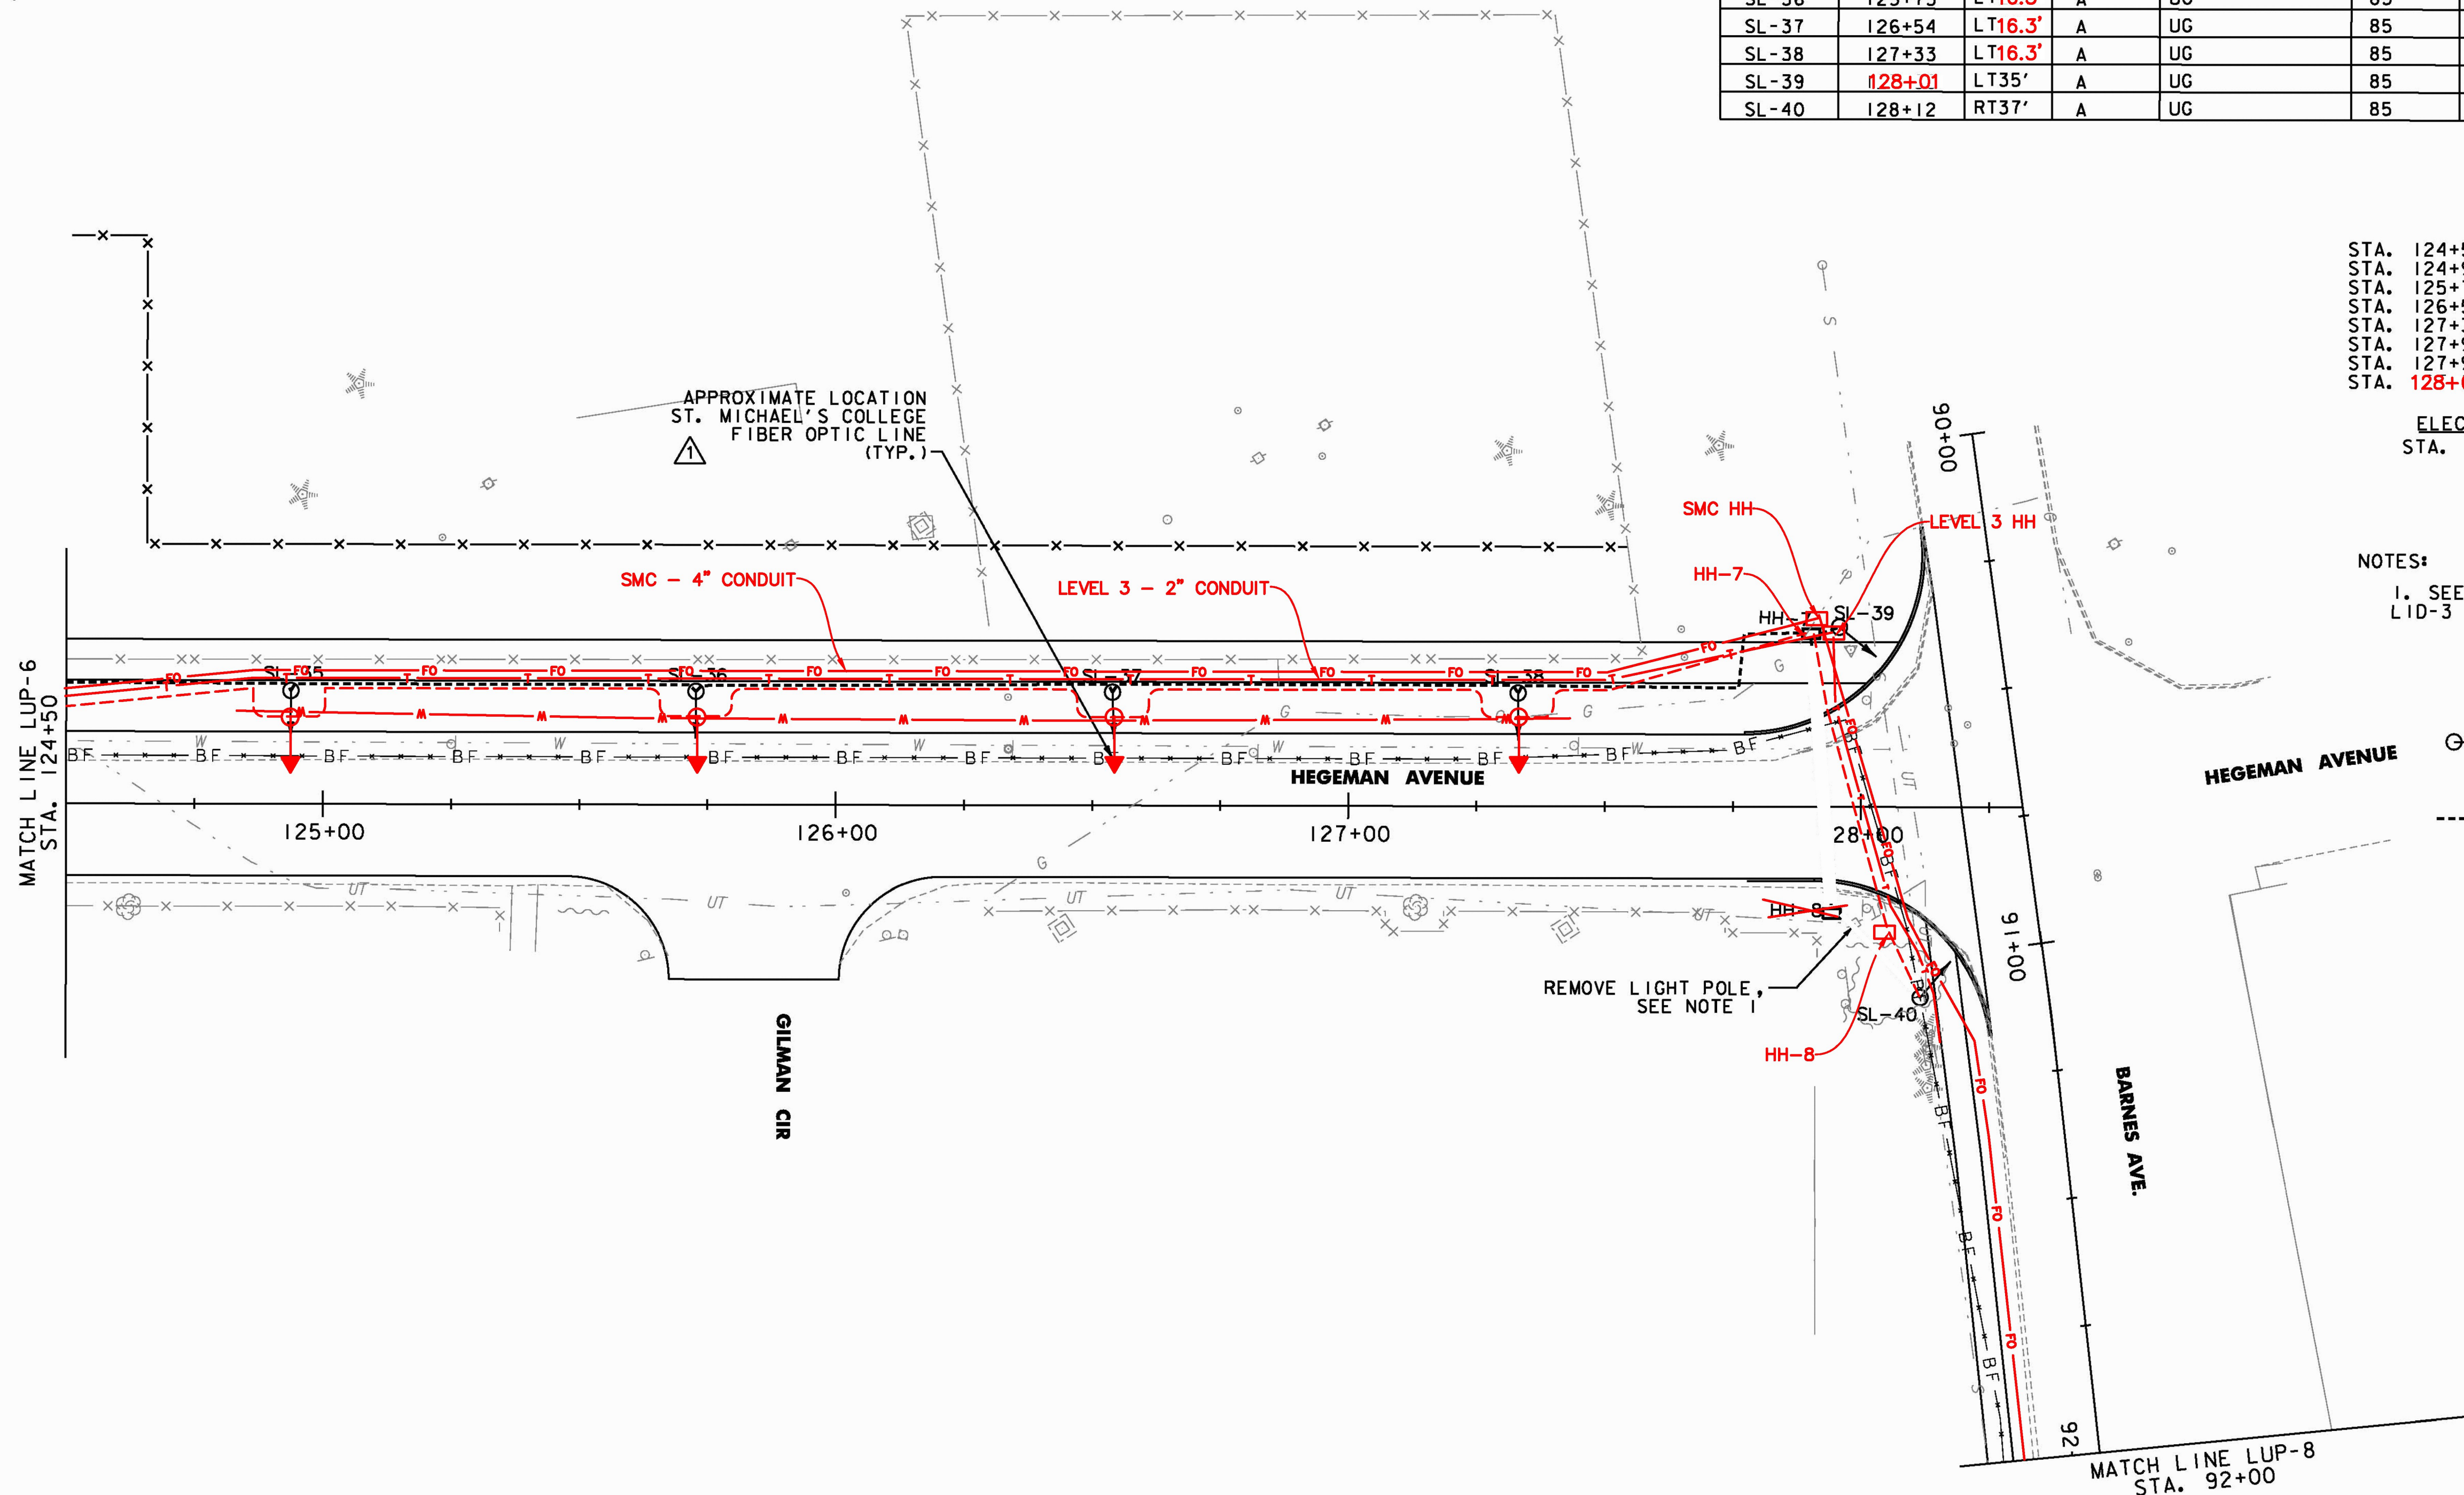

REVISION	BY	DATE
1 ADDENDUM - 1	JBL	01/24/11

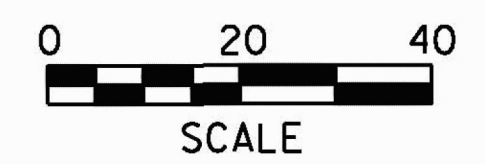

RECORD DRAWING
DATE: DECEMBER 21, 2012

PROJECT NAME: COLCHESTER CAMPUS CONNECTOR
 PROJECT NUMBER: TCSP TCSE (007)
 FILE NAME: ...\\plotfiles\115-122.Light.ptf PLOT DATE: 4/22/2011
 PROJECT LEADER: JBL DRAWN BY: PZA
 DESIGNED BY: MLC CHECKED BY: GGG
LIGHTING & UTILITY PLAN LUP-7 SHEET 117 OF 153