


STREET LIGHTING LEGEND

SYMBOL	DESCRIPTION
○	SL-X TYPE A STREET LIGHT
□	HH-X HAND HOLE #X
■	ELECTRIC METER & PANEL BOARD
▲	POLE MOUNTED UTILITY TRANSFORMER
---	WIRED CONDUIT

RECORD DRAWING
DATE: DECEMBER 21, 2012

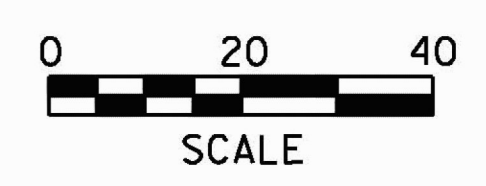

REVISION	BY	DATE
▲ ADDENDUM - 1	JBL	01/24/11

PROJECT NAME:	COLCHESTER CAMPUS CONNECTOR
PROJECT NUMBER:	TCSP TCSE (007)
FILE NAME: ...\\plotfiles\115-122_Light.prf	PLOT DATE: 4/22/2011
PROJECT LEADER: JBL	DRAWN BY: PZA
DESIGNED BY: MLC	CHECKED BY: GGG
LIGHTING & UTILITY PLAN LUP-8	SHEET 118 OF 153