


NOTE:
 ONE LANE WAS MAINTAINED IN BOTH THE WESTERLY AND
 EASTERLY DIRECTIONS ON EACH SIDE OF THE ISLAND OF
 VERMONT NATIONAL GUARD ROAD WEST OF HEGEMAN
 AVENUE DURING ALL PHASES OF CONSTRUCTION EXCEPT
 DURING PAVING. THE CONTRACTOR WAS ABLE TO
 COORDINATE WITH THE GUARD AND ADDRESS ALL TRAFFIC
 FLOW ISSUES WHICH WERE REQUIRED BY THE GUARD.

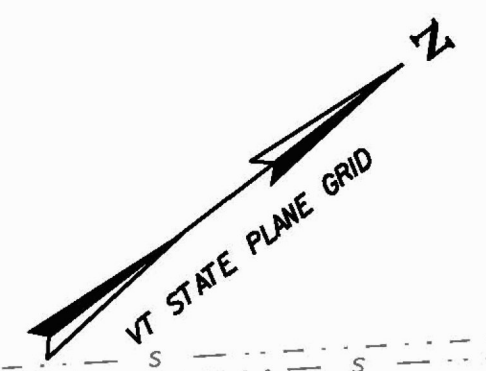

CONSTRUCTION PHASE IA NOTES:

1. PHASE I OF CONSTRUCTION WILL COMPLETE THE VT NATIONAL GUARD ROAD. ALL WORK BEING COMPLETED WITHIN THE ROUTE 15 RIGHT-OF-WAY SHALL BE COMPLETED AT NIGHT.
2. PRIOR TO THE COMMENCEMENT OF ANY WORK OR THE PLACEMENT OF EQUIPMENT ON THE ROADWAY THE CONTRACTOR SHALL PROVIDE THE NECESSARY ADVANCED WARNING SIGNS IN ACCORDANCE WITH THE LATEST VERSION OF THE MUTCD.
3. INSTALL AND MAINTAIN EROSION PREVENTION AND SEDIMENT CONTROL MEASURES IN ACCORDANCE WITH THE EROSION PREVENTION CONTROL PLANS AND DETAILS AND THE VTDEC "LOW RISK SITE HANDBOOK FOR EROSION PREVENTION AND SEDIMENT CONTROL."
- ~~4. ALL SECURITY FENCING AND GATES SHALL BE MOVED OR CONSTRUCTED IN ITS PROPOSED LOCATION. THE ENTIRE LENGTH OF FENCE SHALL BE CONSTRUCTED ALONG THE VT NATIONAL GUARD PROPERTY, BETWEEN STATIONS 108+52 AND 127+54, PRIOR TO BEGINNING ANY OTHER CONSTRUCTION PHASE.~~
6. EXCAVATE, WIDEN AND CONSTRUCT ROADWAY TO THE NORTHEAST OF EXISTING VT NATIONAL GUARD ROAD. ~~CONSTRUCT SIDEWALK ON RIGHT.~~
7. CONTRACTOR SHALL MAKE REQUIRED ADJUSTMENTS TO SIGNAL TIMINGS AND DETECTORS FOR RECONFIGURED LANES.
8. PEDESTRIAN ACCOMODATION SHALL BE MAINTAINED AT ALL TIMES.

NOTES:

1. THE SECURITY FENCE FOR THE VERMONT NATIONAL GUARD WAS INSTALLED AFTER THE CLEARING AND GRUBBING AND THE ROUGH EARTH WORK WAS COMPLETED BETWEEN STA. 108+52 AND STA. 127+54.
2. THE NEW CEMENT CONCRETE SIDEWALK WAS INSTALLED AFTER ALL OF THE UTILITY WORK WAS COMPLETED.

LEGEND:

- ⊗ REFLECTORIZED DRUMS
- - - - TEMPORARY TRAFFIC BARRIER
- ▣ CONSTRUCTION AREA

RECORD DRAWING
DATE: DECEMBER 21, 2012

REVISION	BY	DATE
①	JBL	01/24/11
②	JBL	04/22/11

PROJECT NAME:	COLCHESTER CAMPUS CONNECTOR
PROJECT NUMBER:	TCSP TCSE (007)
FILE NAME: ... \plotfiles\126_tc.pxf	PLOT DATE: 4/22/2011
PROJECT LEADER: JBL	DRAWN BY: TFD
DESIGNED BY: TFD	CHECKED BY: GGG
TRAFFIC CONTROL - PHASE IA PLAN 1 SHEET 123 OF 153	

