


NOTE:
 ONE LANE WAS MAINTAINED IN BOTH THE WESTERLY AND
 EASTERLY DIRECTIONS ON EACH SIDE OF THE ISLAND OF
 VERMONT NATIONAL GUARD ROAD WEST OF HEGEMAN
 AVENUE DURING ALL PHASES OF CONSTRUCTION EXCEPT
 DURING PAVING. THE CONTRACTOR WAS ABLE TO
 COORDINATE WITH THE GUARD AND ADDRESS ALL TRAFFIC
 FLOW ISSUES WHICH WERE REQUIRED BY THE GUARD.

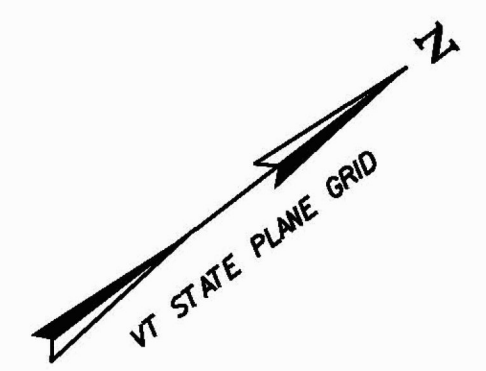

NOTES:

1. THE NEW STRAIN POLE WAS NOT INSTALLED. AN AGREEMENT WAS REACHED BETWEEN GREEN MOUNTAIN POWER INC. AND THE VERMONT AGENCY OF TRANSPORTATION TO LOCATE THE STRAIN WIRE ON THE NEWLY INSTALLED UTILITY POLE AT STA. 30+27, RT.
2. THE NEW CEMENT CONCRETE SIDEWALK WAS INSTALLED AFTER ALL OF THE UTILITY WORK WAS COMPLETED.
3. DURING PHASE 1A THE CONTRACTOR CONSTRUCTED A TEMPORARY LANE ON THE NORTH SIDE OF VERMONT NATIONAL GUARD ROAD WHICH ALLOWED THEM TO CONSTRUCT THE TWO OUTBOUND BOUND LANES DURING THE SAME PHASE OF CONSTRUCTION.

CONSTRUCTION PHASE 1B NOTES:

1. ALL WORK BEING COMPLETED WITHIN THE ROUTE 15 RIGHT-OF-WAY SHALL BE COMPLETED AT NIGHT.
2. PRIOR TO THE COMMENCEMENT OF ANY WORK OR THE PLACEMENT OF EQUIPMENT ON THE ROADWAY THE CONTRACTOR SHALL PROVIDE THE NECESSARY ADVANCED WARNING SIGNS IN ACCORDANCE WITH THE LATEST VERSION OF THE MUTCD.
3. INSTALL AND MAINTAIN EROSION PREVENTION AND SEDIMENT CONTROL MEASURES IN ACCORDANCE WITH THE EROSION PREVENTION CONTROL PLANS AND DETAILS AND THE VTDEC "LOW RISK SITE HANDBOOK FOR EROSION PREVENTION AND SEDIMENT CONTROL."
4. ~~EXCAVATE AND CONSTRUCT ROADWAY IN THE CENTER OF THE VT NATIONAL GUARD ROAD.~~
5. PEDESTRIAN ACCOMODATION SHALL BE MAINTAINED AT ALL TIMES.

LEGEND:

- ⊗ REFLECTORIZED DRUMS
- - - TEMPORARY TRAFFIC BARRIER
- ▣ CONSTRUCTION AREA


25' MAX. DRUM SPACING (TYP.)

TEMPORARY 4" YELLOW LINE

TEMPORARY 4" WHITE LINE

(2) 11' TRAVEL LANES
 (2) 1' SHOULDERS

SIDEWALK CLOSED

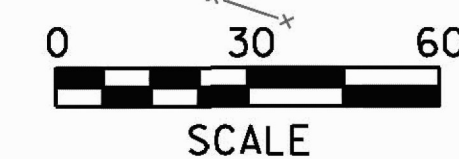

REVISION	BY	DATE
① ADDENDUM - 1	JBL	01/24/11
② DRAINAGE REV. LIGHTING REV. ADDED WATER LINE UTILITY ACCESS METER VAULT	JBL	04/22/11

RECORD DRAWING
DATE: DECEMBER 21, 2012

PROJECT NAME: COLCHESTER CAMPUS CONNECTOR	PLOT DATE: 4/22/2011
PROJECT NUMBER: TCSP TCSE (007)	DRAWN BY: TFD
FILE NAME: ...\\plotfiles\126_tc.ptf	CHECKED BY: GGG
PROJECT LEADER: JBL	SHEET 125 OF 153
DESIGNED BY: TFD	
TRAFFIC CONTROL - PHASE 1B	

