

**CONSTRUCTION PHASE II NOTES:**

1. PHASE II OF CONSTRUCTION WILL CONNECT JOHNSON AVENUE TO HEGEMAN AVENUE AND RECONSTRUCT THE JUGHANDLE. ALL WORK BEING COMPLETED WITHIN THE ROUTE 15 RIGHT-OF-WAY SHALL BE COMPLETED AT NIGHT.
2. PRIOR TO THE COMMENCEMENT OF ANY WORK OR THE PLACEMENT OF EQUIPMENT ON THE ROADWAY THE CONTRACTOR SHALL PROVIDE THE NECESSARY ADVANCED WARNING SIGNS IN ACCORDANCE WITH THE LATEST VERSION OF THE MUTCD.
3. INSTALL AND MAINTAIN EROSION PREVENTION AND SEDIMENT CONTROL MEASURES IN ACCORDANCE WITH THE EROSION PREVENTION CONTROL PLANS AND DETAILS AND THE VTDEC "LOW RISK SITE HANDBOOK FOR EROSION PREVENTION AND SEDIMENT CONTROL."
4. JOHNSON AVENUE AND HEGEMAN AVENUE CONSTRUCTION AREAS WILL BE COMPLETELY CLOSED TO THRU TRAFFIC. ONLY THE CONTRACTOR SHALL HAVE ACCESS TO THESE AREAS. ACCESS SHALL BE MAINTAINED AT ALL TIMES TO THE WINCHESTER PLACE MAINTENANCE BUILDING.
5. SOME DRIVEWAYS INSIDE WINCHESTER PLACE AND THE WINDEMERE MOBILE HOME PARK SHALL BE CLOSED WITHIN THE CONSTRUCTION AREA. THE CONTRACTOR SHALL BE RESPONSIBLE FOR INSTALLING SIGNS ON THE STREETS AND INSIDE THE HOUSING DEVELOPMENTS TO DIRECT TRAFFIC TO OPEN DRIVEWAYS.
6. ~~CONSTRUCT NEW SEWER ON THE RIGHT SIDE OF JOHNSON AVENUE. INSTALL ANY DRAINAGE IN THE CONSTRUCTION AREAS. EXCAVATE AND CONSTRUCT NEW ROADWAYS IN THE CONSTRUCTION AREA. INSTALL NEW CURB. CONSTRUCT NEW SIDEWALK ON THE LEFT SIDE OF THE ROADWAYS. NO NEW SIDEWALK SHALL BE OPENED PRIOR TO THE COMPLETION OF ALL CONSTRUCTION IN THIS PHASE.~~
7. PEDESTRIAN ACCOMODATION SHALL BE MAINTAINED AT ALL TIMES.
8. ONE LANE SHALL BE MAINTAINED THROUGH THE JUG HANDLE AT ALL TIMES.
9. FOR DETAIL ON THE TYPE III BARRICADES SEE VTRANS STANDARD E-107.

**LEGEND:**


- ⊗ REFLECTORIZED DRUMS
- - - TEMPORARY TRAFFIC BARRIER
- ▨ CONSTRUCTION AREA

**NOTES:**

1. ACCESS WAS MAINTAINED FOR RESIDENTS AND BUSINESSES ON JOHNSON AVENUE AT ALL TIMES EXCEPT WHEN CONSTRUCTION TOOK PLACE DIRECTLY IN FRONT OF DRIVEWAYS DURING THE DAY. ACCESS TO THE DRIVEWAYS WAS MAINTAINED AT ALL TIMES OUTSIDE OF CONSTRUCTION HOURS.
2. SEQUENCE OF CONSTRUCTION ON JOHNSON AVENUE ARE AS FOLLOWS:
  - A. EXISTING CURB, PAVEMENT AND SIDEWALK WAS REMOVED IN AREAS REQUIRED TO INSTALL THE NEW UTILITIES OR ROADWAY. THE EXISTING PAVEMENT WAS MAINTAINED UNTIL IT NEEDED TO BE REMOVED TO INSTALL THE NEW ITEMS.
  - B. THE NEW MAINLINE SANITARY SEWER PIPE AND MANHOLES WERE INSTALLED.
  - C. THE EXISTING SANITARY SEWER SERVICES WERE CONNECTED TO THE NEW MAINLINE SEWER AND THE EXISTING SEWER SYSTEM WAS REMOVED.
  - D. THE NEW STORM DRAINAGE PIPE AND STRUCTURES WERE INSTALLED.
  - E. THE NEW LIGHT POLE BASES AND CONDUIT WERE INSTALLED.
  - F. EXCAVATION FOR THE INSTALLATION OF THE NEW GRAVEL SUBBASE WAS COMPLETED AND THE NEW GRAVEL WAS INSTALLED.
  - G. THE NEW CURB AND SIDEWALK WAS INSTALLED.
3. TRAFFIC CONTROL SIGNS AND FLAGGERS WERE UTILIZED AS DIRECTED BY THE RESIDENT ENGINEER TO MAINTAIN ACCESS TO RESIDENTS AND BUSINESSES AT ALL TIMES DURING CONSTRUCTION HOURS.

REVISION	BY	DATE
①	JBL	01/24/11
②	JBL	04/22/11

**RECORD DRAWING**  
**DATE: DECEMBER 21, 2012**

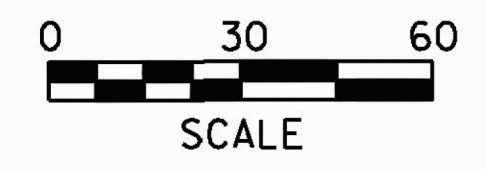

PROJECT NAME:	COLCHESTER CAMPUS CONNECTOR	PLOT DATE:	4/22/2011
PROJECT NUMBER:	TCSP TCSE (007)	DRAWN BY:	TFD
FILE NAME:	...\\plotfiles\126_tc.prf	CHECKED BY:	GGG
PROJECT LEADER:	JBL	TRAFFIC CONTROL - PHASE II PLAN 1	SHEET 127 OF 153