


RECORD DRAWING
DATE: DECEMBER 21, 2012

REVISION	BY	DATE
△ ADDENDUM - 1	JBL	01/24/11
△ LIGHTING REV.	JBL	04/22/11

LEGEND:

- ⊗ REFLECTORIZED DRUMS
- - - TEMPORARY TRAFFIC BARRIER
- ▨ CONSTRUCTION AREA

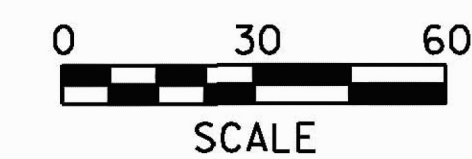

PROJECT NAME:	COLCHESTER CAMPUS CONNECTOR
PROJECT NUMBER:	TCSP TCSE (007)
FILE NAME: ... \plotfiles\126_tc.ptf	PLOT DATE: 4/22/2011
PROJECT LEADER: JBL	DRAWN BY: TFD
DESIGNED BY: TFD	CHECKED BY: GGG
TRAFFIC CONTROL - PHASE II PLAN 2	SHEET 128 OF 153