

CONSTRUCTION PHASE IIIA NOTES:


1. THIS PORTION OF CONSTRUCTION CAN BE COMPLETED CONCURRENTLY WITH THE JOHNSON AVENUE CONSTRUCTION.
2. PRIOR TO THE COMMENCEMENT OF ANY WORK OR THE PLACEMENT OF EQUIPMENT ON THE ROADWAY THE CONTRACTOR SHALL PROVIDE THE NECESSARY ADVANCED WARNING SIGNS IN ACCORDANCE WITH THE LATEST VERSION OF THE MUTCD.
3. INSTALL AND MAINTAIN EROSION PREVENTION AND SEDIMENT CONTROL MEASURES IN ACCORDANCE WITH THE EROSION PREVENTION CONTROL PLANS AND DETAILS AND THE VTDEC "LOW RISK SITE HANDBOOK FOR EROSION PREVENTION AND SEDIMENT CONTROL."
4. SOME DRIVEWAYS INSIDE WINCHESTER PLACE SHALL BE CLOSED WITHIN THE CONSTRUCTION AREA. THE CONTRACTOR SHALL BE RESPONSIBLE FOR INSTALLING SIGNS ON THE STREETS AND INSIDE THE HOUSING DEVELOPMENT TO DIRECT TRAFFIC TO OPEN DRIVEWAYS.
5. EXCAVATE AND CONSTRUCT NEW ROADWAYS IN THE CONSTRUCTION AREA. INSTALL NEW CURB. CONSTRUCT NEW SIDEWALK ON THE LEFT SIDE OF THE ROADWAYS.

LEGEND:

- ⊗ REFLECTORIZED DRUMS
- - - TEMPORARY TRAFFIC BARRIER
- ▣ CONSTRUCTION AREA

RECORD DRAWING
DATE: DECEMBER 21, 2012

REVISION	BY	DATE
1	JBL	01/24/11
2	JBL	04/22/11

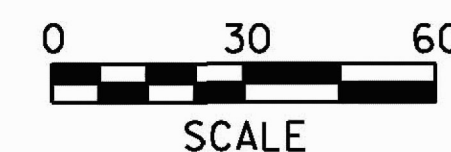

PROJECT NAME:	COLCHESTER CAMPUS CONNECTOR
PROJECT NUMBER:	TCSP TCSE (007)
FILE NAME: ... \plotfiles\126_tc.ptf	PLOT DATE: 4/22/2011
PROJECT LEADER: JBL	DRAWN BY: TFD
DESIGNED BY: TFD	CHECKED BY: GGG
TRAFFIC CONTROL - PHASE IIIA PLAN 2 SHEET 132 OF 153	