

CONSTRUCTION PHASE IV NOTES:

1. PRIOR TO THE COMMENCEMENT OF ANY WORK OR THE PLACEMENT OF EQUIPMENT ON THE ROADWAY THE CONTRACTOR SHALL PROVIDE THE NECESSARY ADVANCED WARNING SIGNS IN ACCORDANCE WITH THE LATEST VERSION OF THE MUTCD.
2. ALL MILLING OPERATIONS AND PAVING BEING COMPLETED WITHIN THE ROUTE 15 RIGHT-OF-WAY SHALL BE COMPLETED AT NIGHT.
3. MILL EXISTING PAVEMENT SURFACE ON ROUTE 15 BETWEEN STATIONS 1+00 AND 8+00.
4. THE TOP COURSE OF PAVEMENT AND PERMANENT PAVEMENT MARKINGS WILL BE CONSTRUCTED IN ALL LOCATIONS SHOWN ON THE PLANS.
5. ALL FINAL SEEDING AND STABILIZATION, NOT PREVIOUSLY COMPLETED, SHALL BE COMPLETED LAST.
6. ALL ROADS WITH THE EXCEPTION OF ROUTE 15 WILL REMAIN OPEN TO TRAFFIC FOR THE ENTIRE PHASE OF CONSTRUCTION. A MINIMUM OF ONE TRAVEL LANE WITH DUAL ALTERNATING TRAFFIC SHALL BE AVAILABLE DURING CONSTRUCTION HOURS WITH A MINIMUM LANE WIDTH OF 11'. DURING NON CONSTRUCTION HOURS TWO LANES ARE REQUIRED. ROUTE 15 SHALL MAINTAIN A MINIMUM OF ONE LANE IN EACH DIRECTION FOR THE ENTIRE PHASE OF CONSTRUCTION.
7. PEDESTRIAN ACCOMODATION SHALL BE MAINTAINED AT ALL TIMES.

LEGEND:


- ⊗ REFLECTORIZED DRUMS
- - - - TEMPORARY TRAFFIC BARRIER
- ▨ CONSTRUCTION AREA

RECORD DRAWING
DATE: DECEMBER 21, 2012

| REVISION | BY | DATE |
|----------|-----|----------|
| 2 | JBL | 04/22/11 |

PROJECT NAME: COLCHESTER CAMPUS CONNECTOR
 PROJECT NUMBER: TCSP TCSE (007)

FILE NAME: ... \plotfiles\126.tc.ptf PLOT DATE: 4/22/2011
 PROJECT LEADER: JBL DRAWN BY: TFD
 DESIGNED BY: TFD CHECKED BY: GGG
TRAFFIC CONTROL - PHASE IV PLAN 1 SHEET 134 OF 153

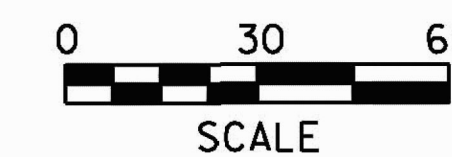

MATCH LINE
SEE TRAFFIC CONTROL - PHASE IV PLAN 2