


**LEGEND:**

- ⊗ REFLECTORIZED DRUMS
- - - - TEMPORARY TRAFFIC BARRIER
- ▨ CONSTRUCTION AREA

***RECORD DRAWING***  
***DATE: DECEMBER 21, 2012***

REVISION	BY	DATE
①	JBL	01/24/11
②	JBL	04/22/11

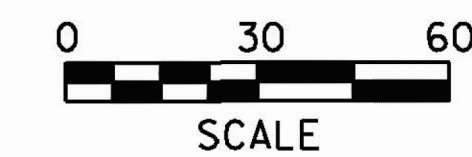

PROJECT NAME: COLCHESTER CAMPUS CONNECTOR  
 PROJECT NUMBER: TCSP TCSE (007)

FILE NAME: ...plotfiles\126\_tc.ptf PLOT DATE: 4/22/2011  
 PROJECT LEADER: JBL DRAWN BY: TFD  
 DESIGNED BY: TFD CHECKED BY: GGG  
**TRAFFIC CONTROL - PHASE IV PLAN 3 SHEET 136 OF 153**