



MATCH LINE
SEE TRAFFIC CONTROL - PHASE IV PLAN 3

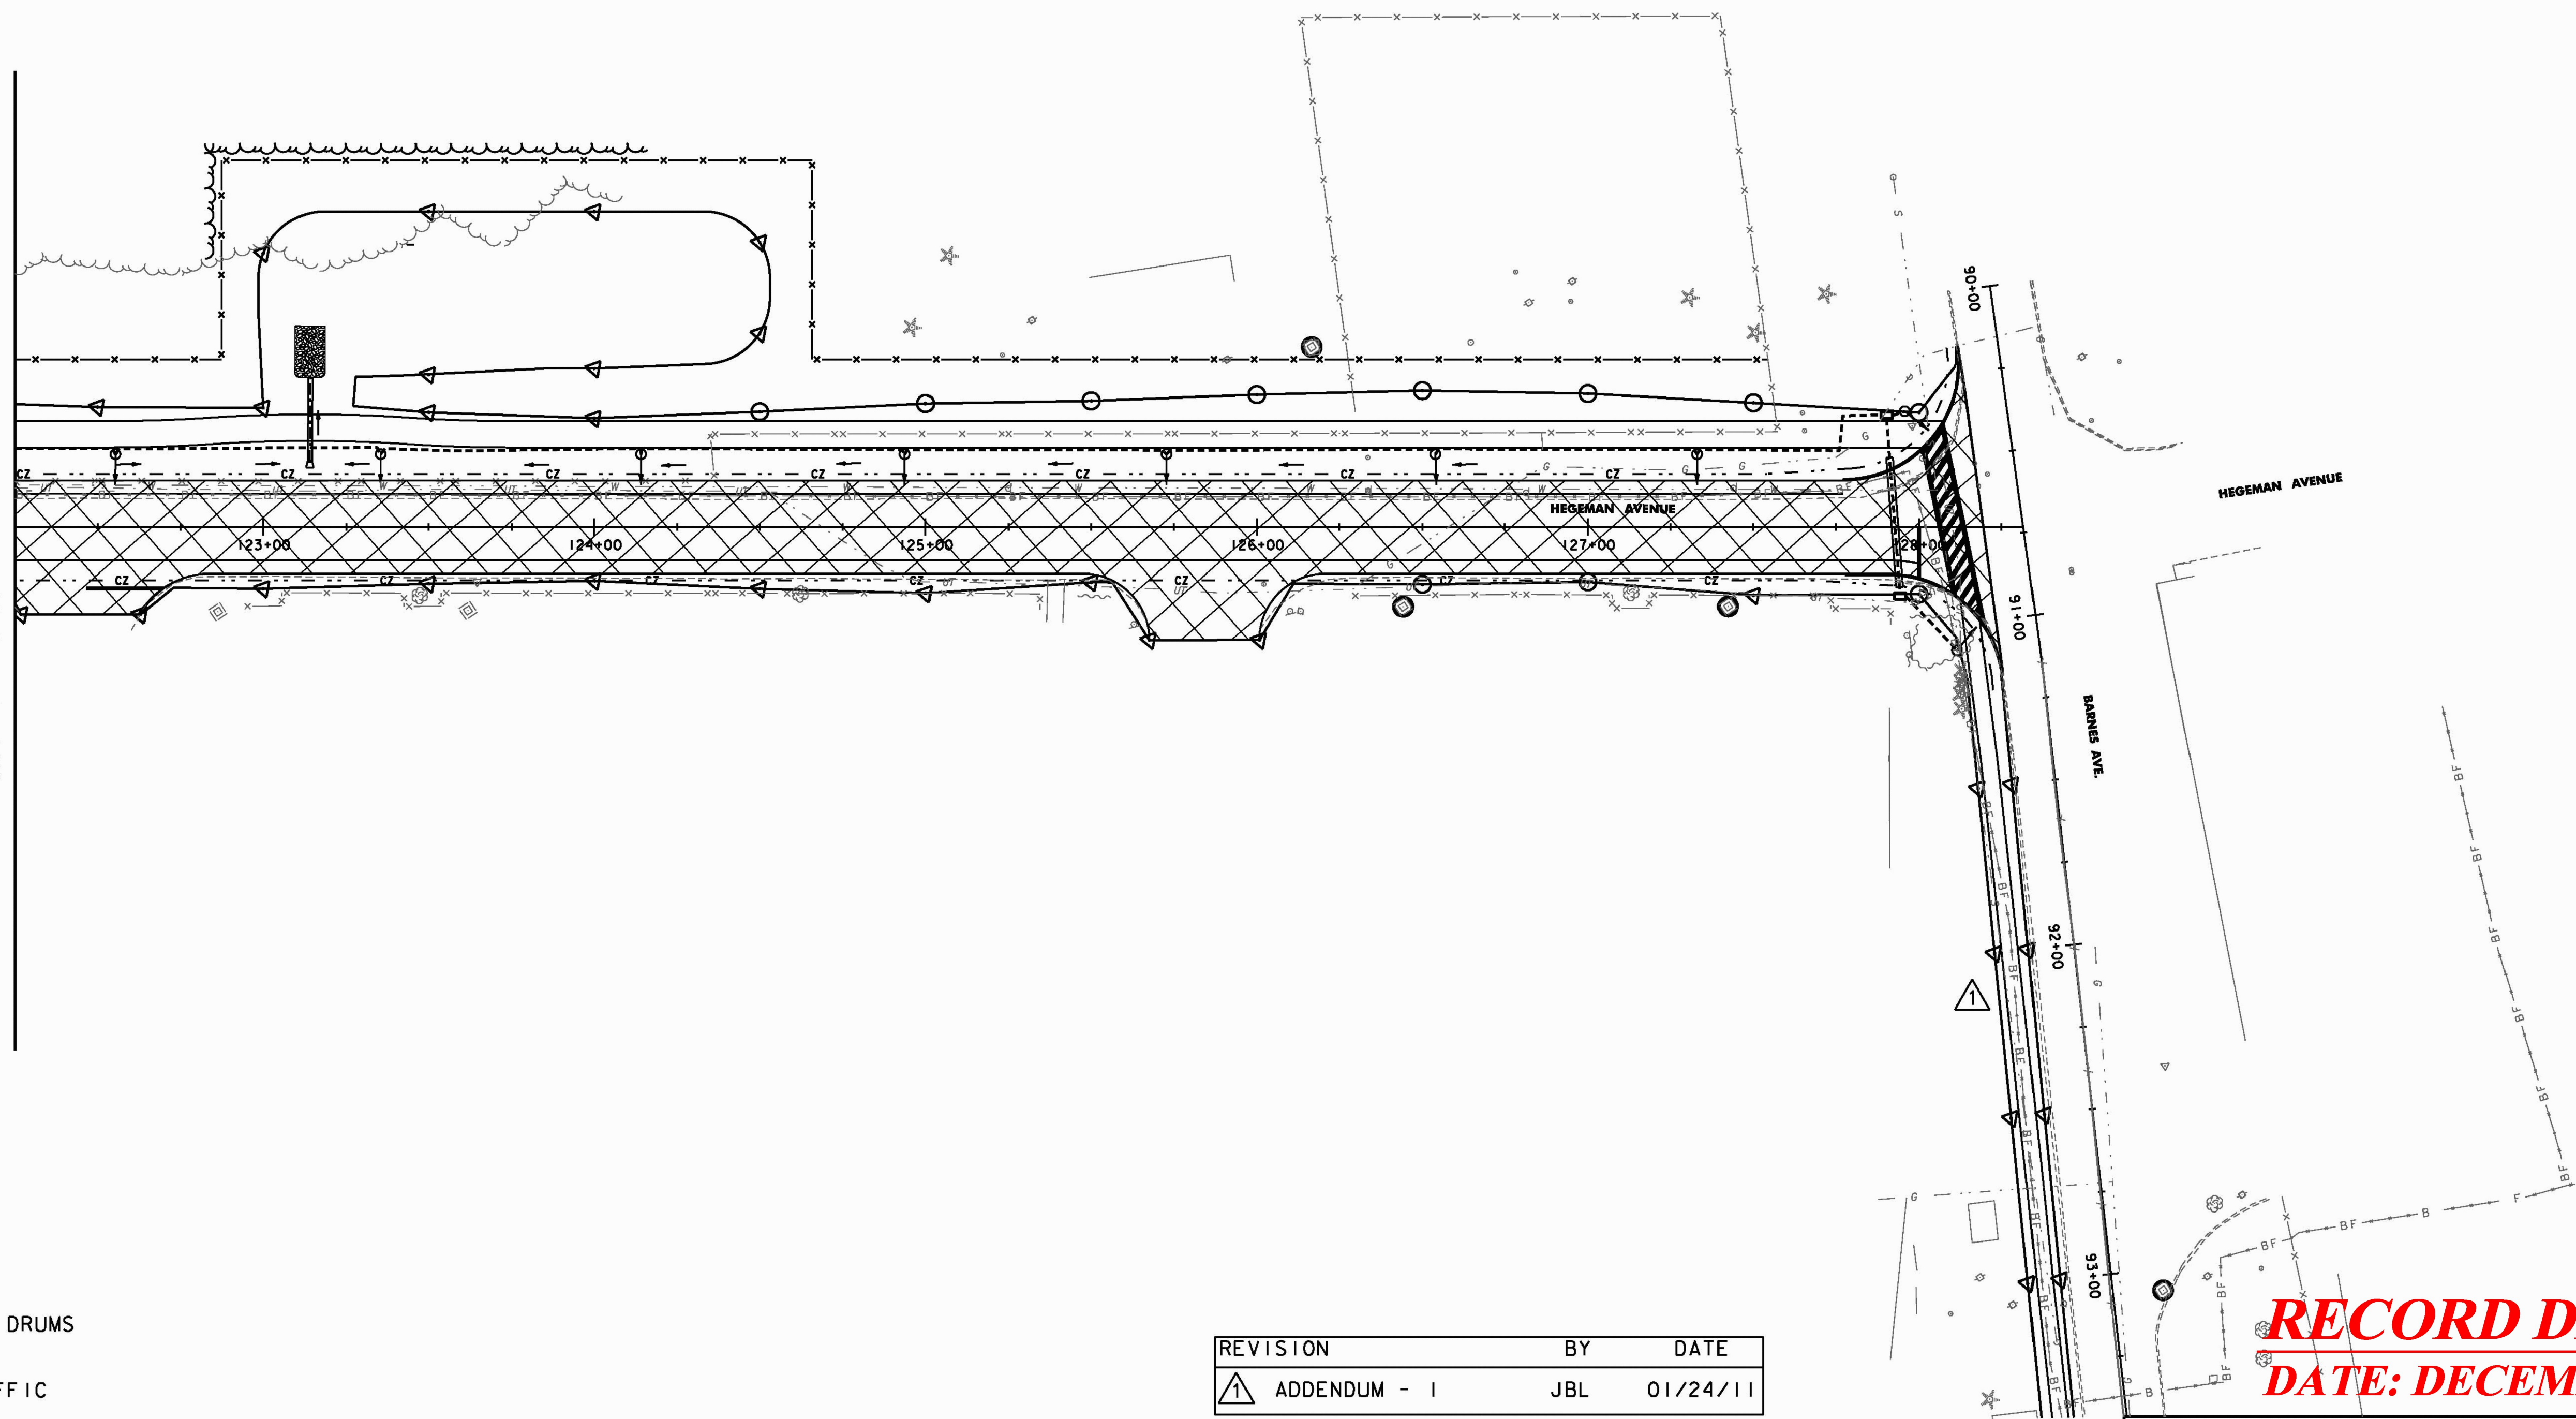

LEGEND:

- ⊗ REFLECTORIZED DRUMS
- - - - TEMPORARY TRAFFIC BARRIER
- ▣ CONSTRUCTION AREA
- ↔ MAINTAIN ACCESS

REVISION	BY	DATE
▲ ADDENDUM - I	JBL	01/24/11

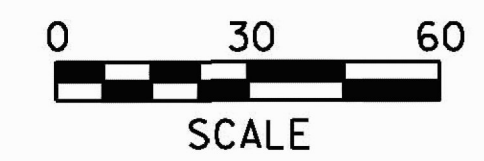

RECORD DRAWING
DATE: DECEMBER 21, 2012

PROJECT NAME: COLCHESTER CAMPUS CONNECTOR
 PROJECT NUMBER: TCSP TCSE (007)
 FILE NAME: ...\\plotfiles\126_tc.p1f PLOT DATE: 4/22/2011
 PROJECT LEADER: JBL DRAWN BY: TFD
 DESIGNED BY: TFD CHECKED BY: GGG
TRAFFIC CONTROL - PHASE IV PLAN 4 SHEET 137 OF 153