


RECORD DRAWING
DATE: DECEMBER 21, 2012

REVISION	BY	DATE
△ ADDENDUM - 1	JBL	01/24/11
△ DRAINAGE REV. ADDED WATER LINE	JBL	04/22/11

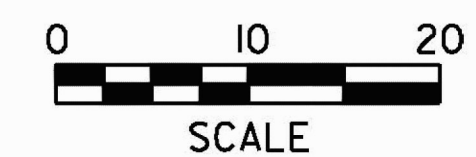

PROJECT NAME:	COLCHESTER CAMPUS CONNECTOR	PLOT DATE:	4/22/2011
PROJECT NUMBER:	TCSP TCSE (007)	DRAWN BY:	TFD
FILE NAME: ...\\plotfiles\132-145_xs.pjf		CHECKED BY:	GGG
DESIGNED BY:	TFD	SHEET	140 OF 153
MAINLINE XS-2			