


RECORD DRAWING
DATE: DECEMBER 21, 2012

REVISION	BY	DATE
ADDENDUM - I	JBL	01/24/11
DRAINAGE REV. ADDED WATER LINE	JBL	04/22/11

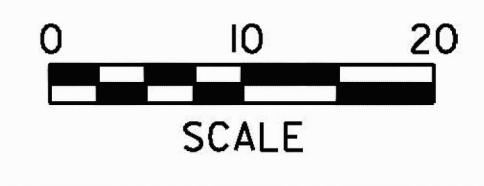

PROJECT NAME: COLCHESTER CAMPUS CONNECTOR	PLOT DATE: 4/22/2011
PROJECT NUMBER: TCSP TCSE (007)	DRAWN BY: TFD
FILE NAME: ...\\plotfiles\132-145.xs.pxf	CHECKED BY: GGG
DESIGNED BY: TFD	SHEET 142 OF 153
MAINLINE XS-4	