


RECORD DRAWING
DATE: DECEMBER 21, 2012

REVISION	BY	DATE
△ UTILITY ACCESS METER VAULT ADDED WATER LINE	JBL	04/22/11

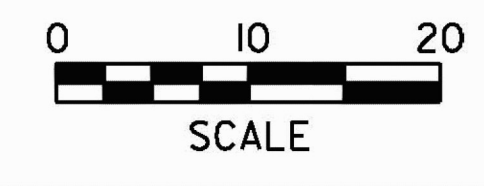

PROJECT NAME: COLCHESTER CAMPUS CONNECTOR	PLOT DATE: 4/22/2011
PROJECT NUMBER: TCSP TCSE (007)	DRAWN BY: TFD
FILE NAME: ... \plotfiles\132-145_xs.ptf	CHECKED BY: GGG
DESIGNED BY: TFD	SHEET 143 OF 153
MAINLINE XS-5	