

BEGIN R.O.W. PROJECT

ST 030-3(4) 197+50.00

24.65' LT.

LAMOILLE RIVER

HAY'S SERVICE STATION

197+50

BEGIN APPROACH ROW TO Z CORP.

REMOVE AND RESETTING LIGHT POLE (MOD.) 200+33 - 200+49 LT (3 EA)

○ = SAVE EXISTING TREES

198+88 END APPROACH BEGIN PROJECT

CONSTRUCT DRIVE 200+60 LT 24' PAVED YIELDING MARKER POSTS 10 EA

STEEL BEAM GUARDRAIL 203+00 - 206+25 LT 325' ANCHOR FOR STEEL BEAM GUARDRAIL 1 EA

STONE FILL, TYPE II FOR SLOPE STABILIZATION 200+60 - 203+20 RT STONE FILL, TYPE III FOR SLOPE STABILIZATION 200+60 - 203+20 RT

REMOVAL AND DISPOSAL OF GUIDE POSTS 2 EA 206+20 +/- LT 130' +/- PLUG EXISTING 4" STEEL PIPE

LEGEND: INCLINOMETER (EXISTING) - INCL (E) ○ INCLINOMETER (NEW) - INCL (N) ○ (50' EA) MONITORING WELL (EXISTING) - MW (E) ⊕ MONITORING WELL (NEW) - MW (N) ⊕

END R.O.W. PROJECT

ST 030-3(4) 205+44.66

38.13' LT.



CURVE DATA
Δ = 28°19'56.45" RT
D = 28°19'56.42"
R = 285.00
T = 71.94
L = 140.93
E = 8.94
BANK = 0.080 FT / FT

HILL, WILLIAM

THIBAUT, LARRY

GOUDREAU, RAYMOND & MARTHA E. CADY


McLEAN, SUSAN G.

HOLMES, SUSAN L. TODD W.

STATE OF VERMONT

STATE OF VERMONT

FOR DRAINAGE DETAILS SEE ROW SHEET 4 OF 8

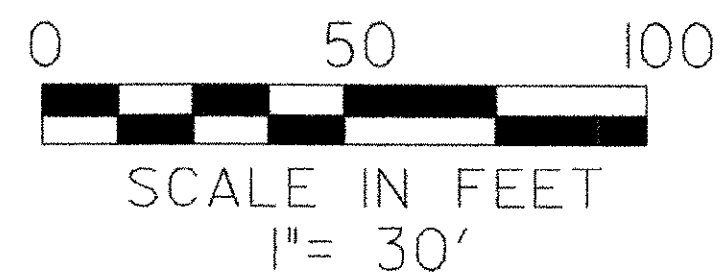

PROJECT NAME:	HARDWICK	FILE NAME:	d04e06bdr.dgn	PLOT DATE:	05-OCT-2005
PROJECT NUMBER:	STP ST 030-3(4)	PROJECT LEADER:	A. BOMBARDIER	DRAWN BY:	M. NUTTER
		DESIGNED BY:	M. NUTTER	CHECKED BY:	A. BOMBARDIER
		ROW SHEET 7 OF 8 SHEETS			SHEET 10 OF 63

