

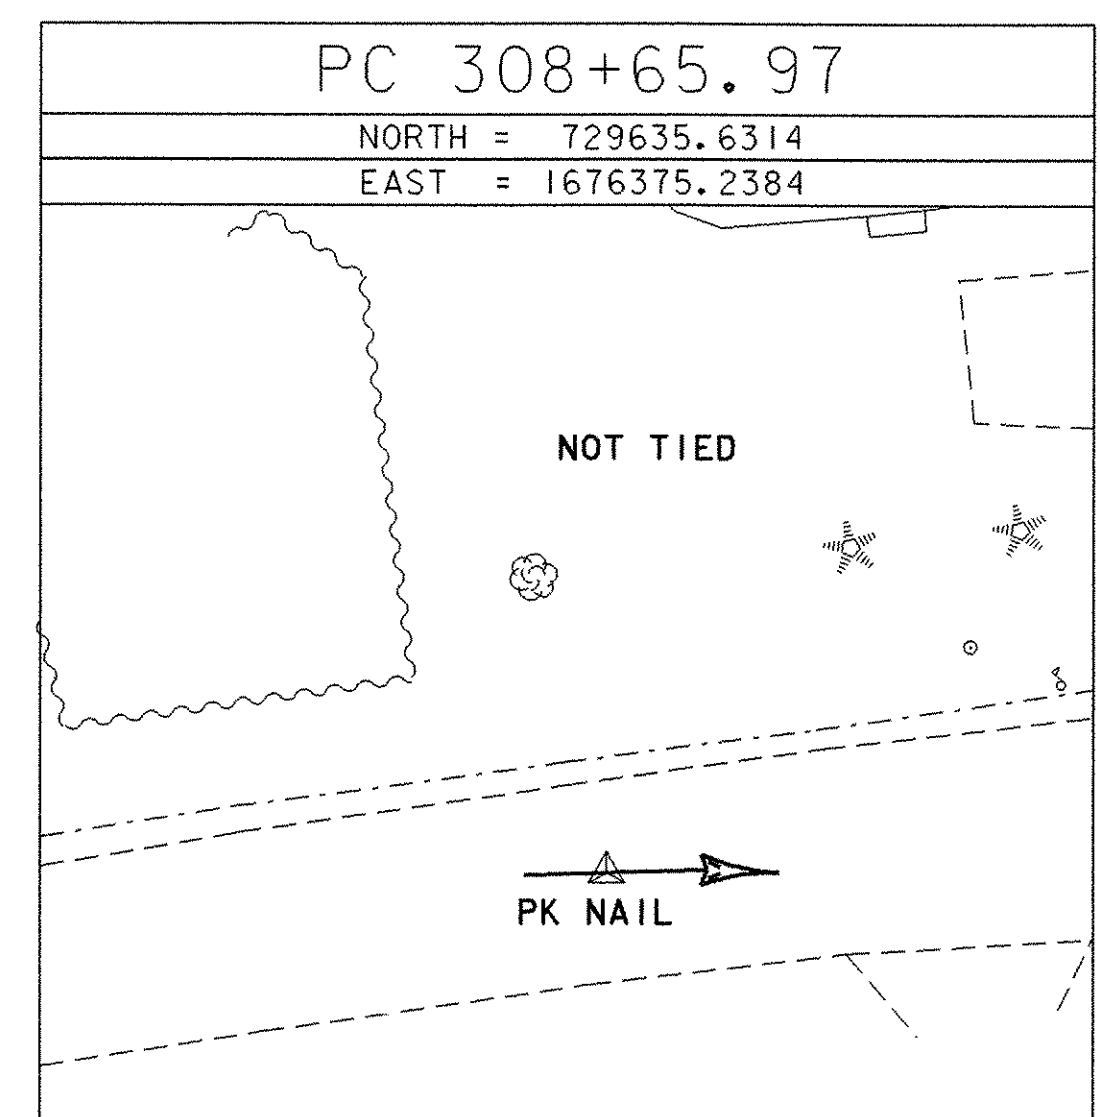
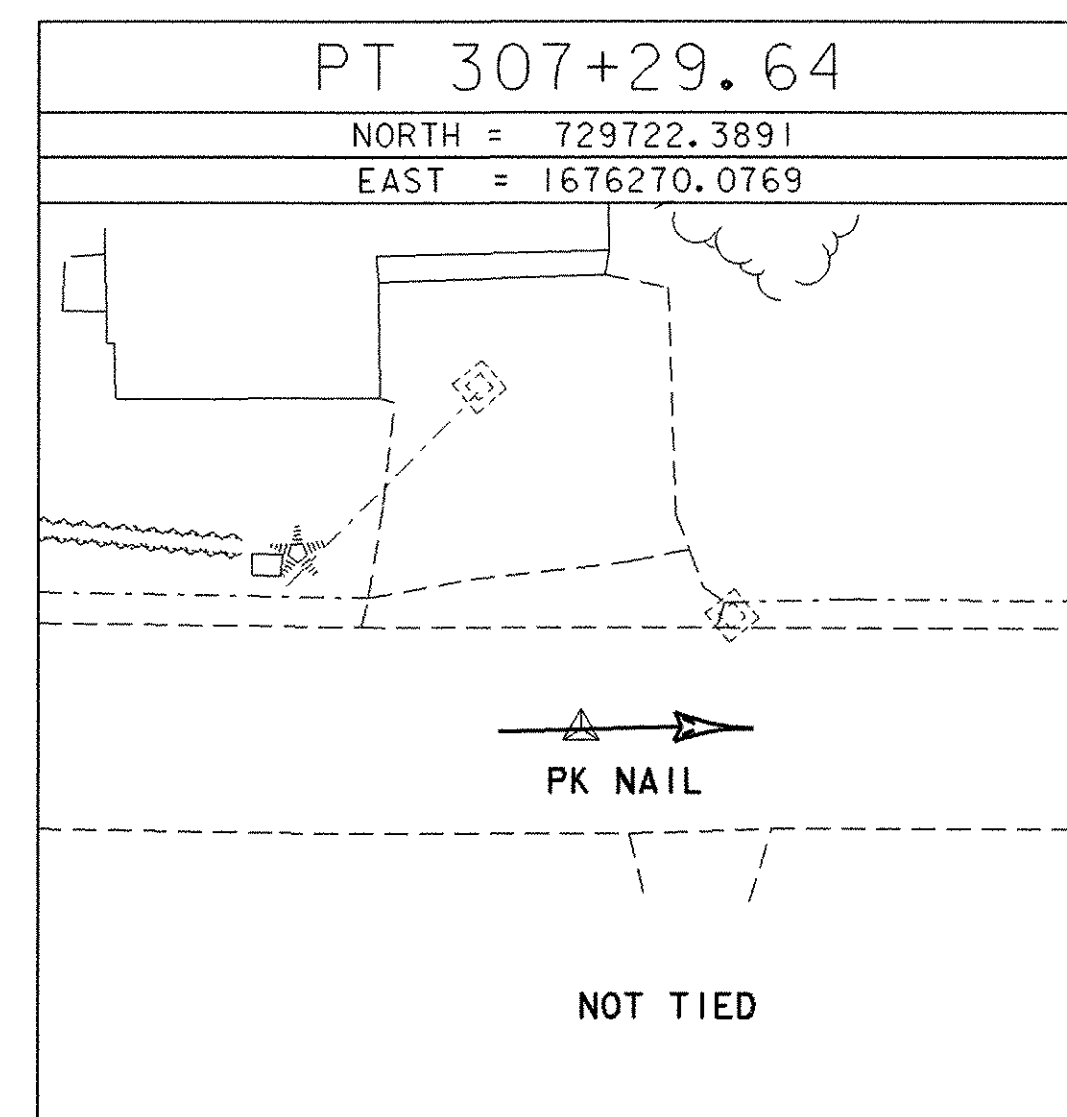
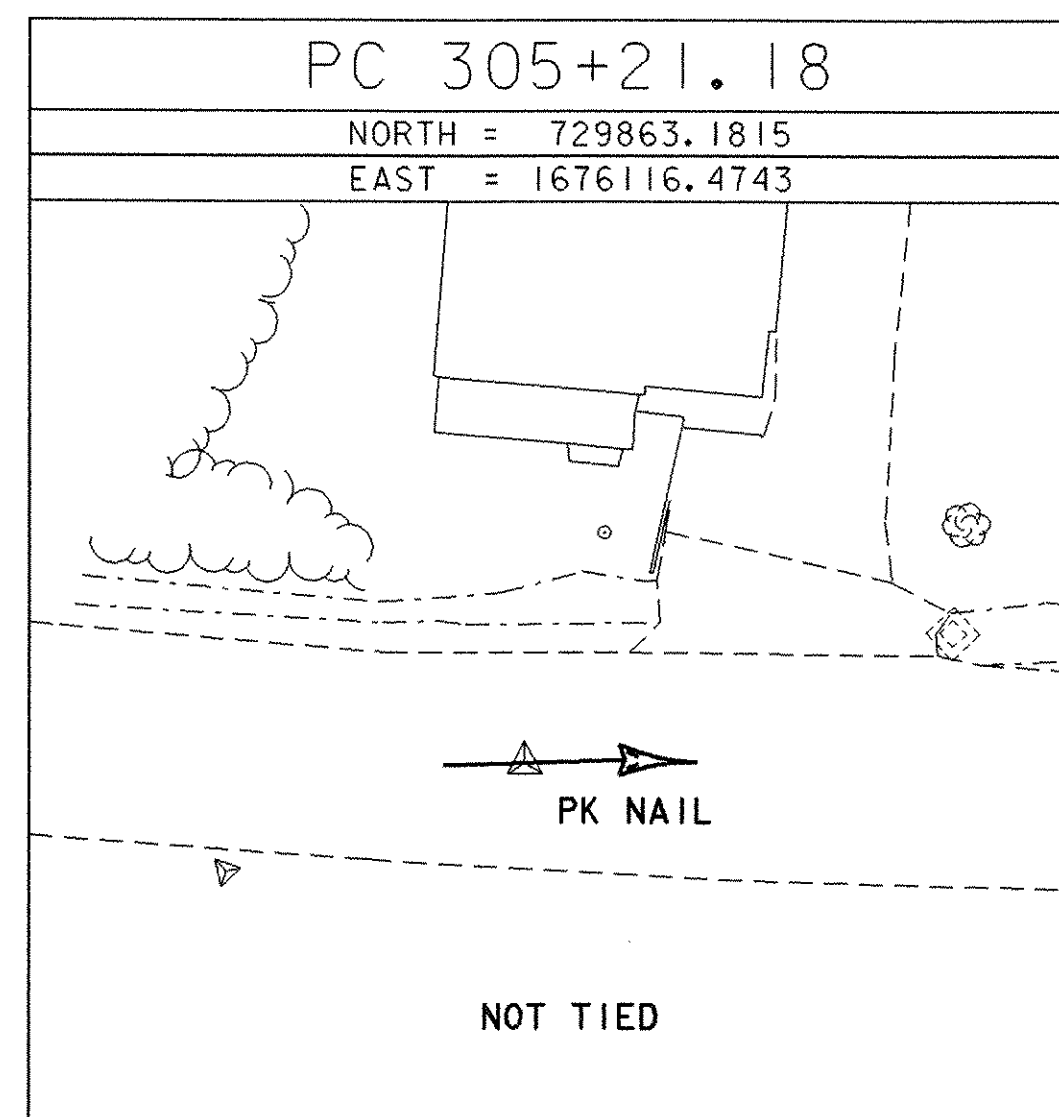
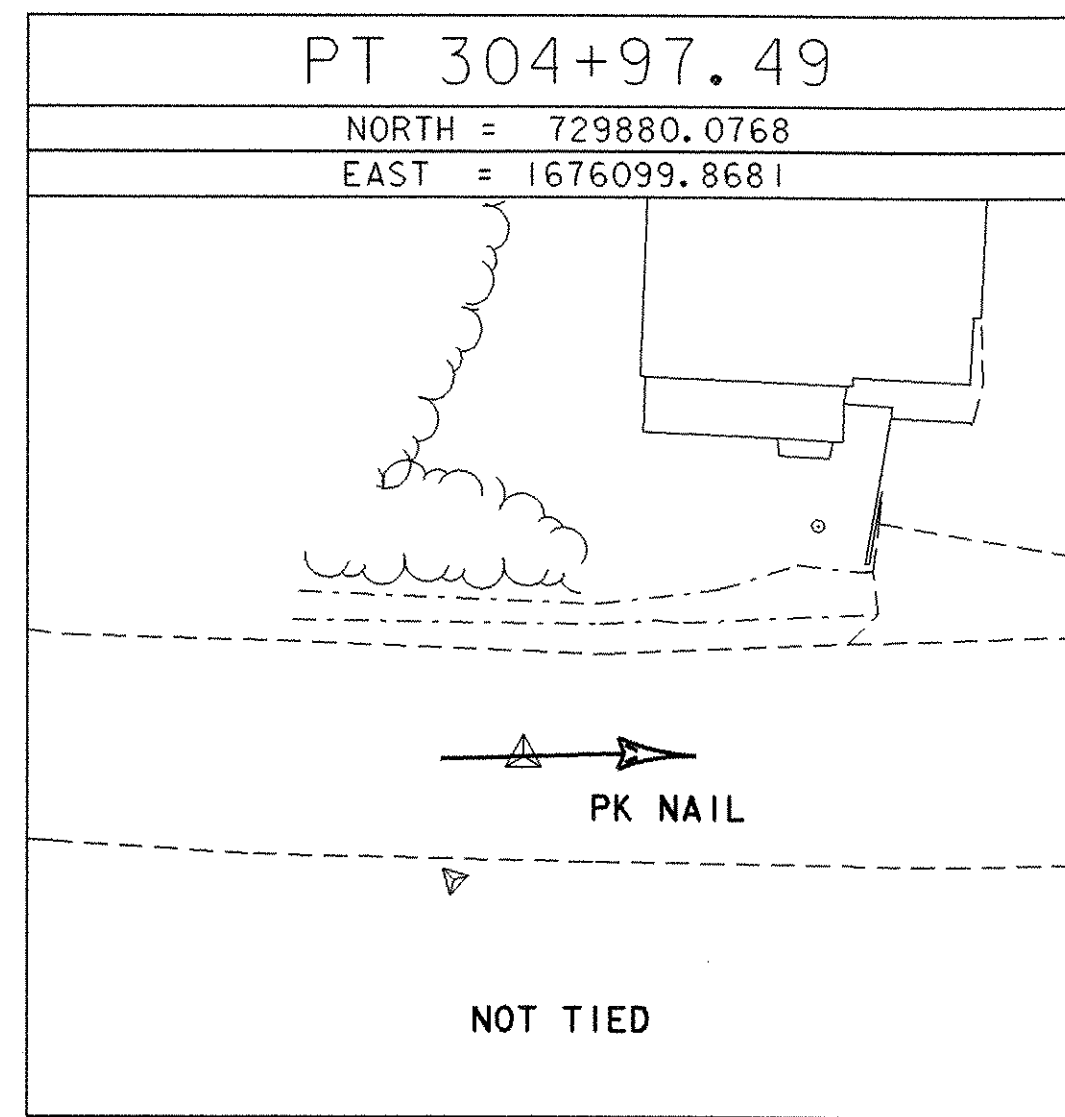
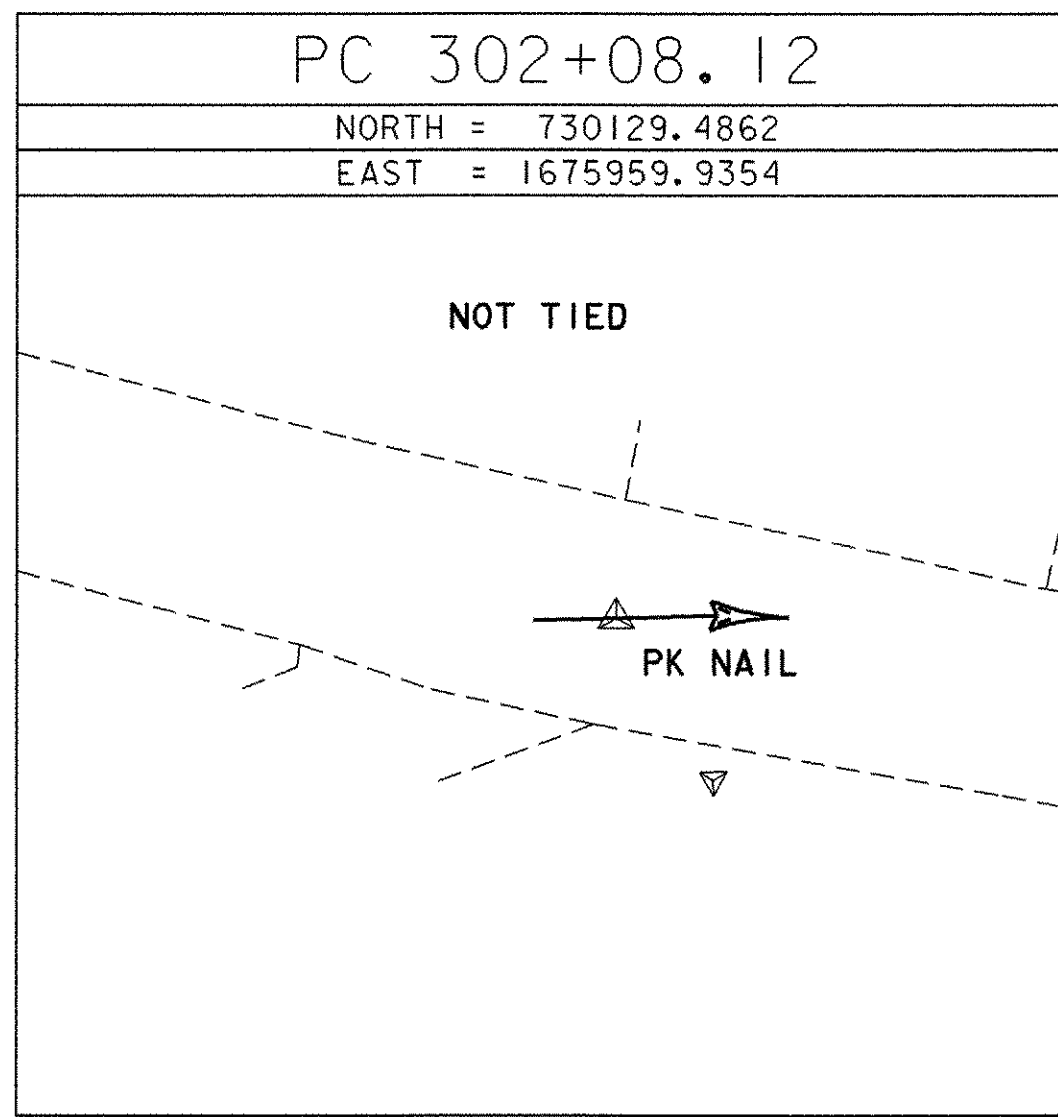
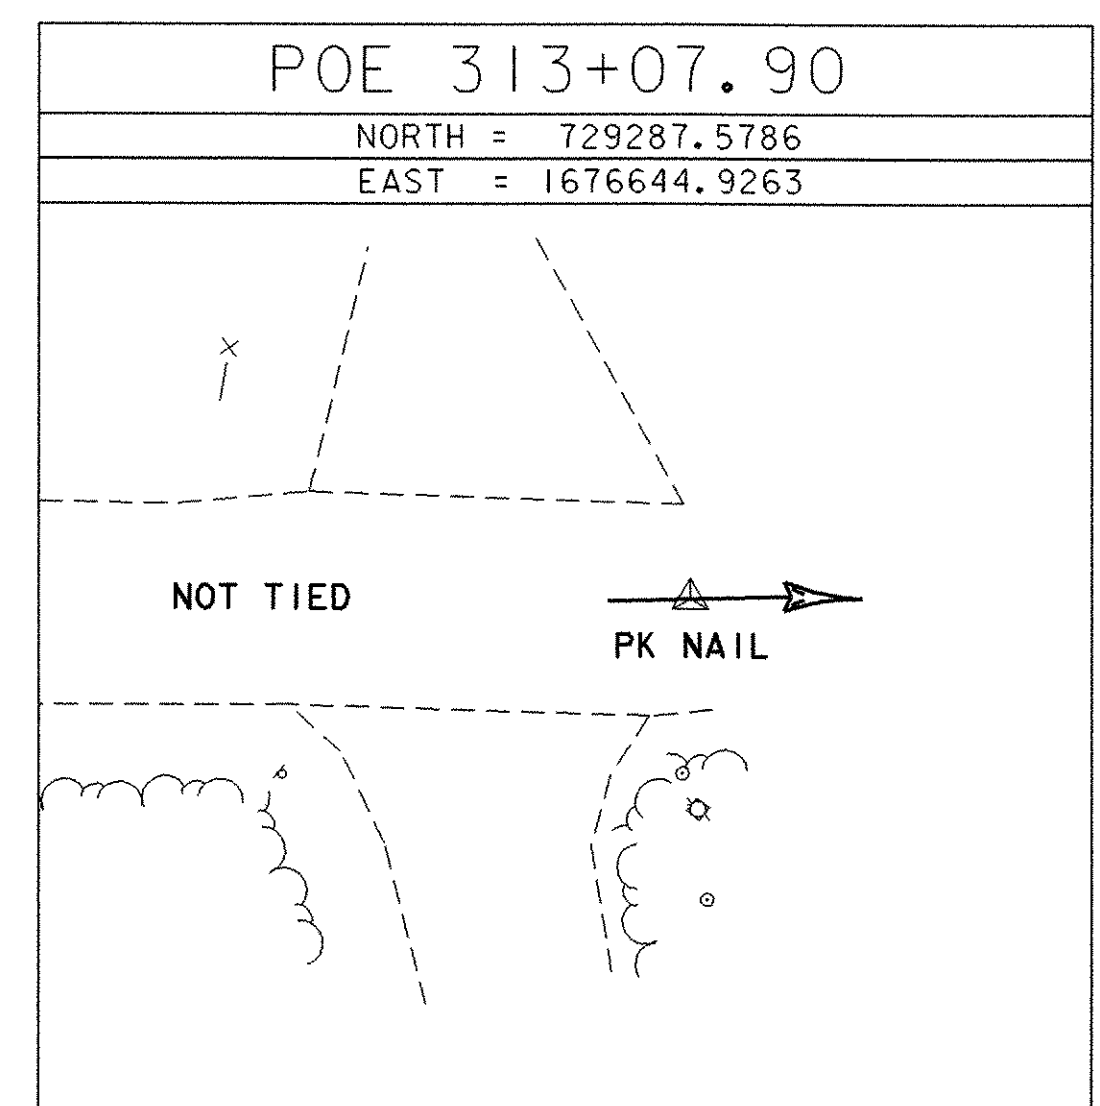
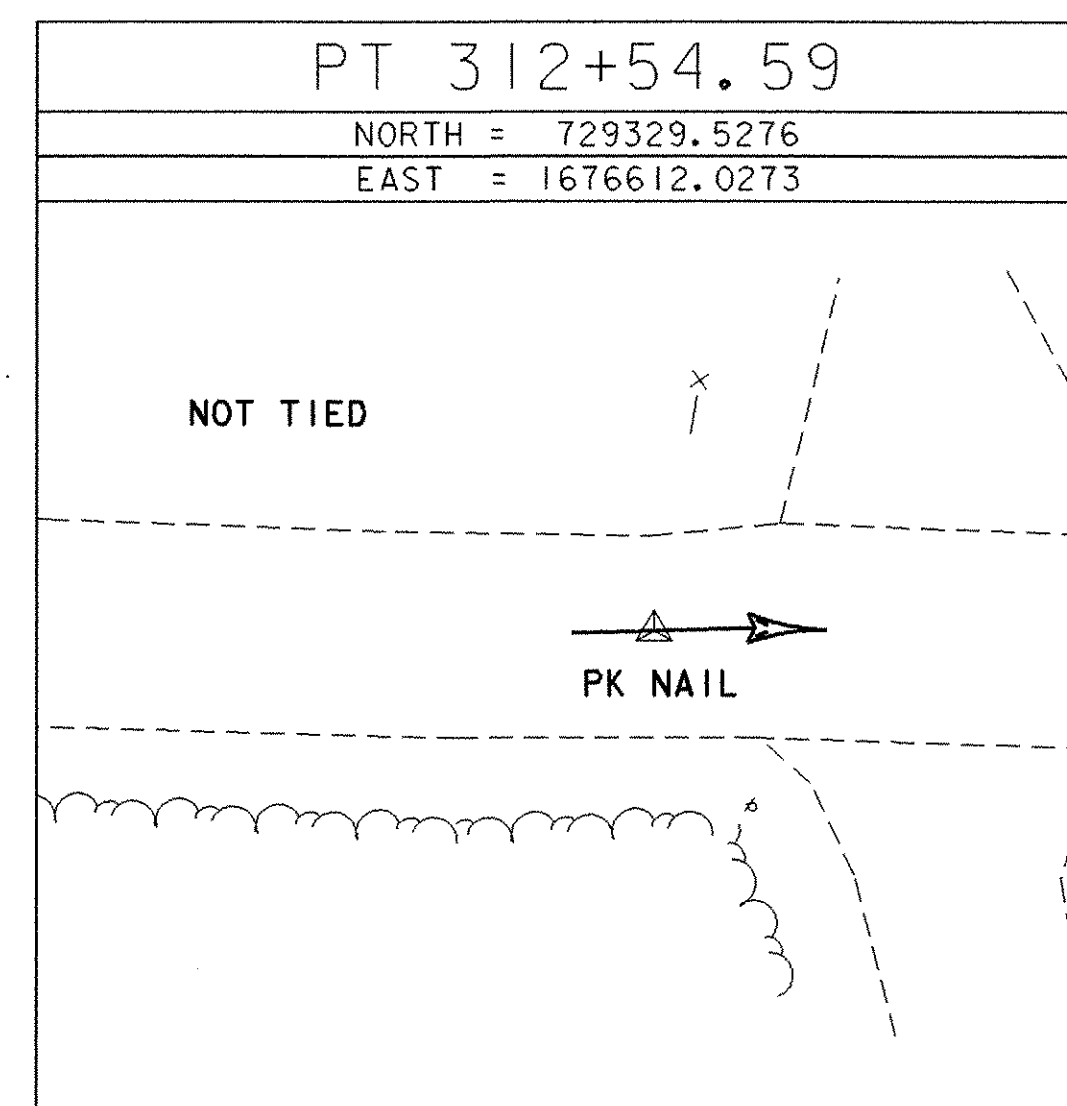
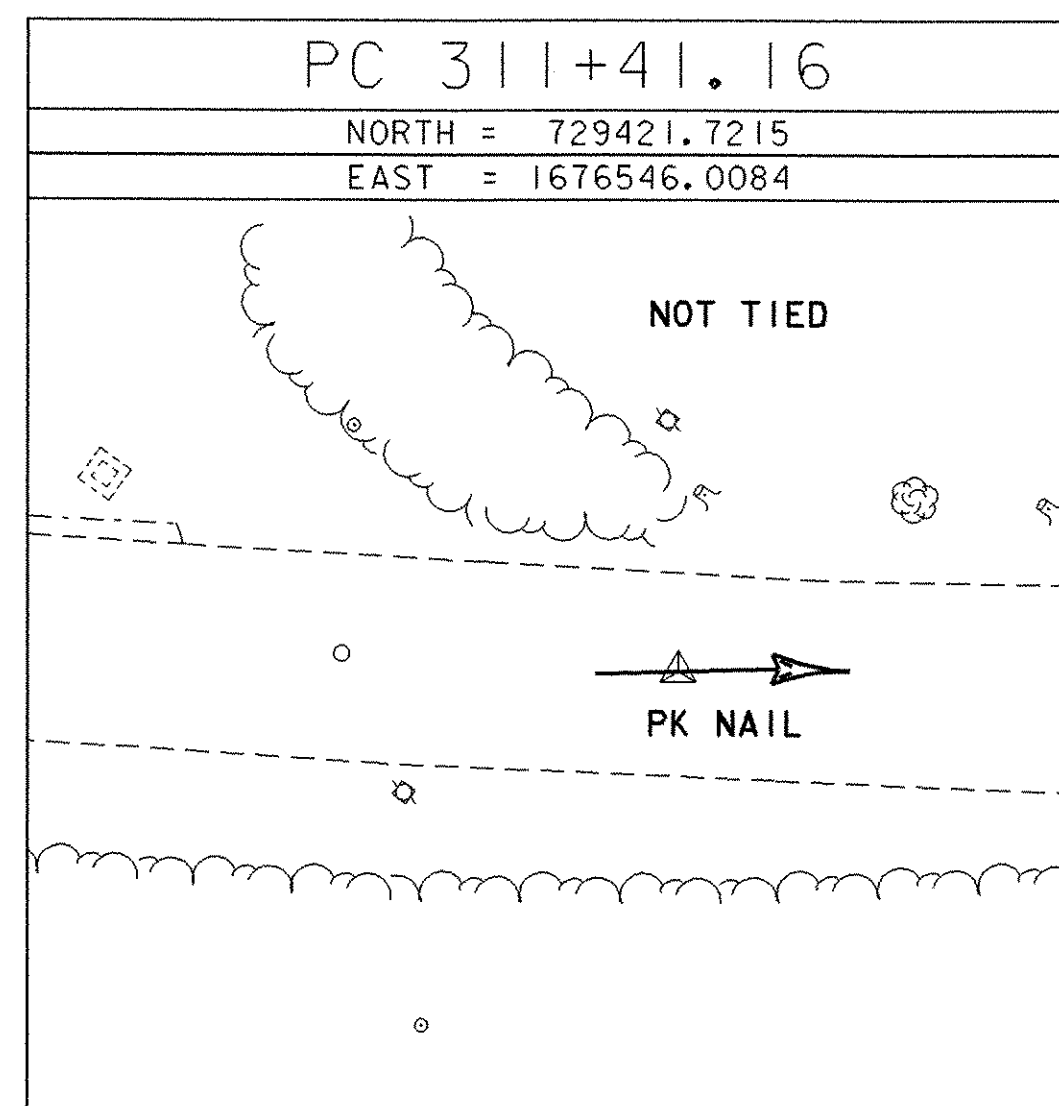







ALIGNMENT TIES

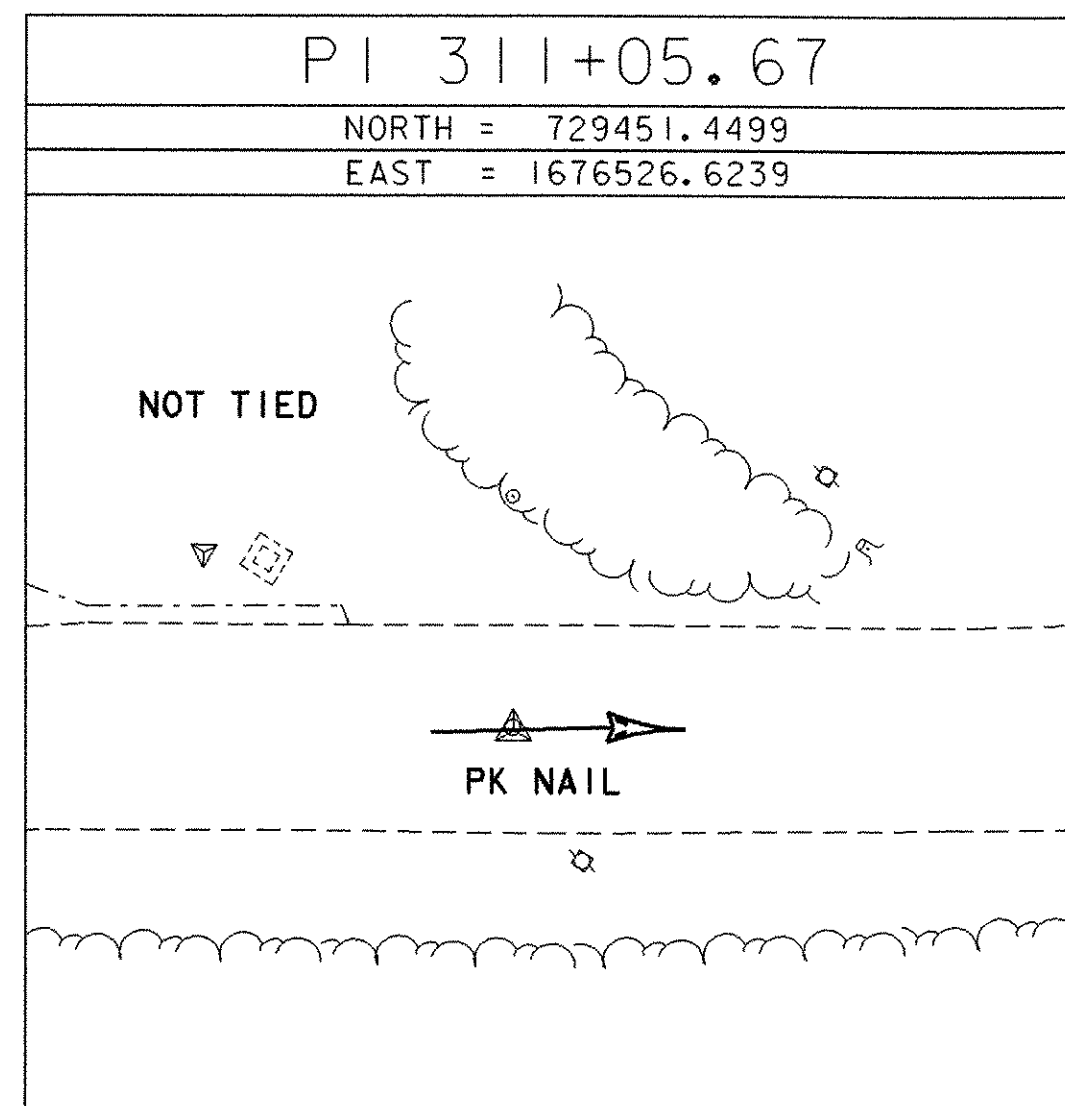

ALIGNMENT TIES

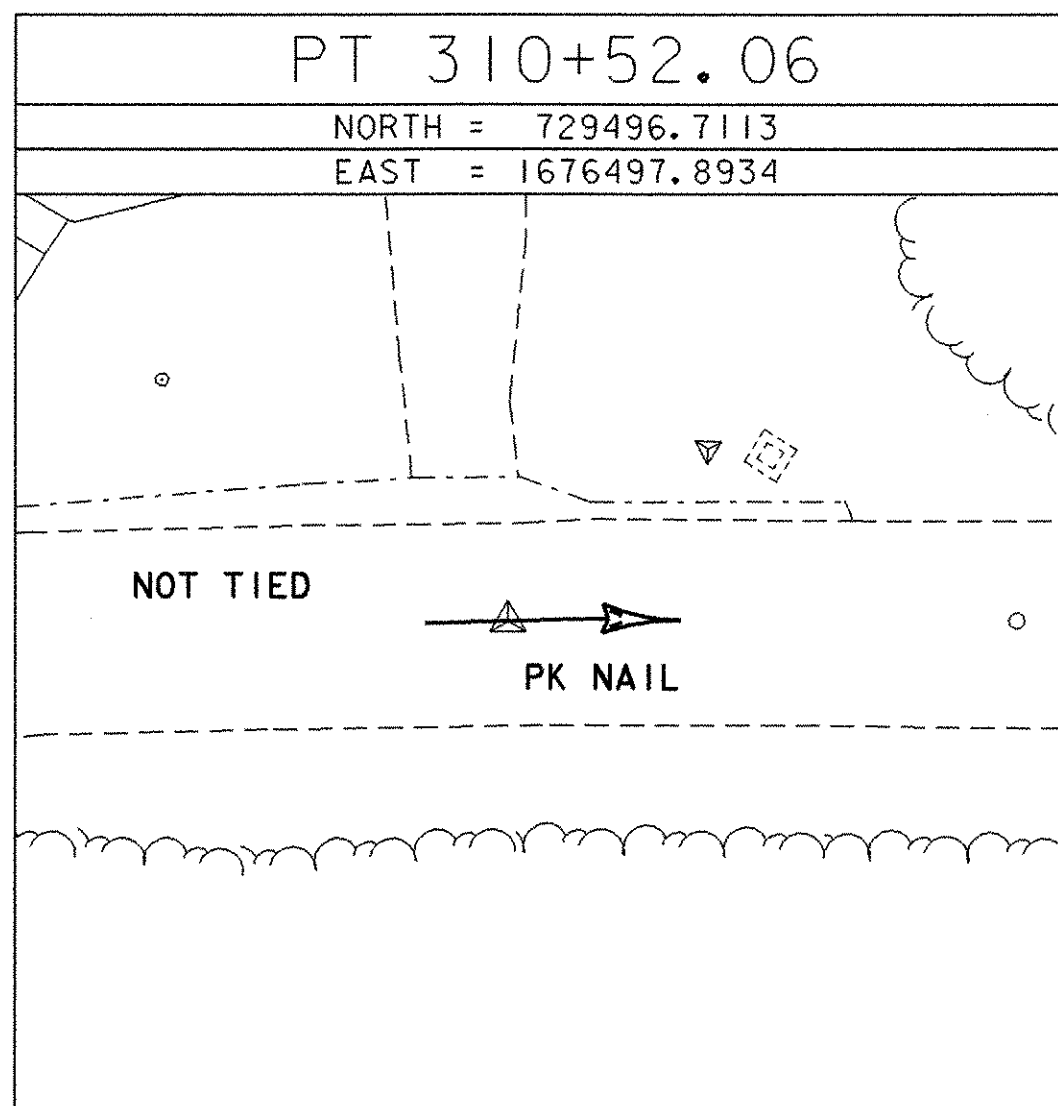

ALIGNMENT TIES

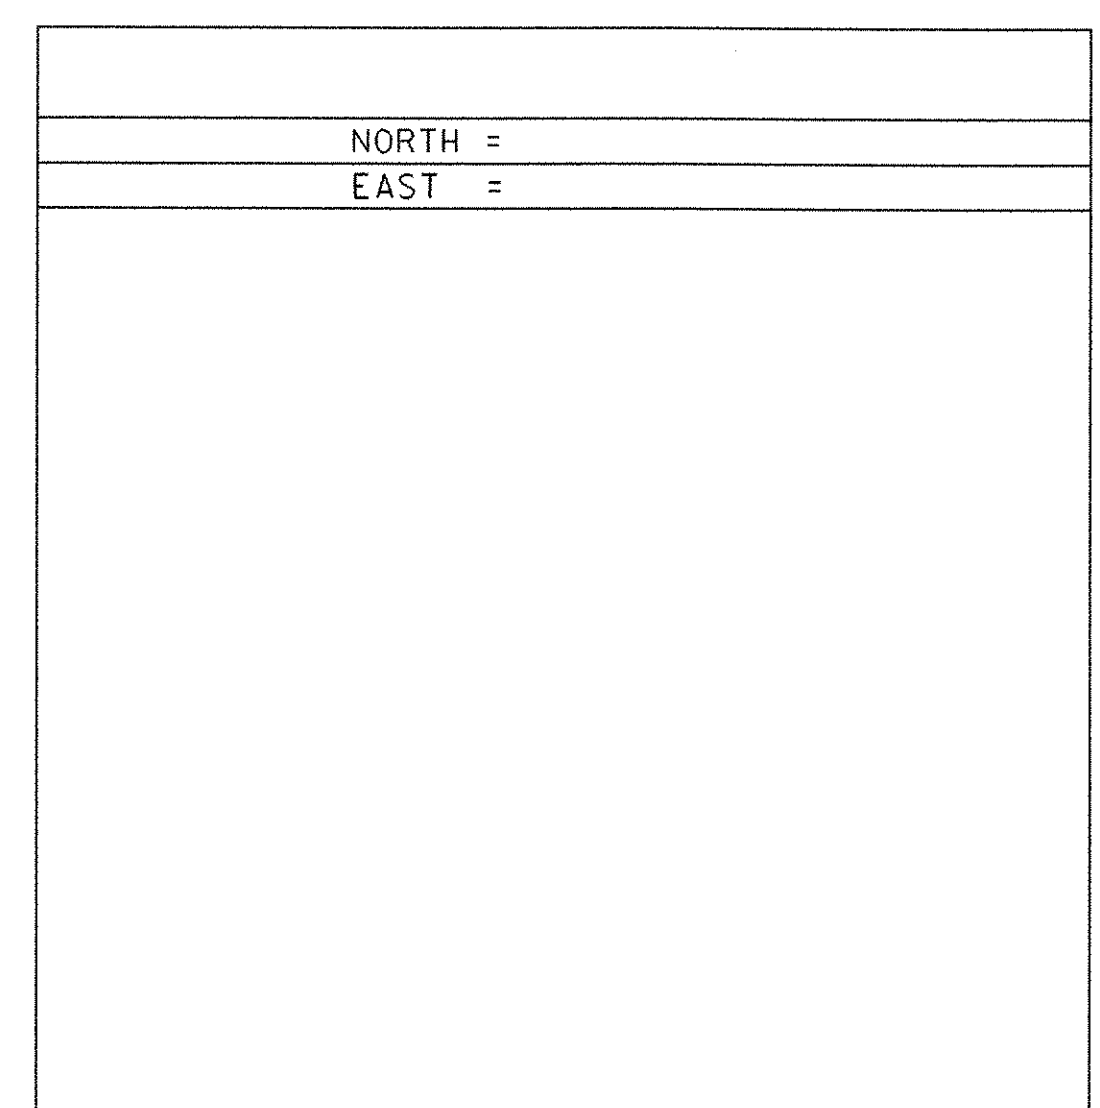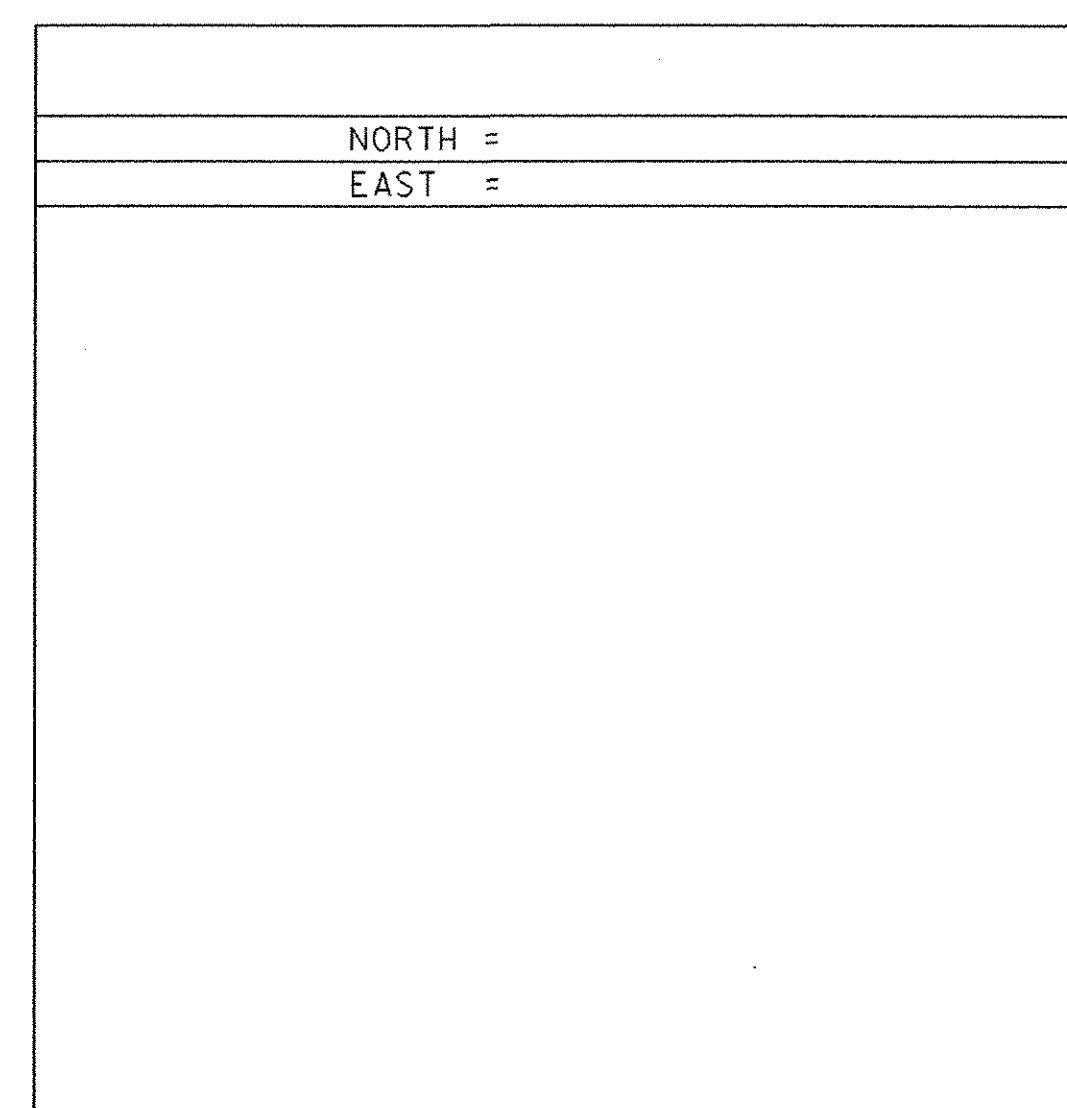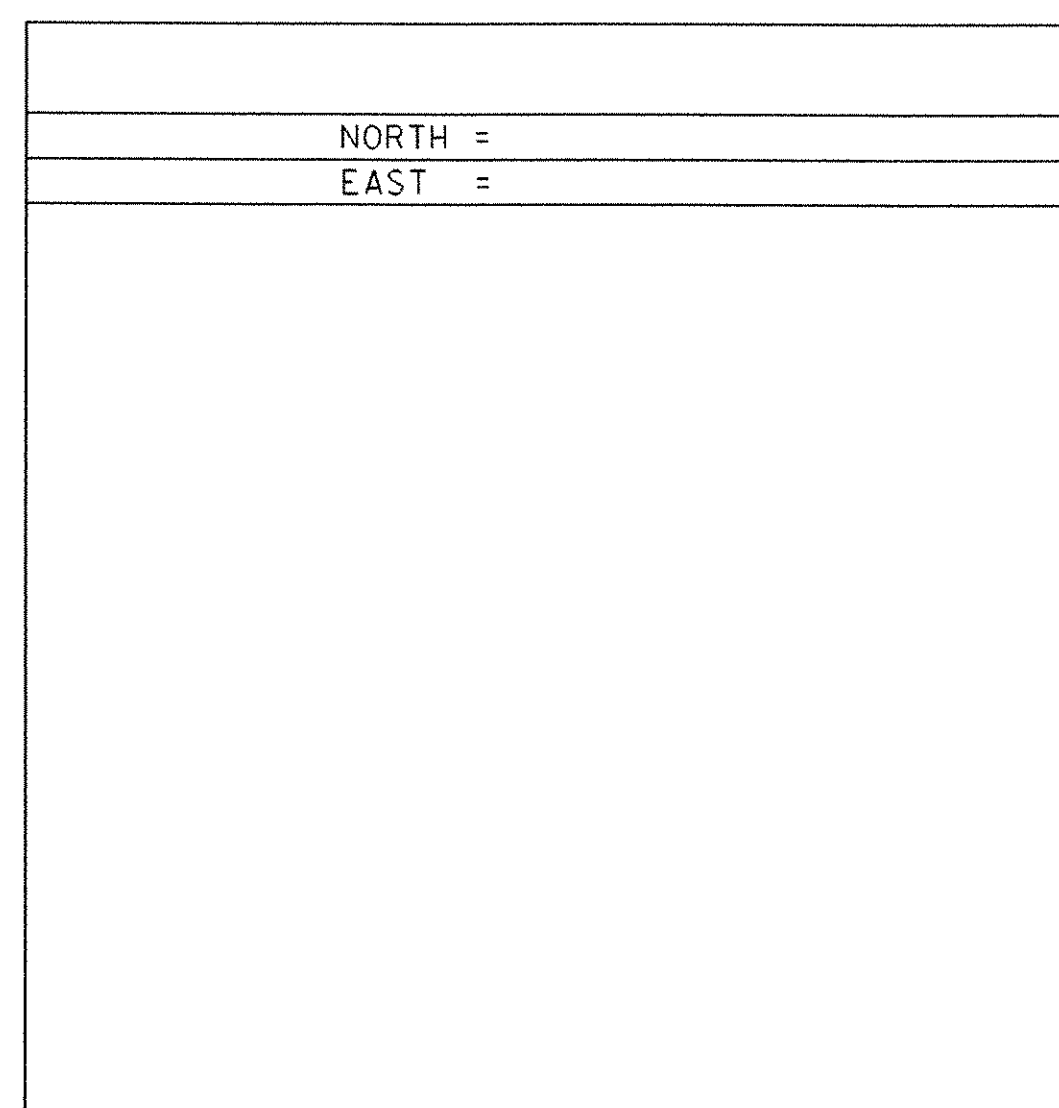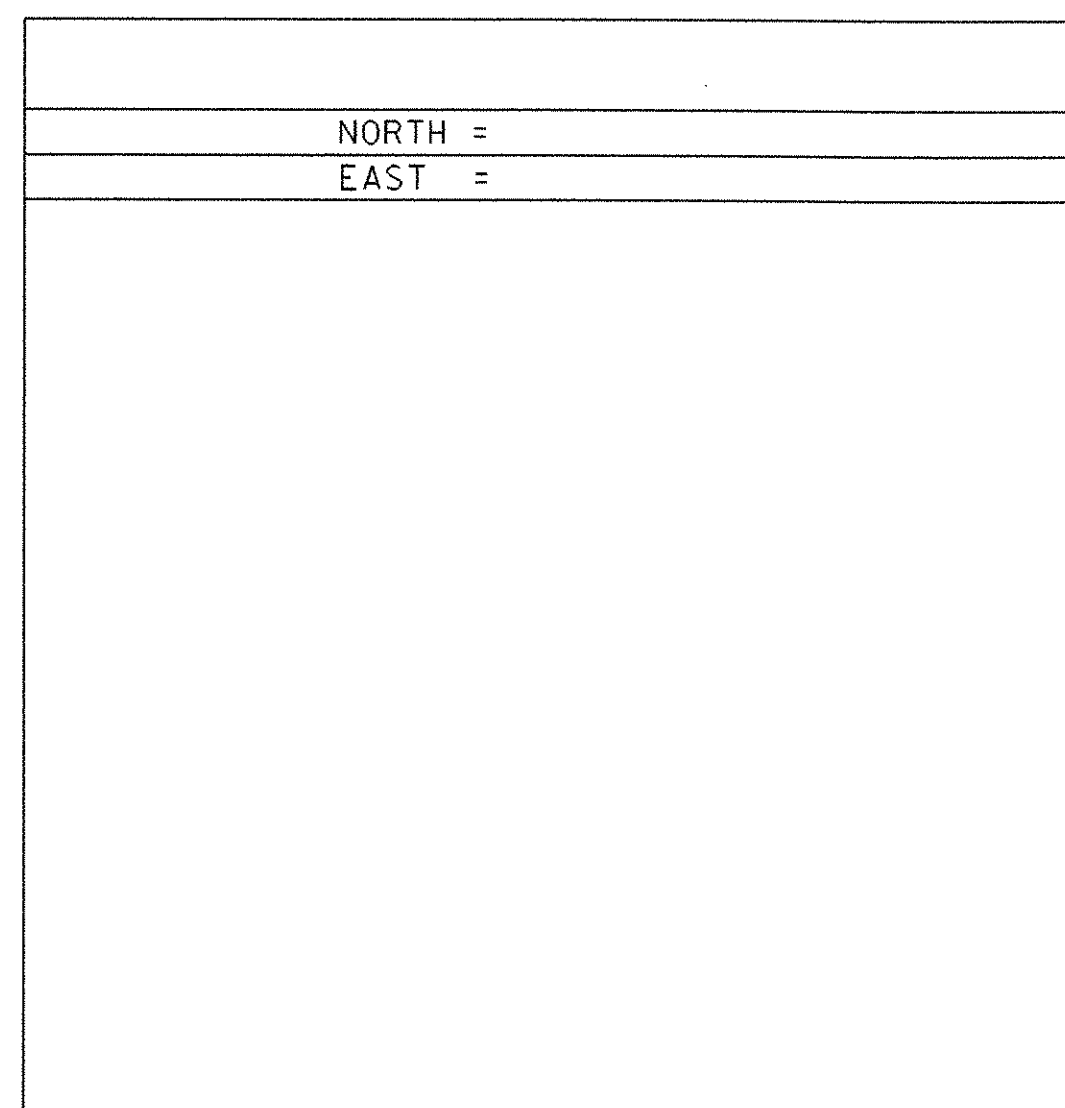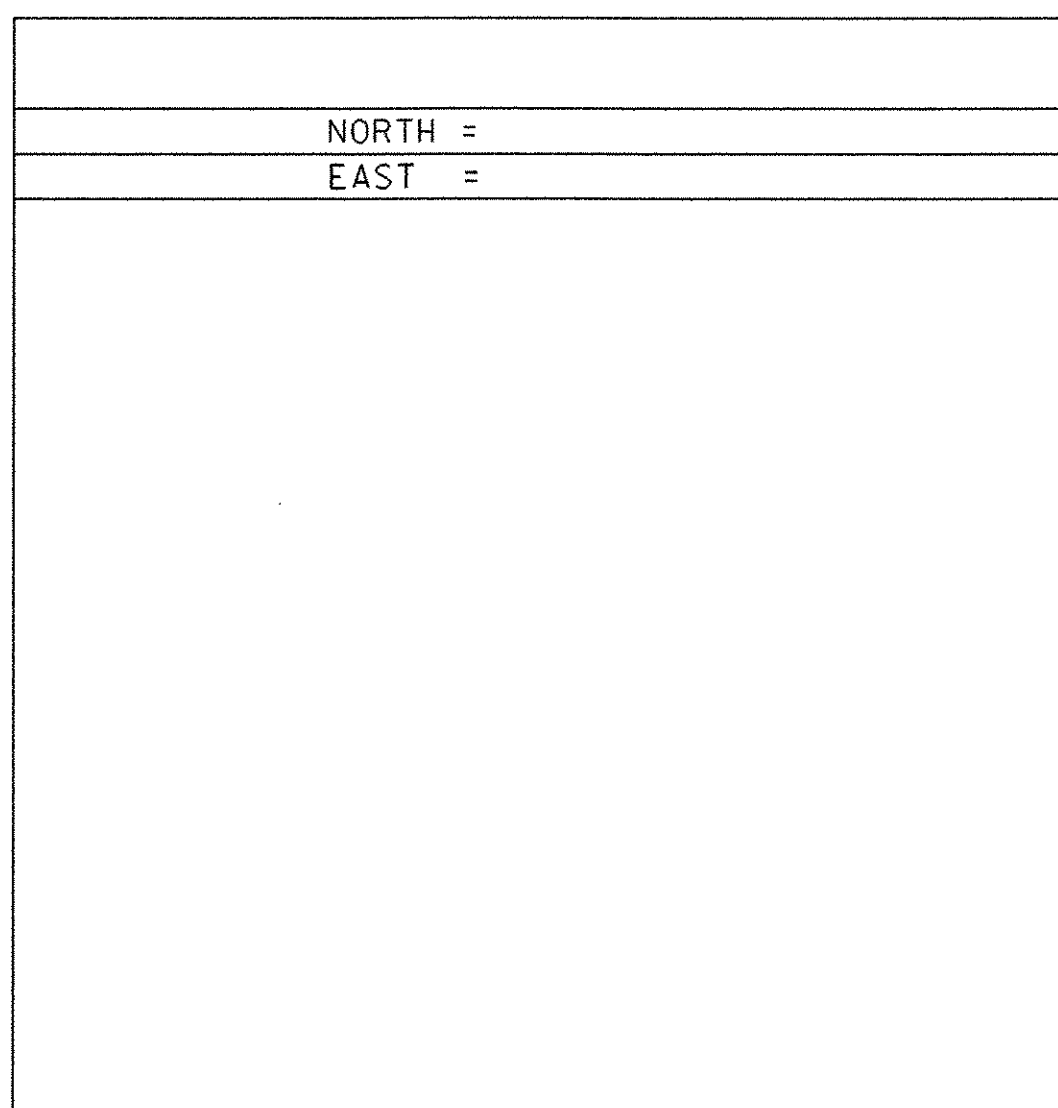

DATUM
 VERTICAL NAVD 88
 HORIZONTAL NAD 83(96)
 ADJUSTMENT COMPASS

PROJECT NAME: HARDWICK
 PROJECT NUMBER: STP ST 030-3(4)
 FILE NAME: x04e060t1.dgn PLOT DATE: 18-OCT-2005
 PROJECT LEADER: J.HULETT DRAWN BY: J.HULETT
 DESIGNED BY: P.BEYOR CHECKED BY: P.BEYOR
 SHEET 13 OF 63