
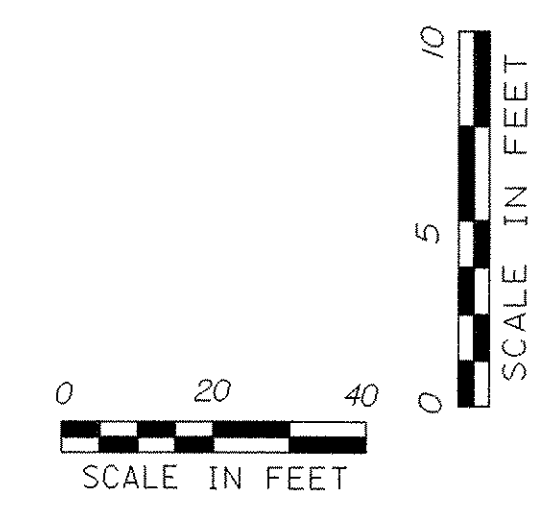


MAIN LINE PROFILE

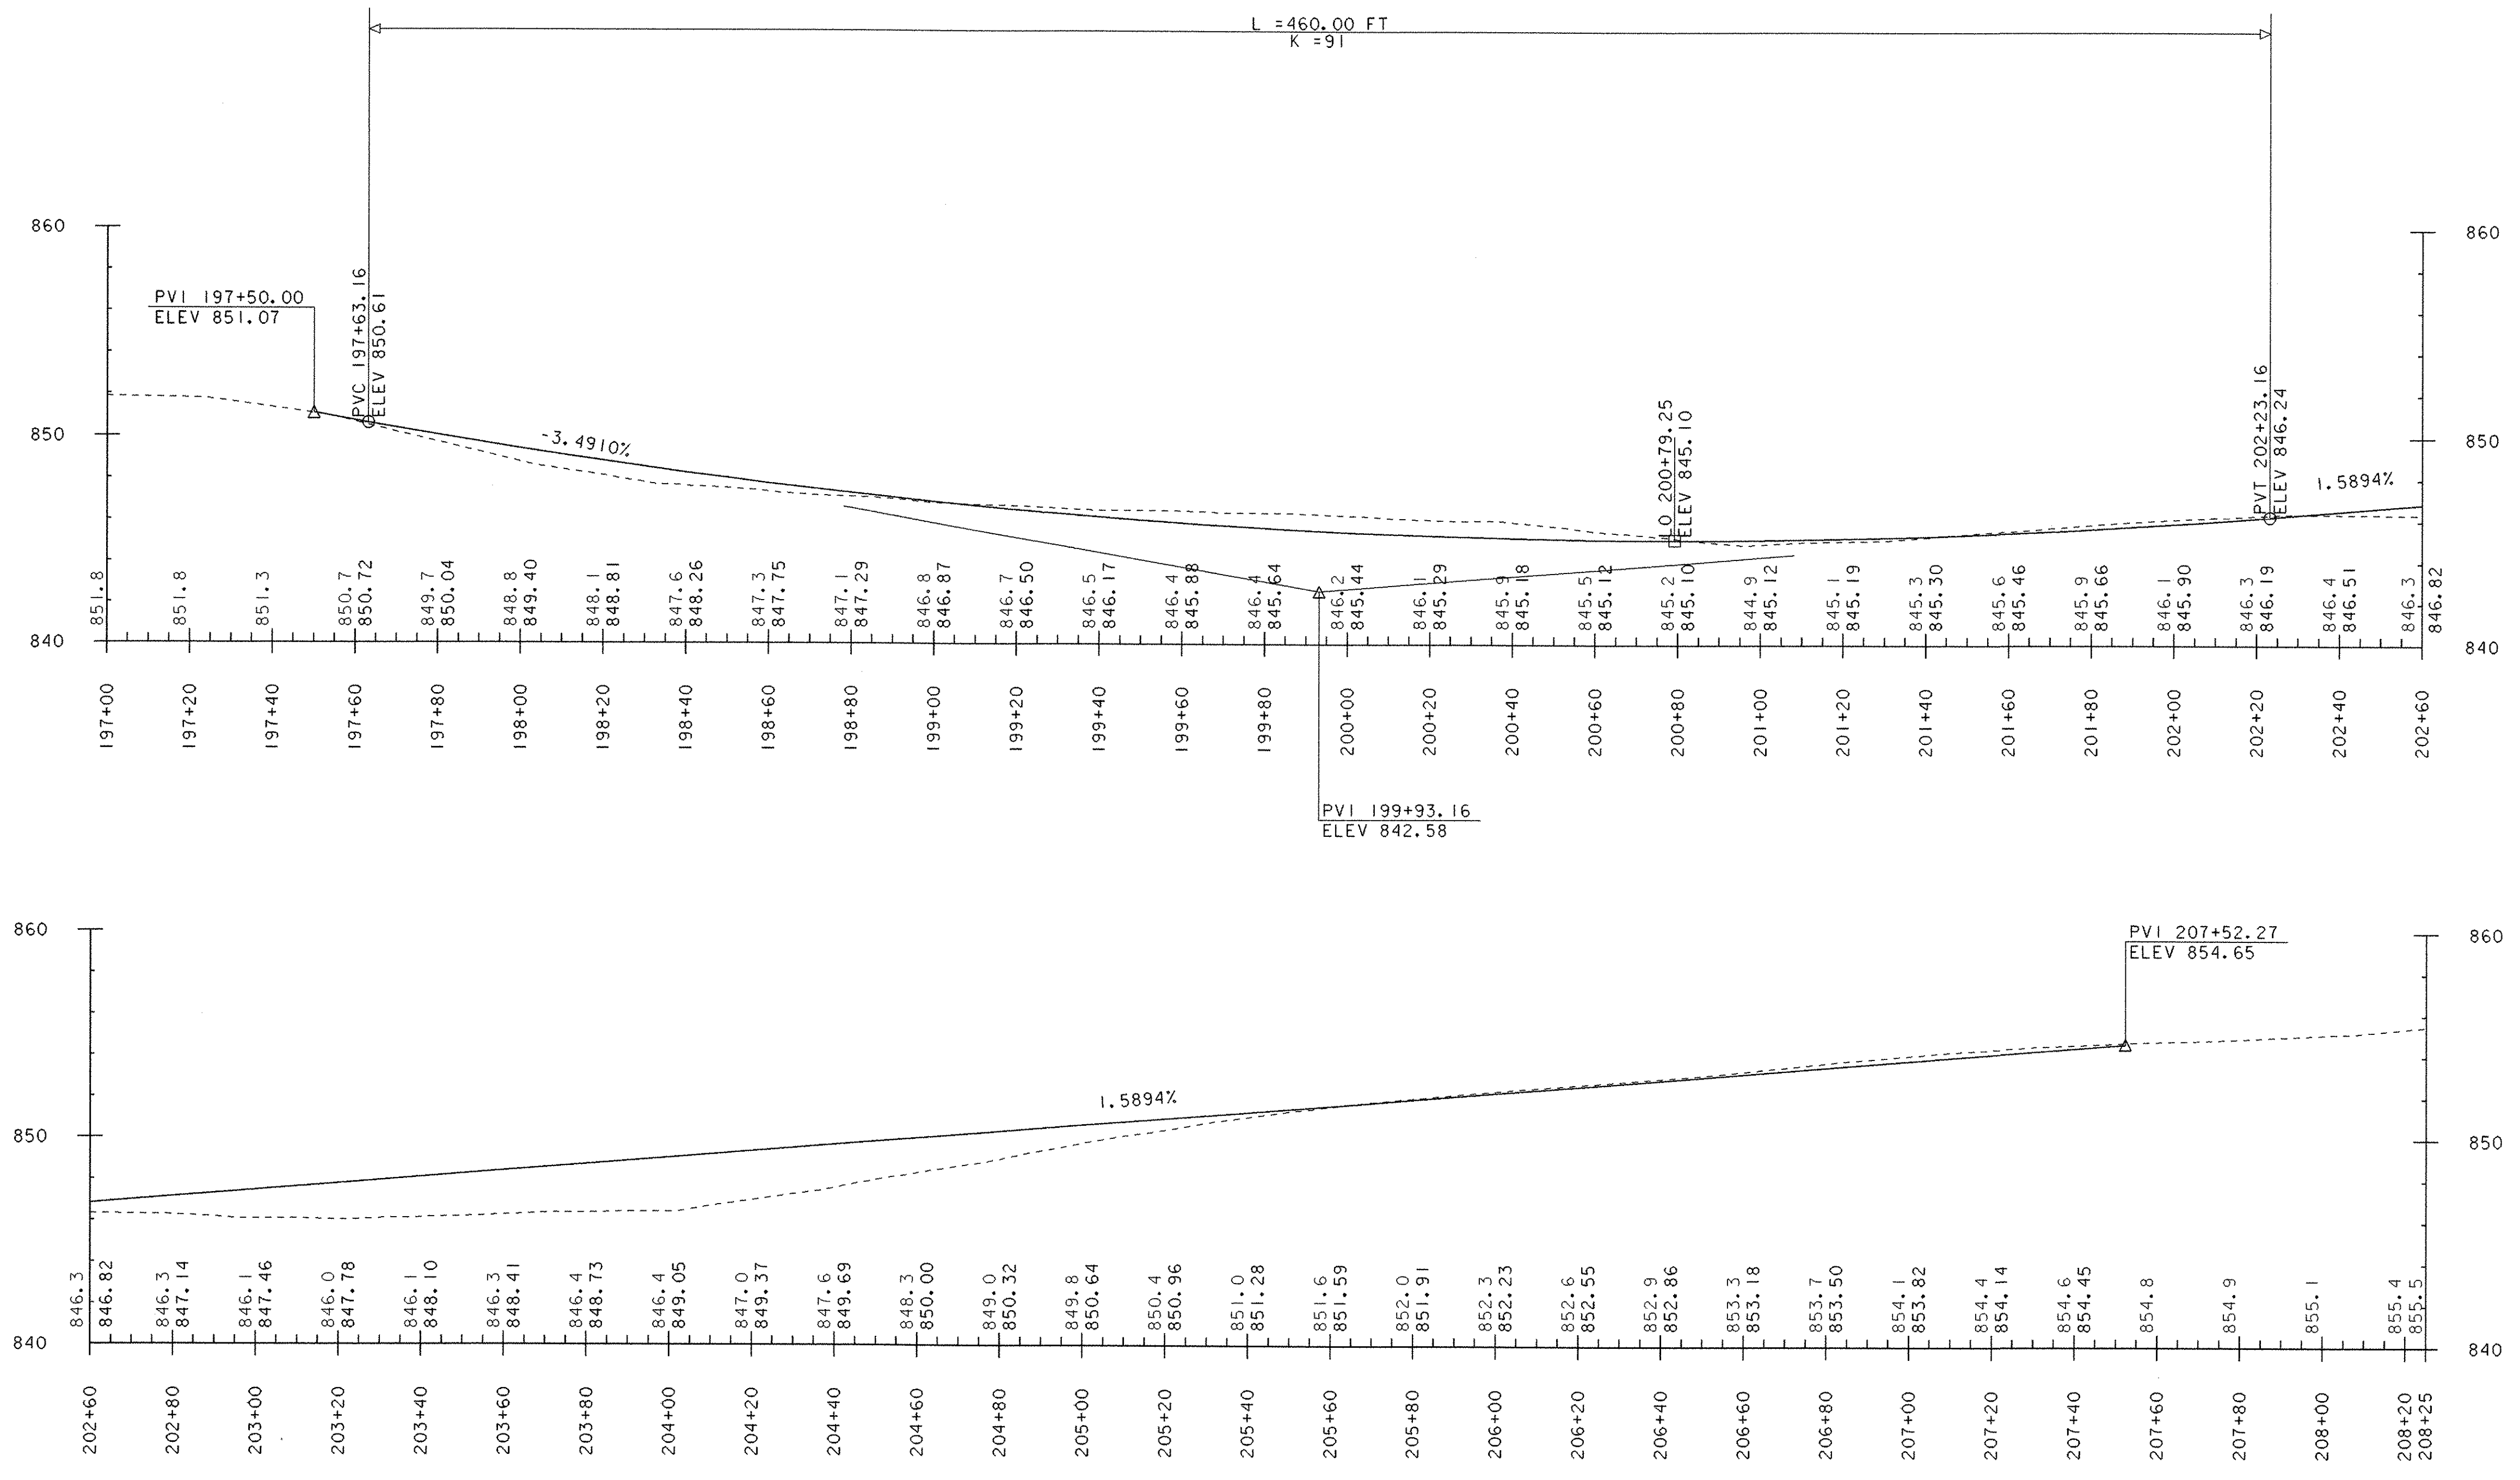

PROJECT NAME: HARDWICK	PLOT DATE: 18-OCT-2005
PROJECT NUMBER: STP ST 030-3(4)	DRAWN BY: M. NUTTER
FILE NAME: d04e060xslx.dgn	CHECKED BY: A. BOMBARDIER
DESIGNED BY: M. NUTTER	SHEET 15 OF 63
IPARM NAME: de060pr001	