


MATERIAL TRANSITION DETAIL

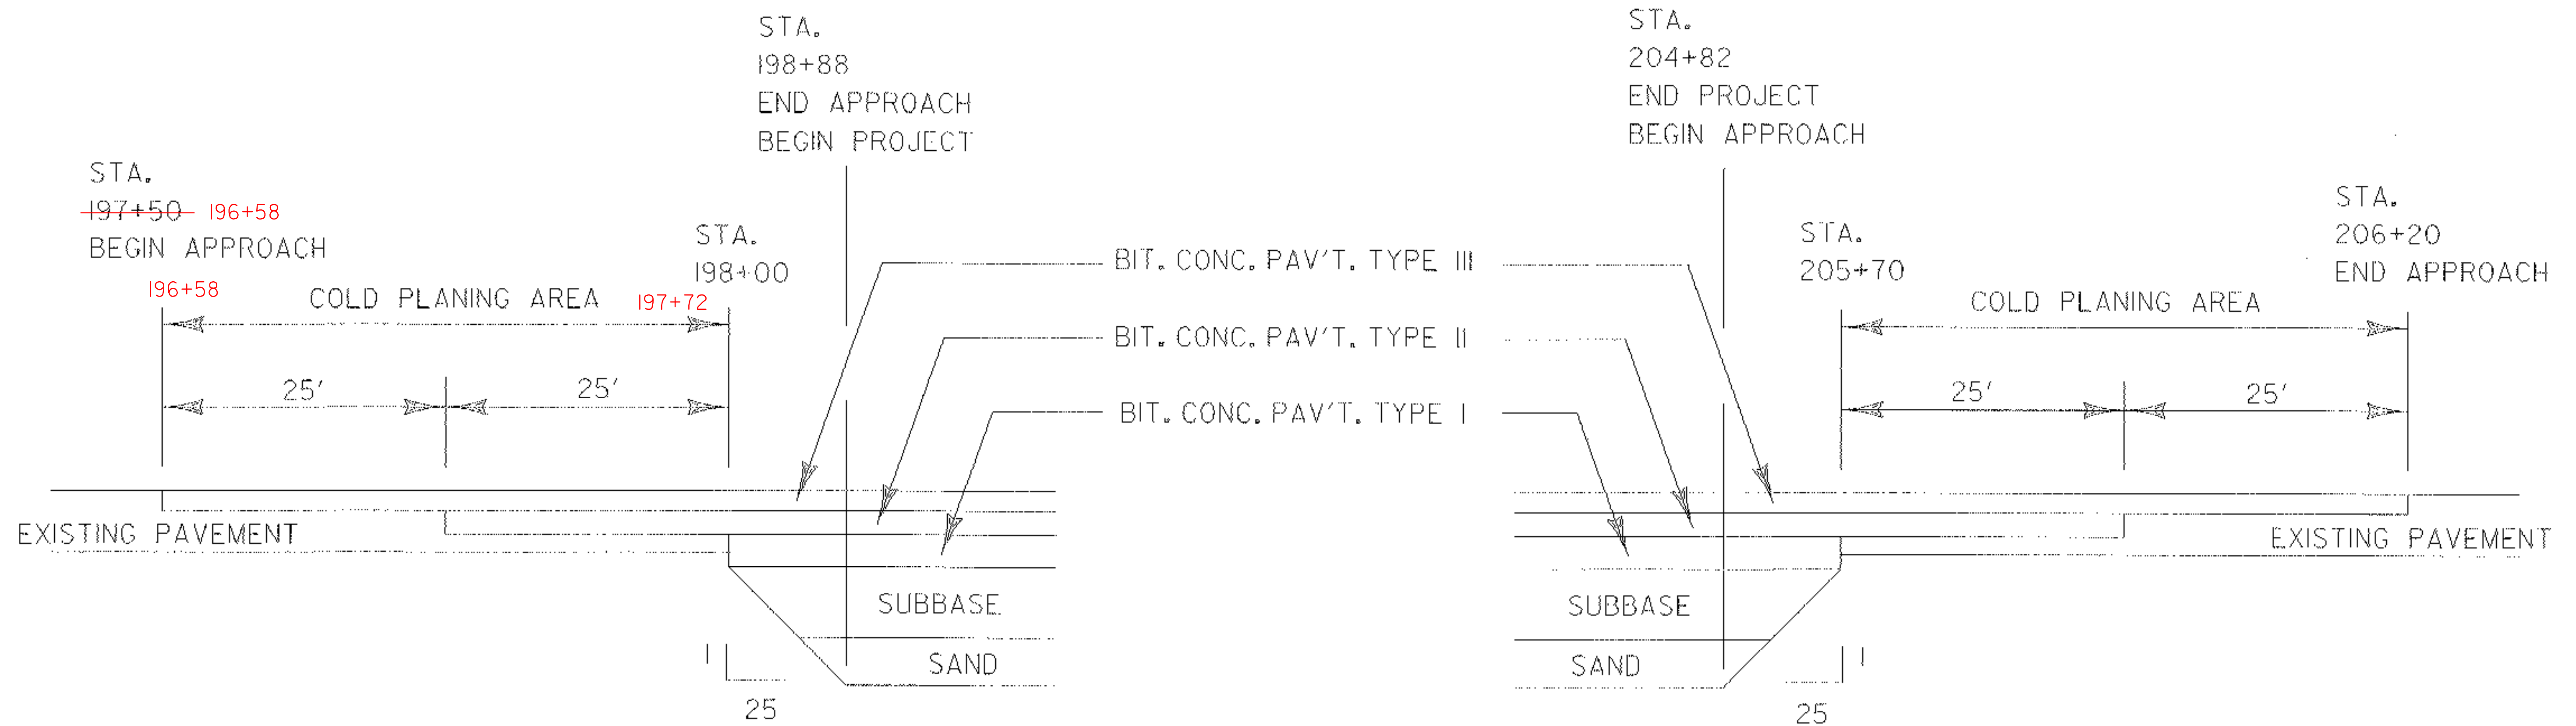

N.T.S.

PROJECT NAME: HARDWICK	
PROJECT NUMBER: STP ST 030-3(4)	
FILE NAME: d04e060frim.dgn	PLOT DATE: 18-OCT-2005
PROJECT LEADER: A. BOMBARDIER	DRAWN BY: M. NUTTER
DESIGNED BY: M. NUTTER	CHECKED BY: A. BOMBARDIER
IPARM NAME: d04e060mts.d	SHEET 17 OF 63