



SL306+41.43 LT65.84  
 REMOVE L.PINE  
 PLANT NEW SUGAR MAPLE  
 2-2 1/2" CALIPER

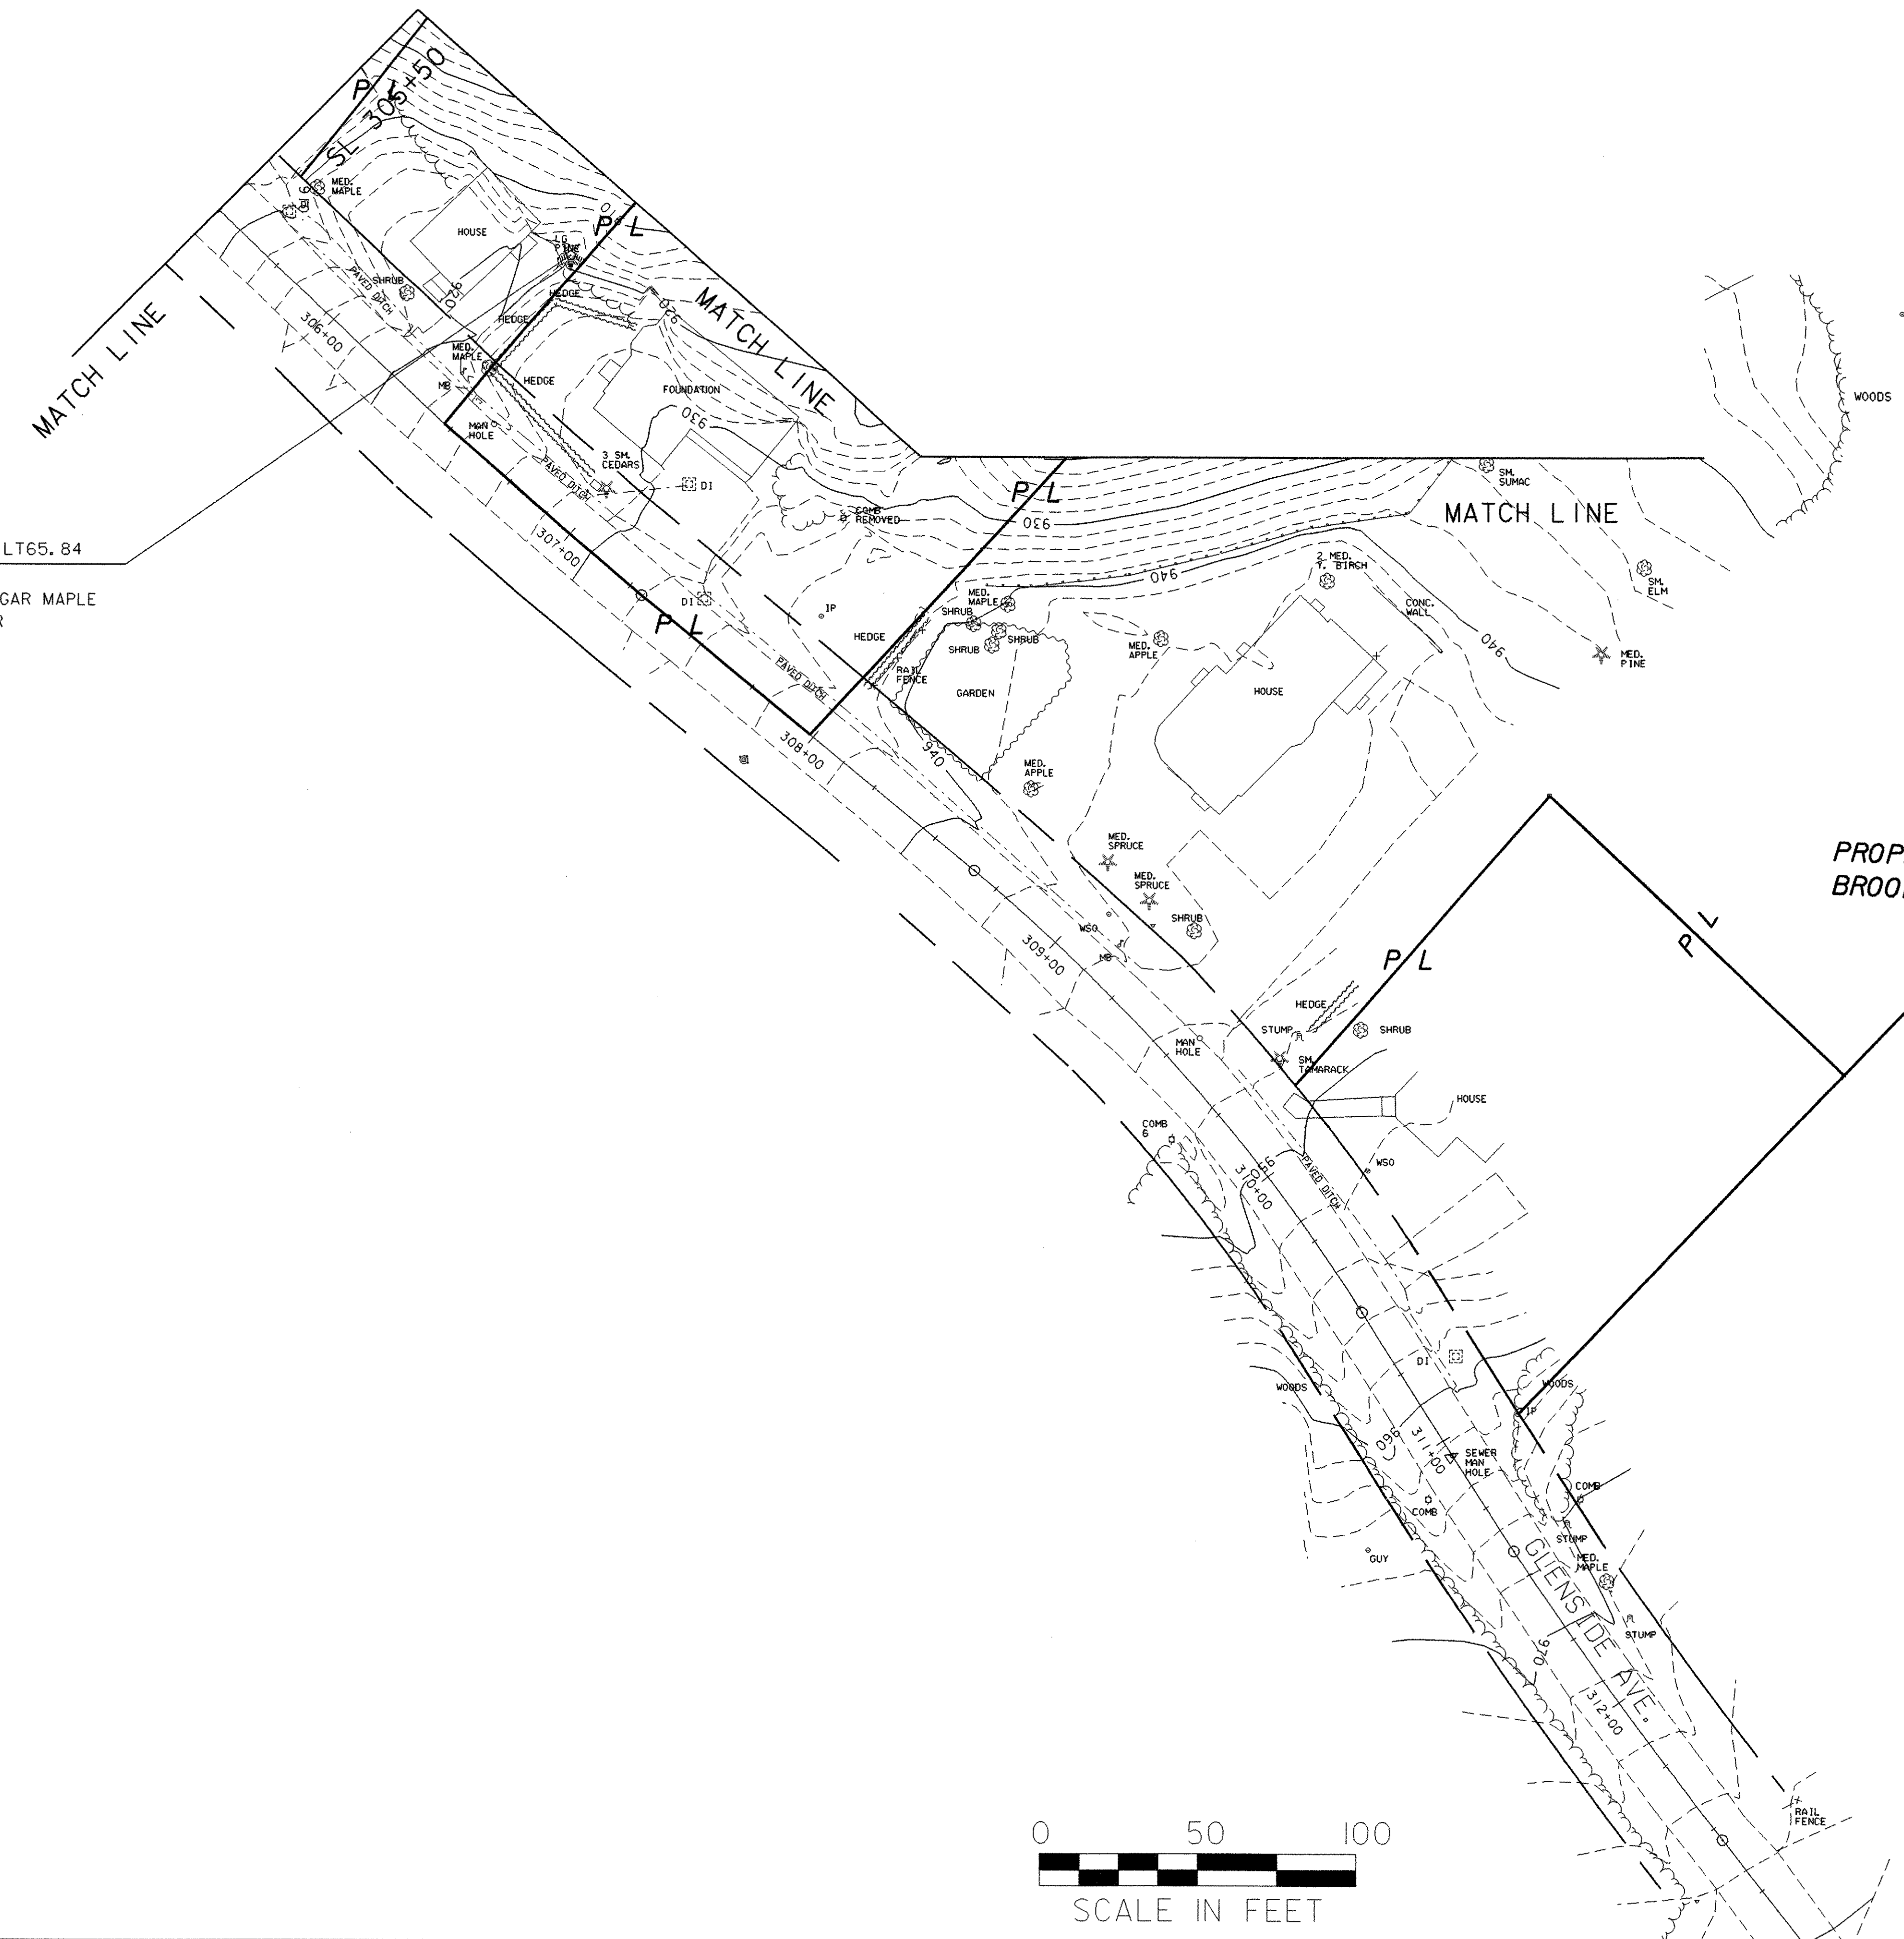

PROPERTY LINE FOLLOWS  
 BROOK TO HIGHWAY

- NOTES:
1. ALL INLETS ARE TO BE PROTECTED, SEE SHEET 25.
  2. CONSTRUCTION ENTRANCE TO BE DETERMINED IN THE FIELD. SHALL BE CONSTRUCTED PER SHEET 26.
  3. FINAL CONTOURS ARE TO BE TAKEN FROM CROSS SECTIONS.

- LEGEND
- SILT FENCE
  - PDF PDF
  - x-x-x-x SNOW FENCE (MOD. - ARCH)

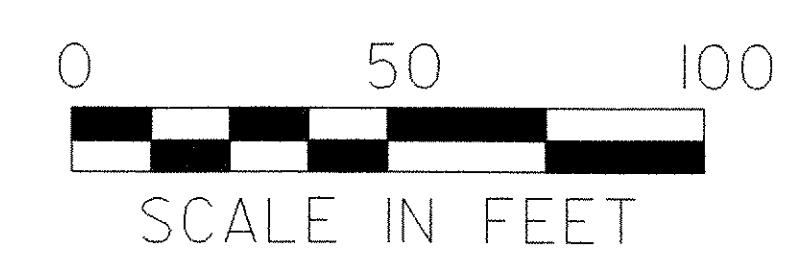

EXISTING CONDITIONS	
PROJECT NAME:	HARDWICK
PROJECT NUMBER:	STP ST 030-3(4)
FILE NAME:	d04e060bdr.dgn
PROJECT LEADER:	A. BOMBARDIER
DESIGNED BY:	M. NUTTER
IPARM NAME:	d04e060epscl2.1
PLOT DATE:	18-OCT-2005
DRAWN BY:	M. NUTTER
CHECKED BY:	A. BOMBARDIER
SHEET	21 OF 63