



CADD  
CWP  
2907

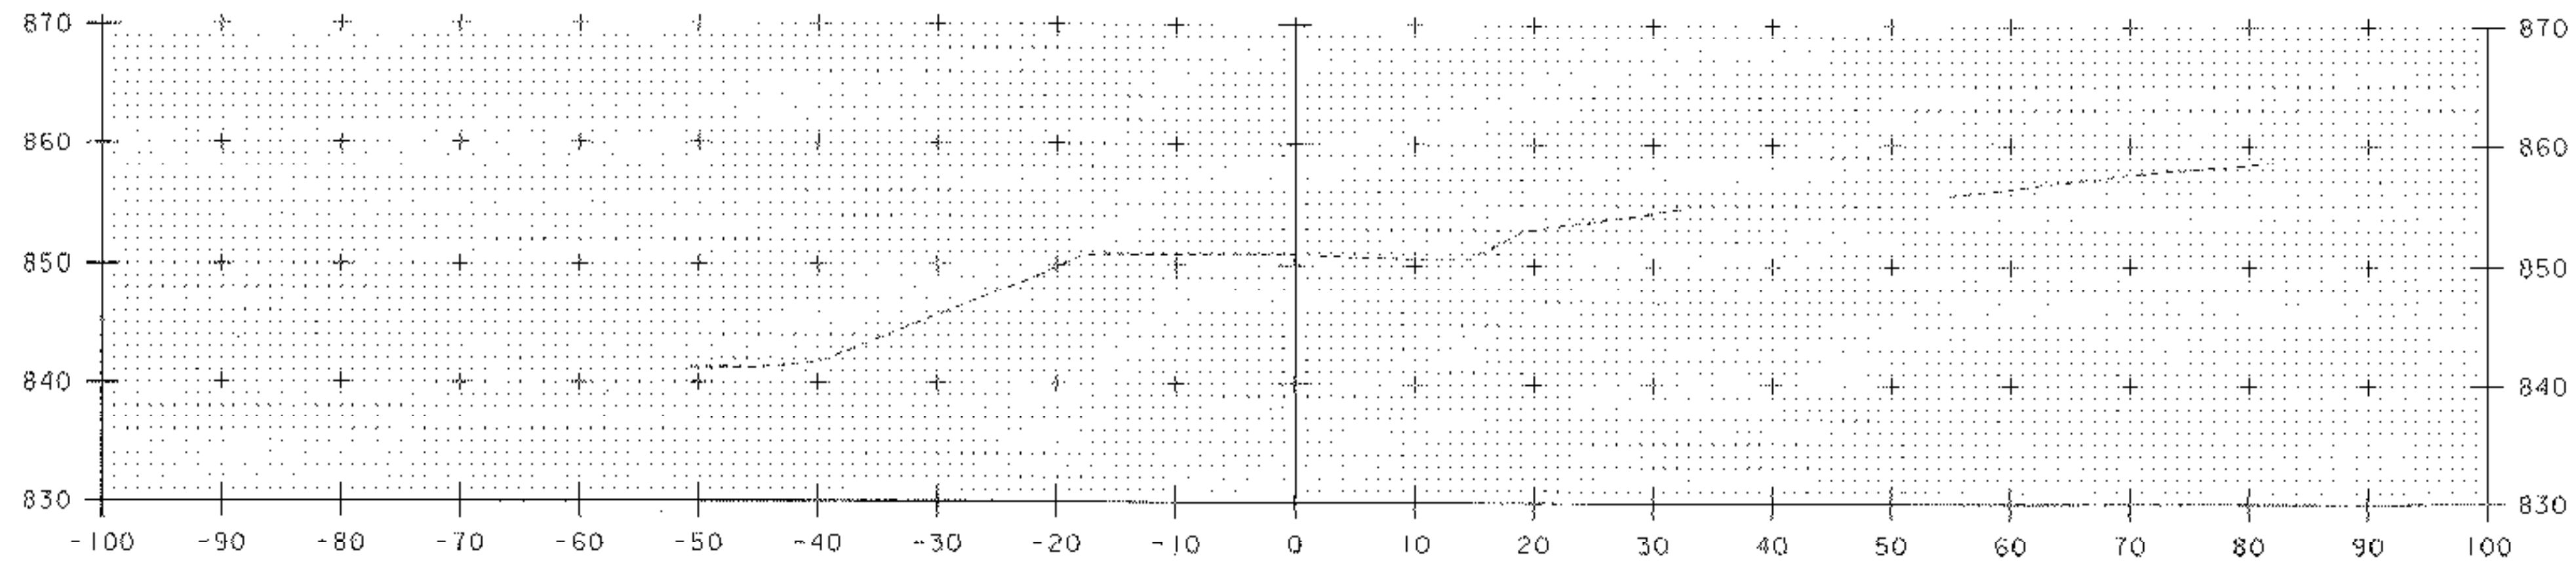

196+60 ~~58~~ MATCH EXISTING

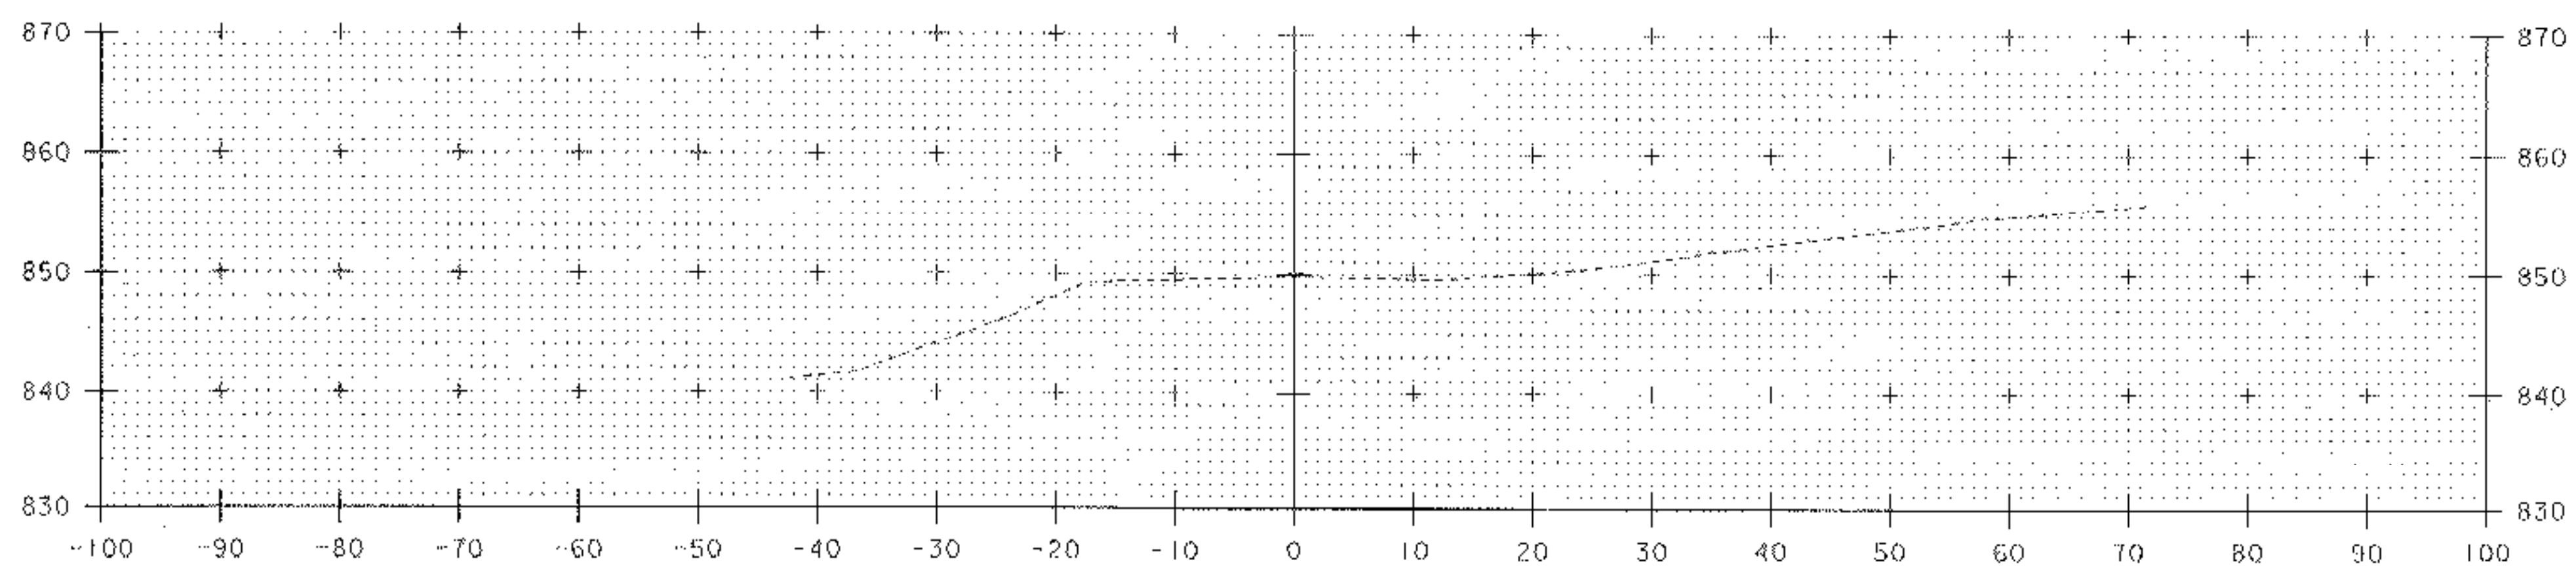

196+40



STA. 196+40 TO STA. 196+60

PROJECT NAME: HARDWICK	PLOT DATE: 18-OCT-2005
PROJECT NUMBER: STP ST 030-3(4)	DRAWN BY: M. NUTTER
FILE NAME: d04e060xslx.dgn	CHECKED BY: A. BOMBARDIER
PROJECT LEADER: A. BOMBARDIER	SHEET 32 OF 63
DESIGNED BY: M. NUTTER	
IPARM NAME: de060xslx.dgn	