



197+00

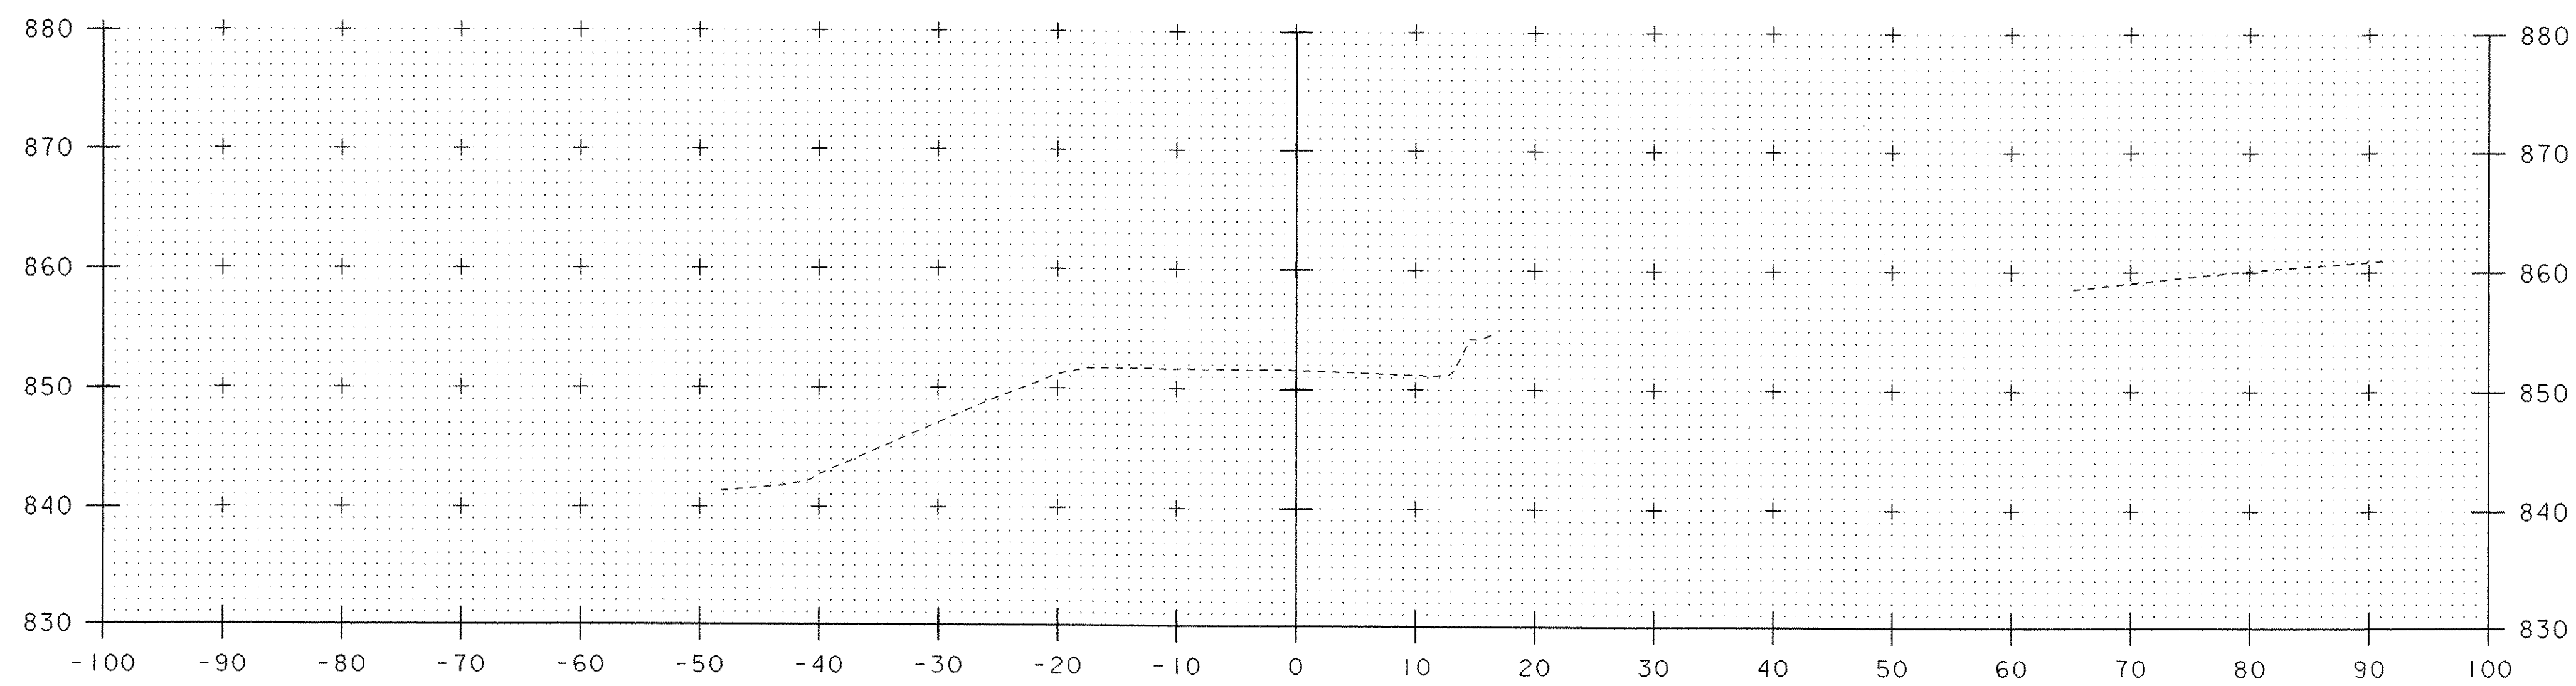

196+80

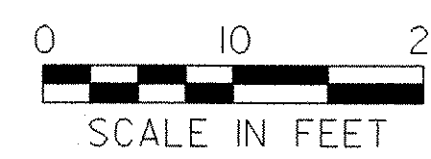

STA. 196+80 TO STA. 197+00

PROJECT NAME: HARDWICK
 PROJECT NUMBER: STP ST 030-3(4)

FILE NAME: d04e060xslx.dgn
 PROJECT LEADER: A. BOMBARDIER
 DESIGNED BY: M. NUTTER
 IPARM NAME: de060xs02.i

PLOT DATE: 18-OCT-2005
 DRAWN BY: M. NUTTER
 CHECKED BY: A. BOMBARDIER
 SHEET 33 OF 63