



197+40

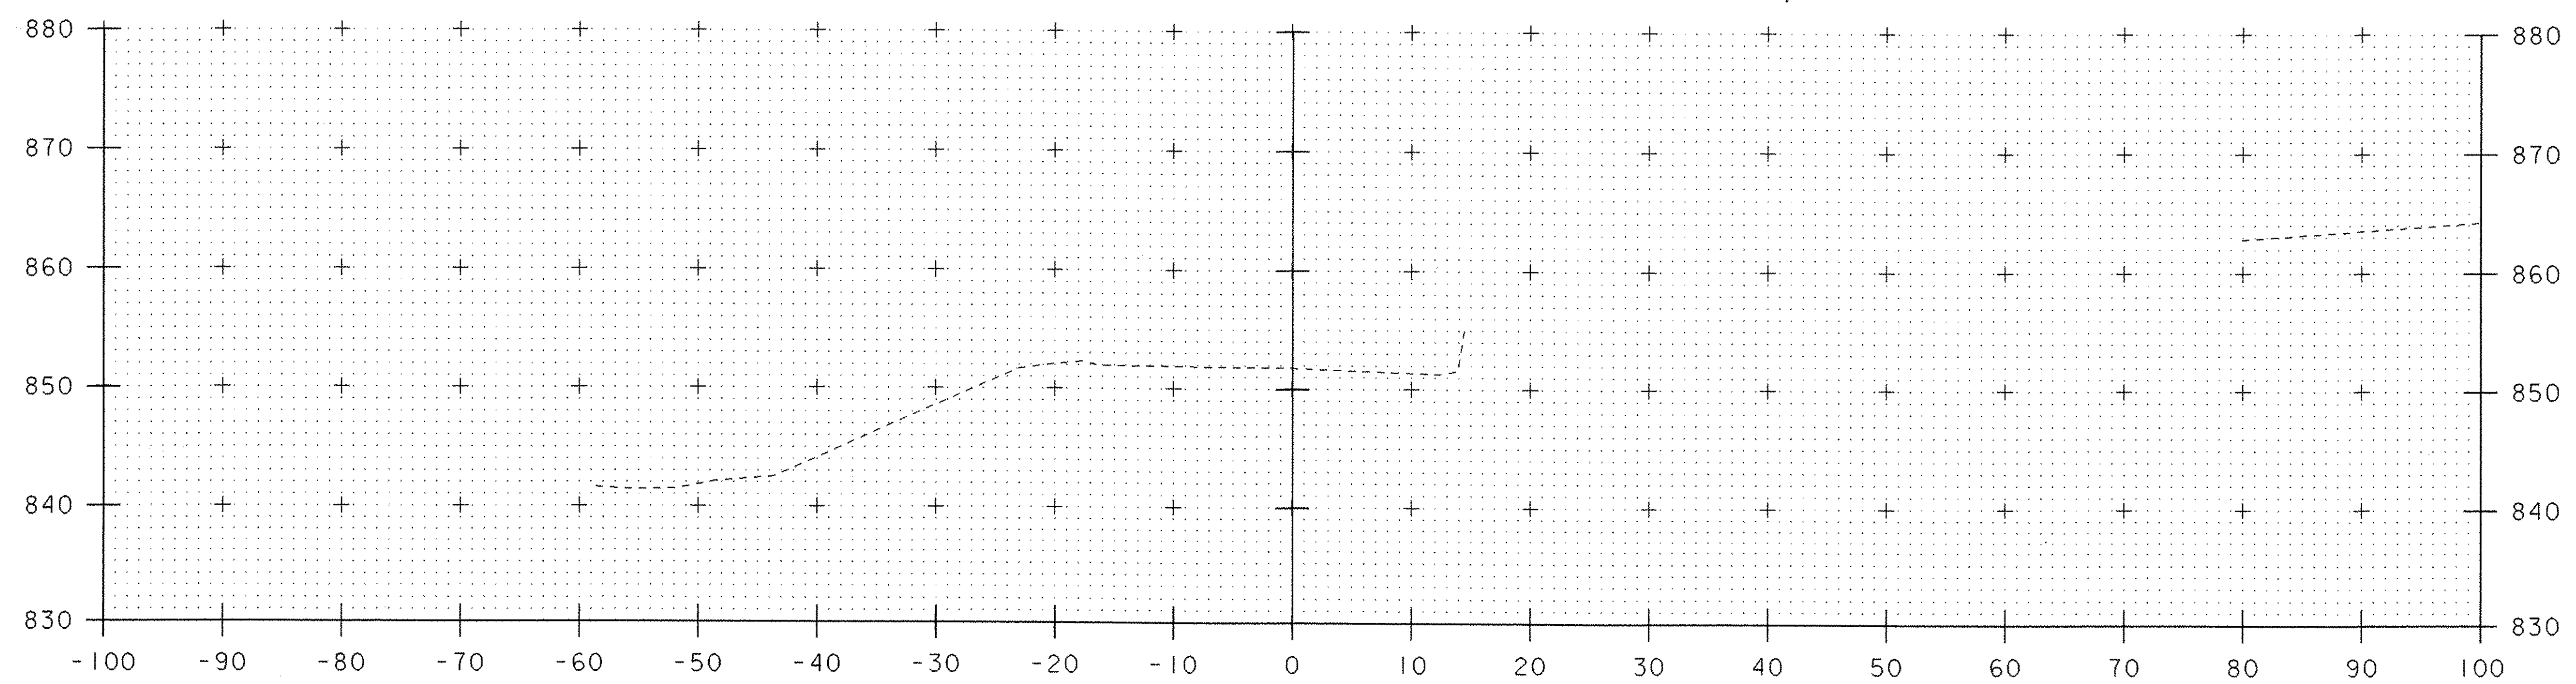

197+20

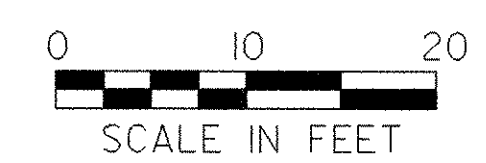

PROJECT NAME: HARDWICK	PLOT DATE: 18-OCT-2005
PROJECT NUMBER: STP ST 030-3(4)	DRAWN BY: M. NUTTER
FILE NAME: d04e060xslx.dgn	CHECKED BY: A. BOMBARDIER
PROJECT LEADER: A. BOMBARDIER	SHEET 34 OF 63
DESIGNED BY: M. NUTTER	
IPARM NAME: de060xs03.l	

STA. 197+20 TO STA. 197+40