



000  
649  
2-2-07

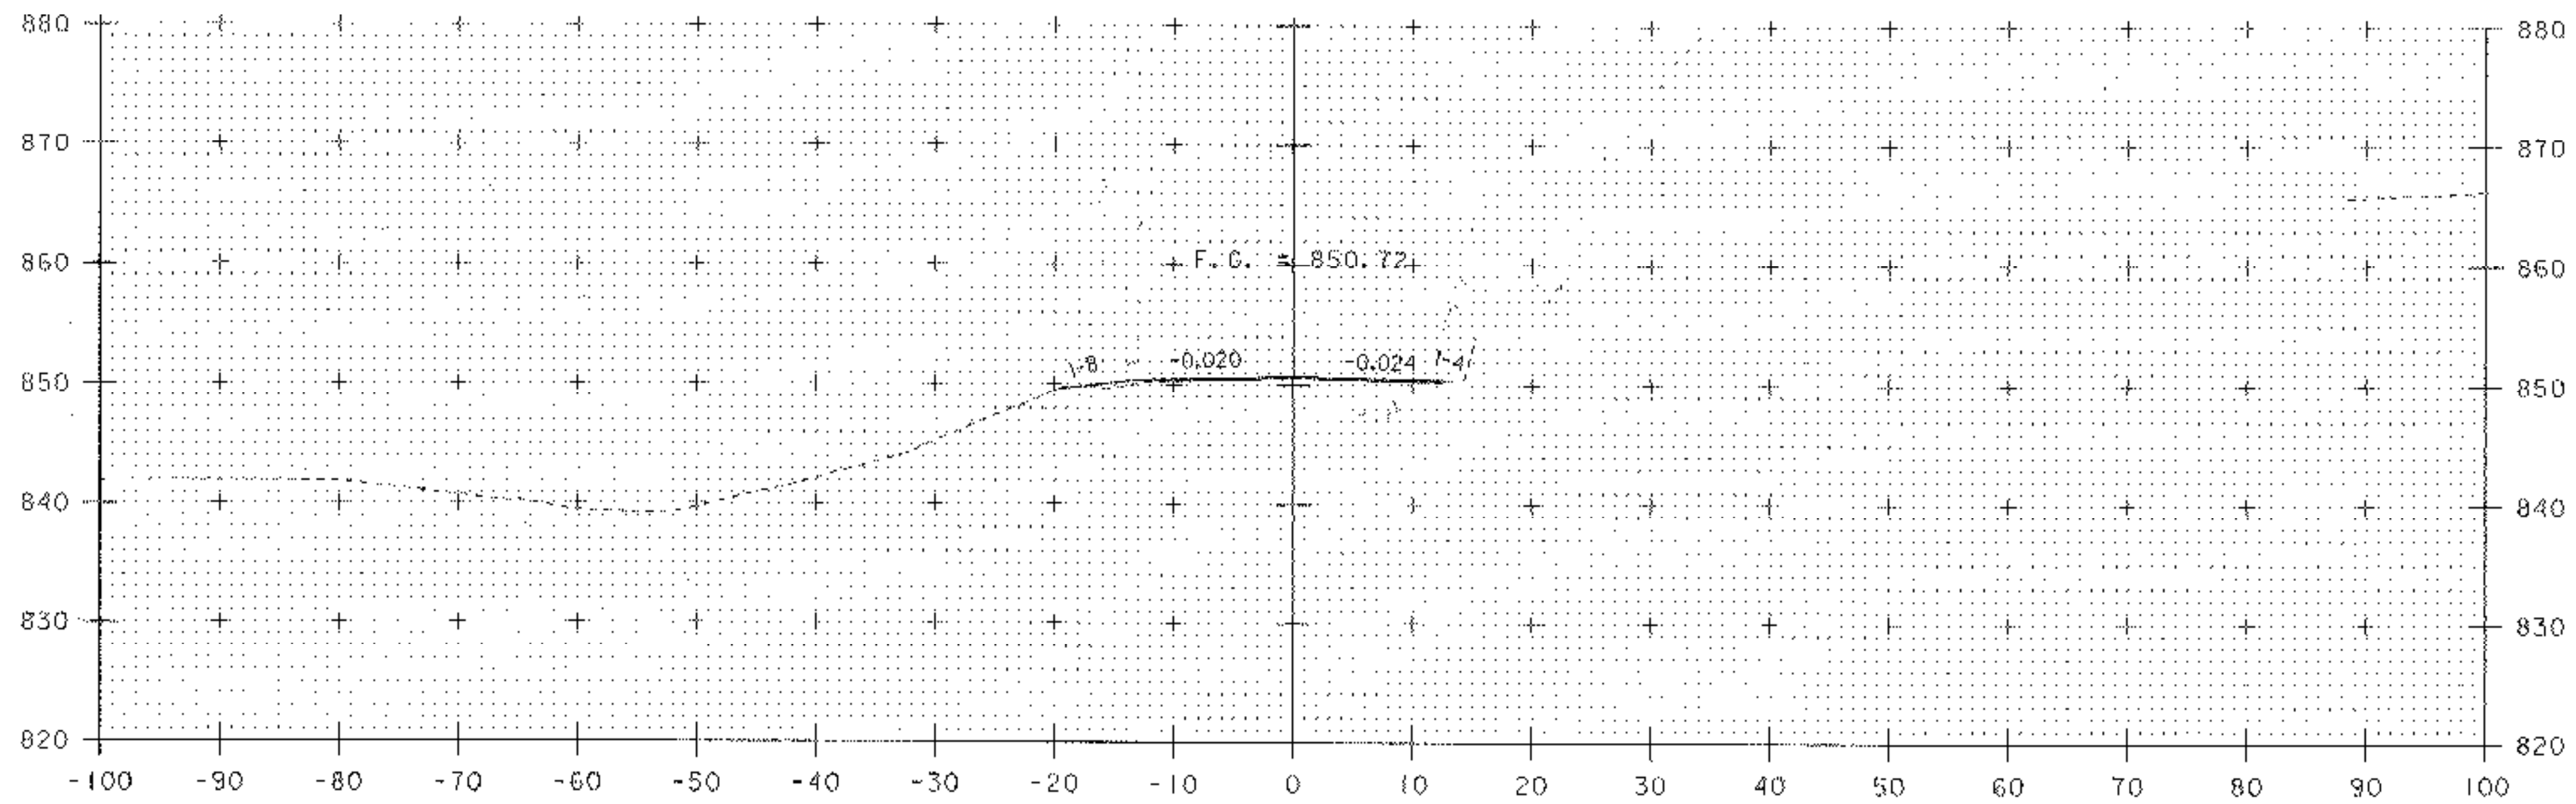


197+60

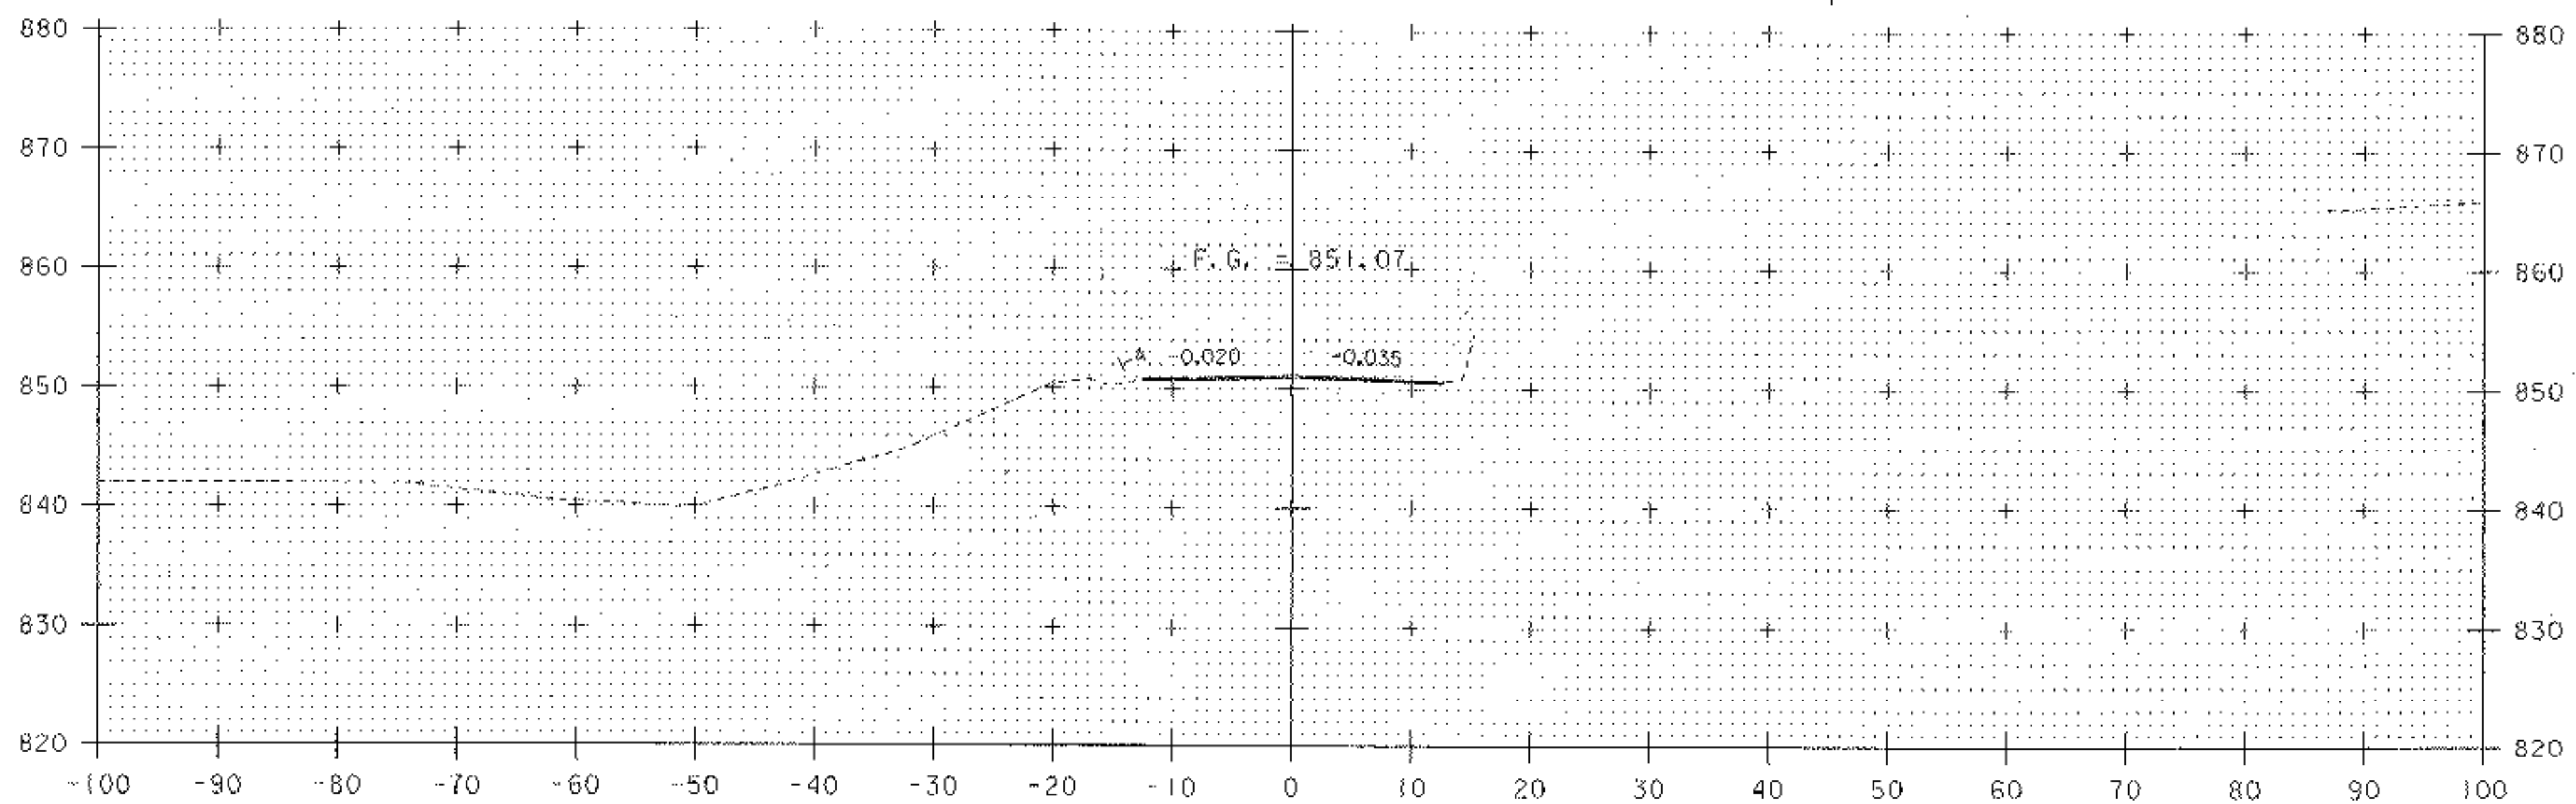

197+50

~~MATCH EXISTING~~  
SEE SHEET 32

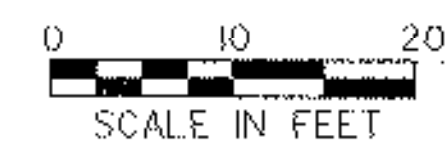

SCALE IN FEET

STA. 197+50 TO STA. 197+60

PROJECT NAME: HARDWICK	PLOT DATE: 18-OCT-2005
PROJECT NUMBER: STP ST 030-3(4)	DRAWN BY: M. NUTTER
FILE NAME: d04e060xelx.dgn	CHECKED BY: A. BOMBARDIER
PROJECT LEADER: A. BOMBARDIER	SHEET 35 OF 63
DESIGNED BY: M. NUTTER	
IPARM NAME: d060xs04.i	