


198+00

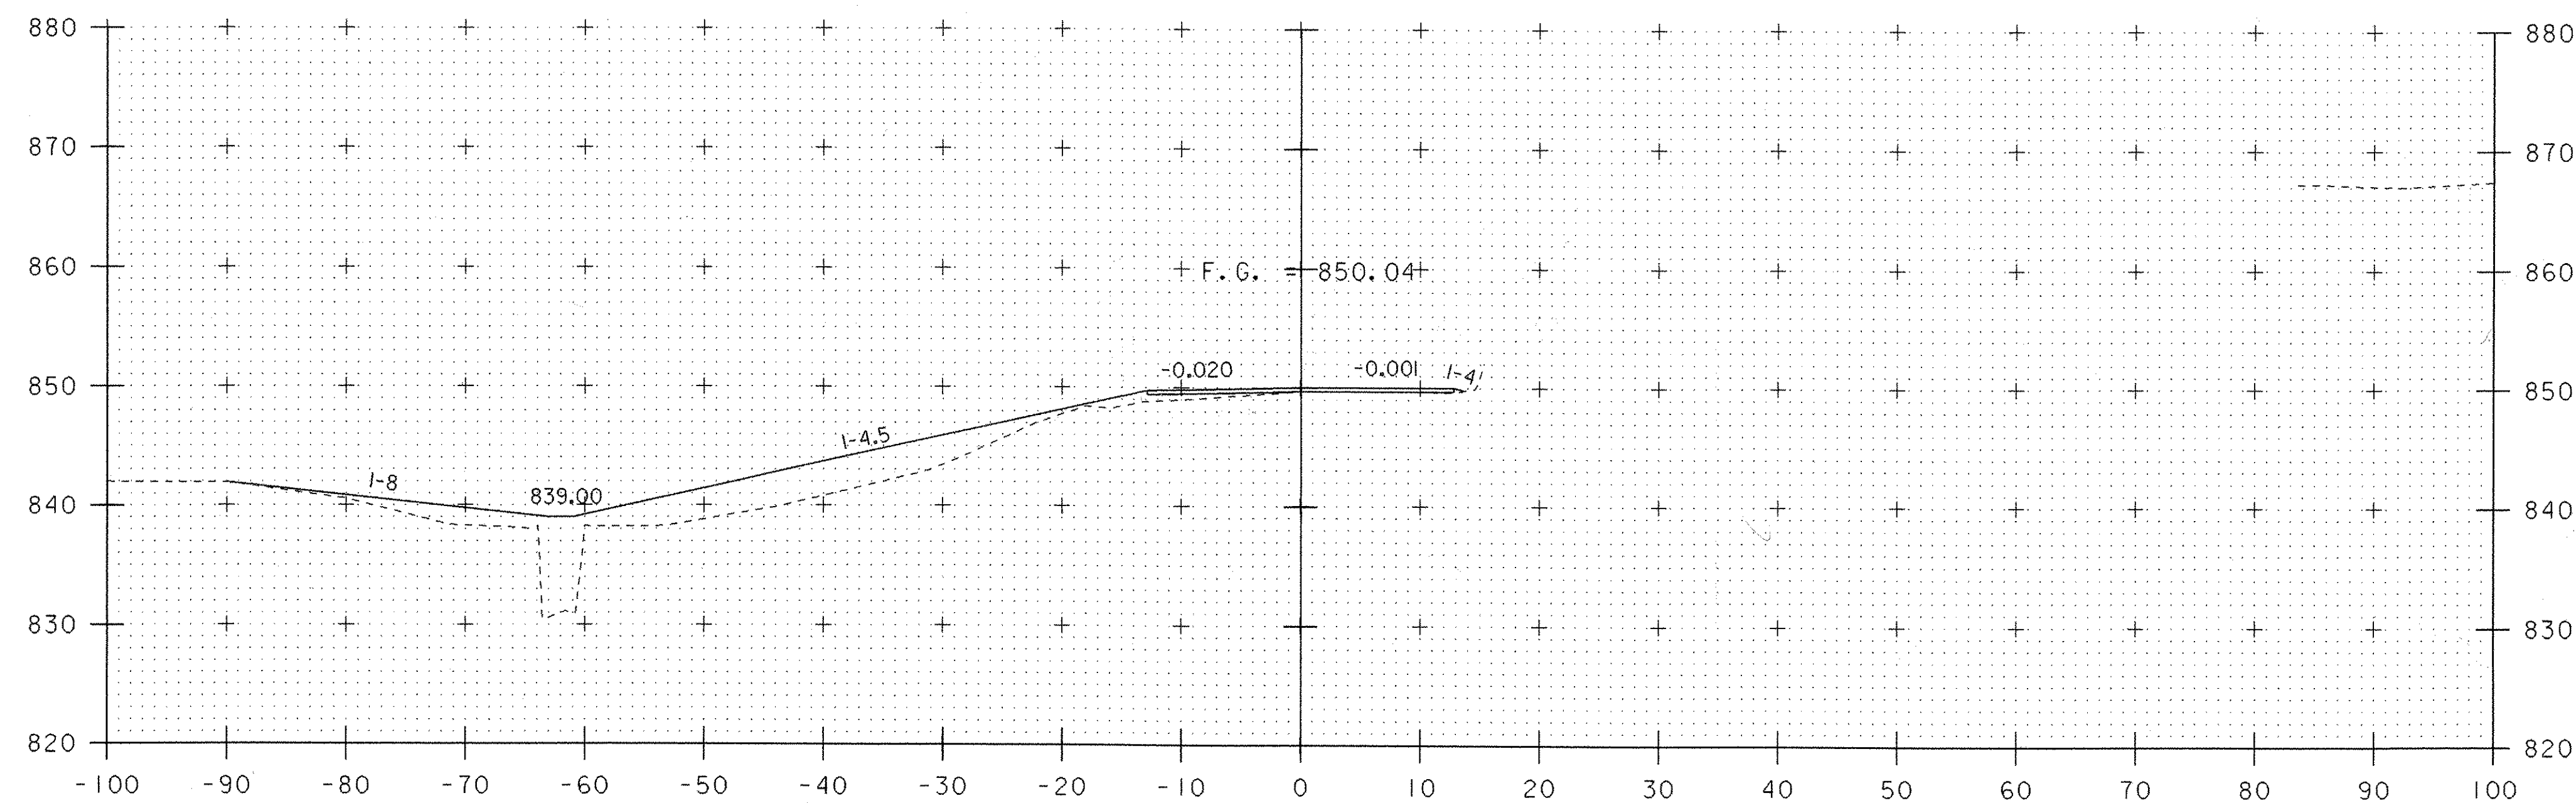

197+80

Nut (17)

22
40

16
34

20 19.5

39 19

20 19

19.25 / 0.64 30.08 Fr 2
L 3w

KRM 1-10-07

Common KRM 12-12-06
12-29-06



STA. 197+80 TO STA. 198+00

PROJECT NAME: HARDWICK
PROJECT NUMBER: STP ST 030-3(4)

FILE NAME: d04e060xslx.dgn
PROJECT LEADER: A. BOMBARDIER
DESIGNED BY: M. NUTTER
IPARM NAME: de060xs05.i

PLOT DATE: 18-OCT-2005
DRAWN BY: M. NUTTER
CHECKED BY: A. BOMBARDIER
SHEET 36 OF 63