



198+40

COMMON
 33 32.5
 67 32.5
 32 32.5
 65 32.5
 KRM 12-12-06
 GJ 12-07
 $\frac{33.0}{0.64} = 51.56 \text{ FT}^2$

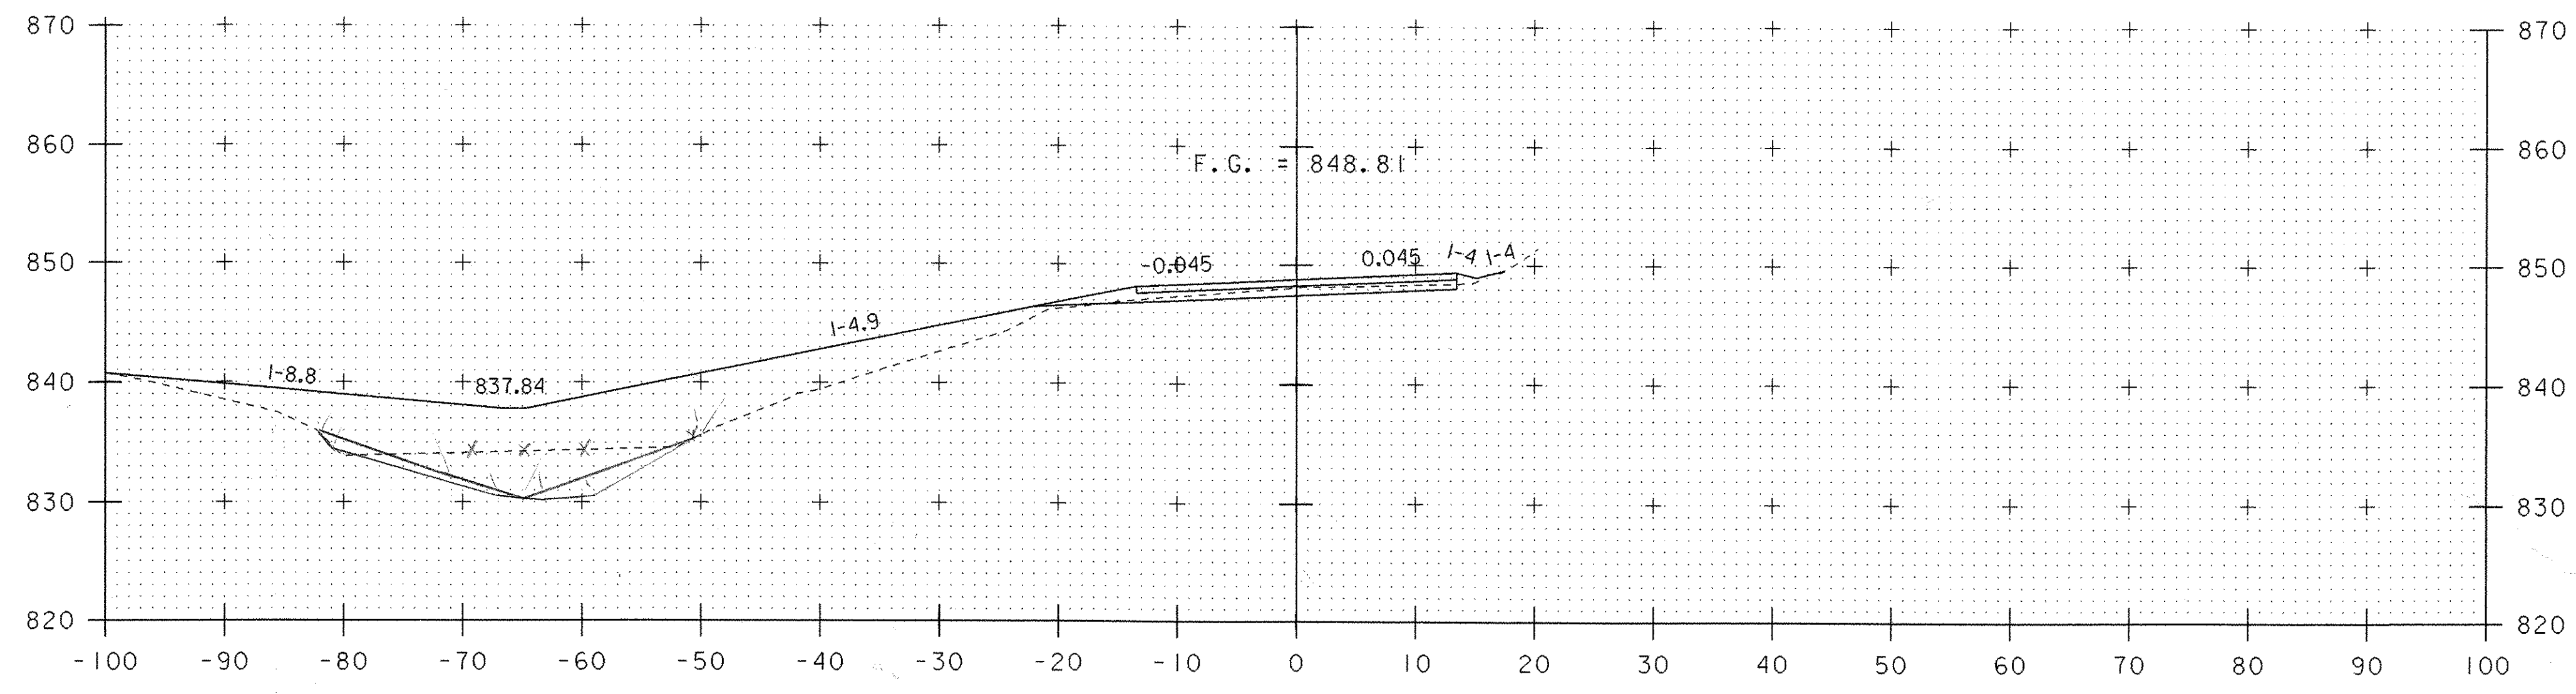

198+20

Muck (35)
 16 16
 32 16
 17 16.5
 33 16.5
 $\frac{16.25}{0.64} = 25.39 \text{ FT}^2$
 LTN
 KRM 1-10-07
 COMMON
 9 9.5
 19 10
 20 10
 KRM 12-12-06
 GJ 11-29-06
 $\frac{9.8}{0.64} = 15.23 \text{ FT}^2$

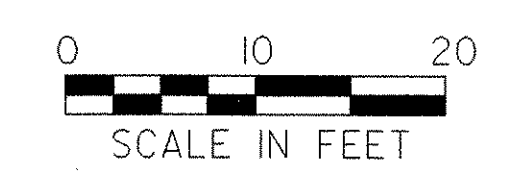

STA. 198+20 TO STA. 198+40

PROJECT NAME:	HARDWICK	PLOT DATE:	18-OCT-2005
PROJECT NUMBER:	STP ST 030-3(4)	DRAWN BY:	M. NUTTER
FILE NAME:	d04e060xslx.dgn	DESIGNED BY:	A. BOMBARDIER
PROJECT LEADER:	A. BOMBARDIER	CHECKED BY:	A. BOMBARDIER
IPARM NAME:	de060xs06.i	SHEET	37 OF 63