


198+80


Common KRM 12-12-06
 84 ✓
 170 85
 $\frac{84.5}{0.64} = 132.03 \text{ FT}^2$
 84 84
 168 84

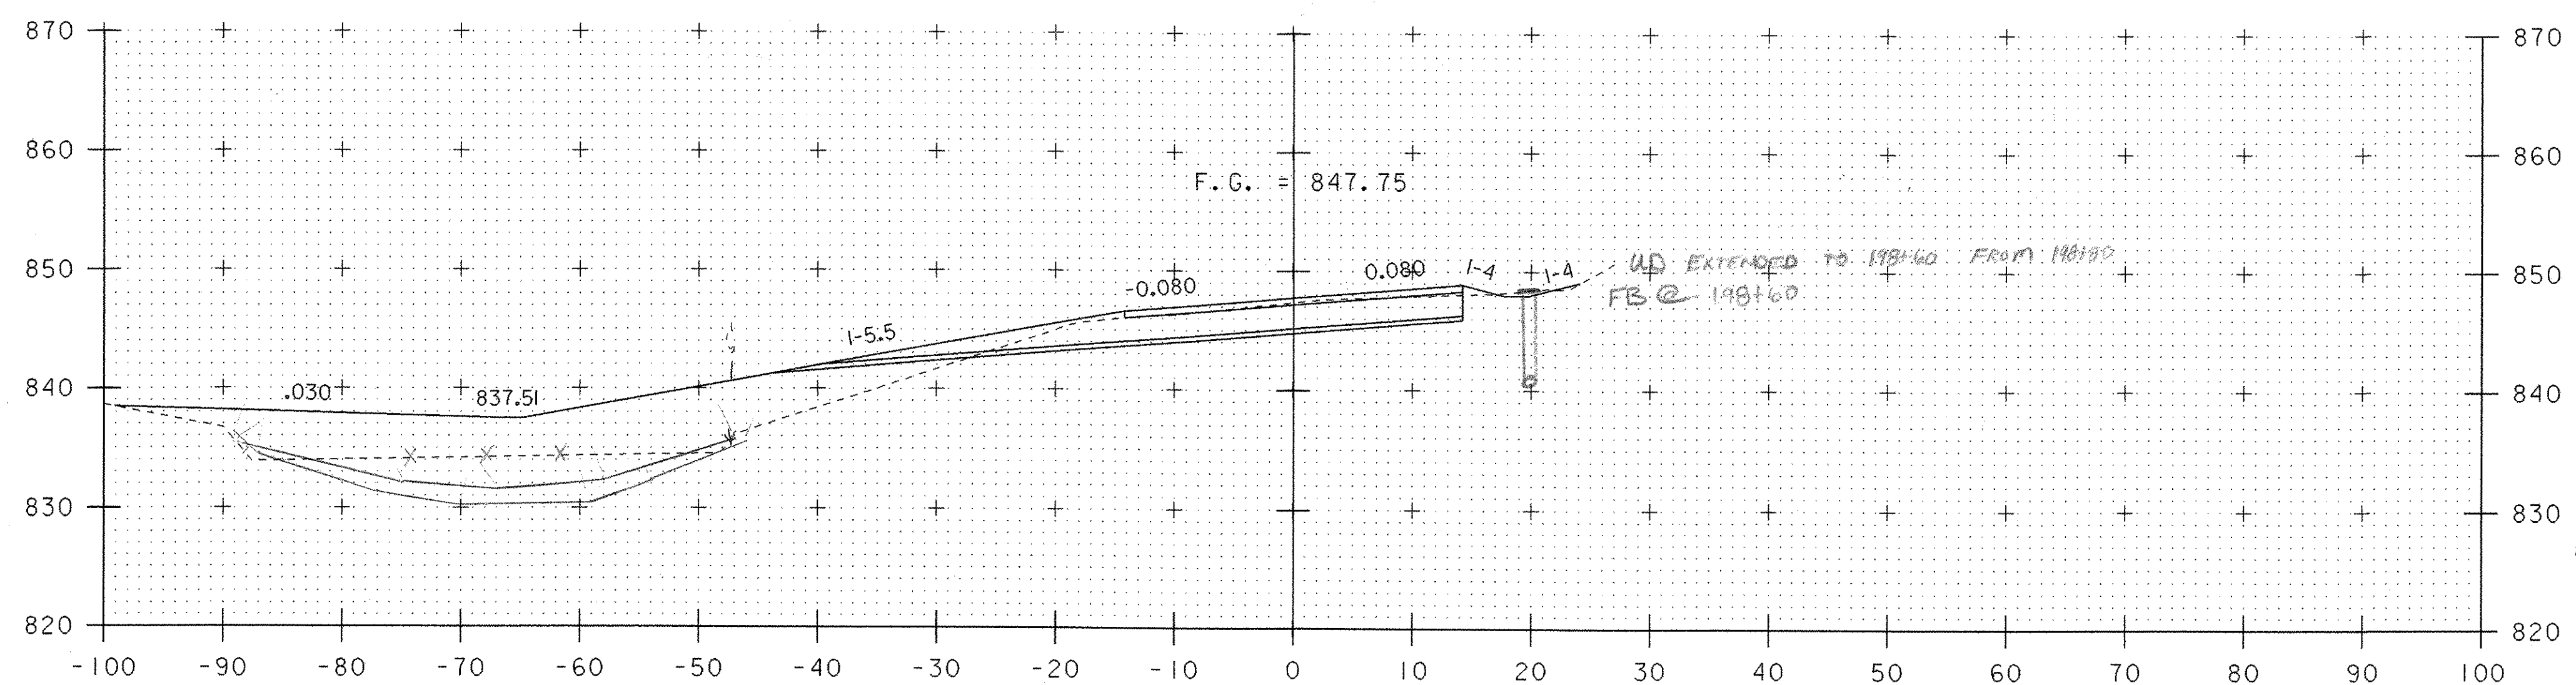

198+60

Mux (CS)
 29 ✓
 58 29 ✓
 31
 63 wyl
 $\frac{29.25}{.64} = 45.7 \text{ FT}$
 28
 55 low
 28
 58 29.5 ✓
 KRM
 1-10-07

Common KRM 12-12-06
 55 ✓
 112 56
 $\frac{55.25}{0.64} = 86.33 \text{ FT}^2$
 55 54.5
 109

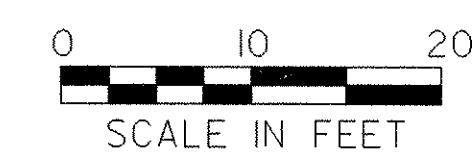

STA. 198+60 TO STA. 198+80

PROJECT NAME: HARDWICK
 PROJECT NUMBER: STP ST 030-3(4)

FILE NAME: d04e060xslx.dgn
 PROJECT LEADER: A. BOMBARDIER
 DESIGNED BY: M. NUTTER
 IPARM NAME: de060xs07.i
 PLOT DATE: 18-OCT-2005
 DRAWN BY: M. NUTTER
 CHECKED BY: A. BOMBARDIER
 SHEET 38 OF 63