


199+20

Common KRM 12-12-06  
 94 95  
 190  
 $\frac{95.75}{0.64} = 149.61 \text{ FT}^2$   
 96 96.5  
 193

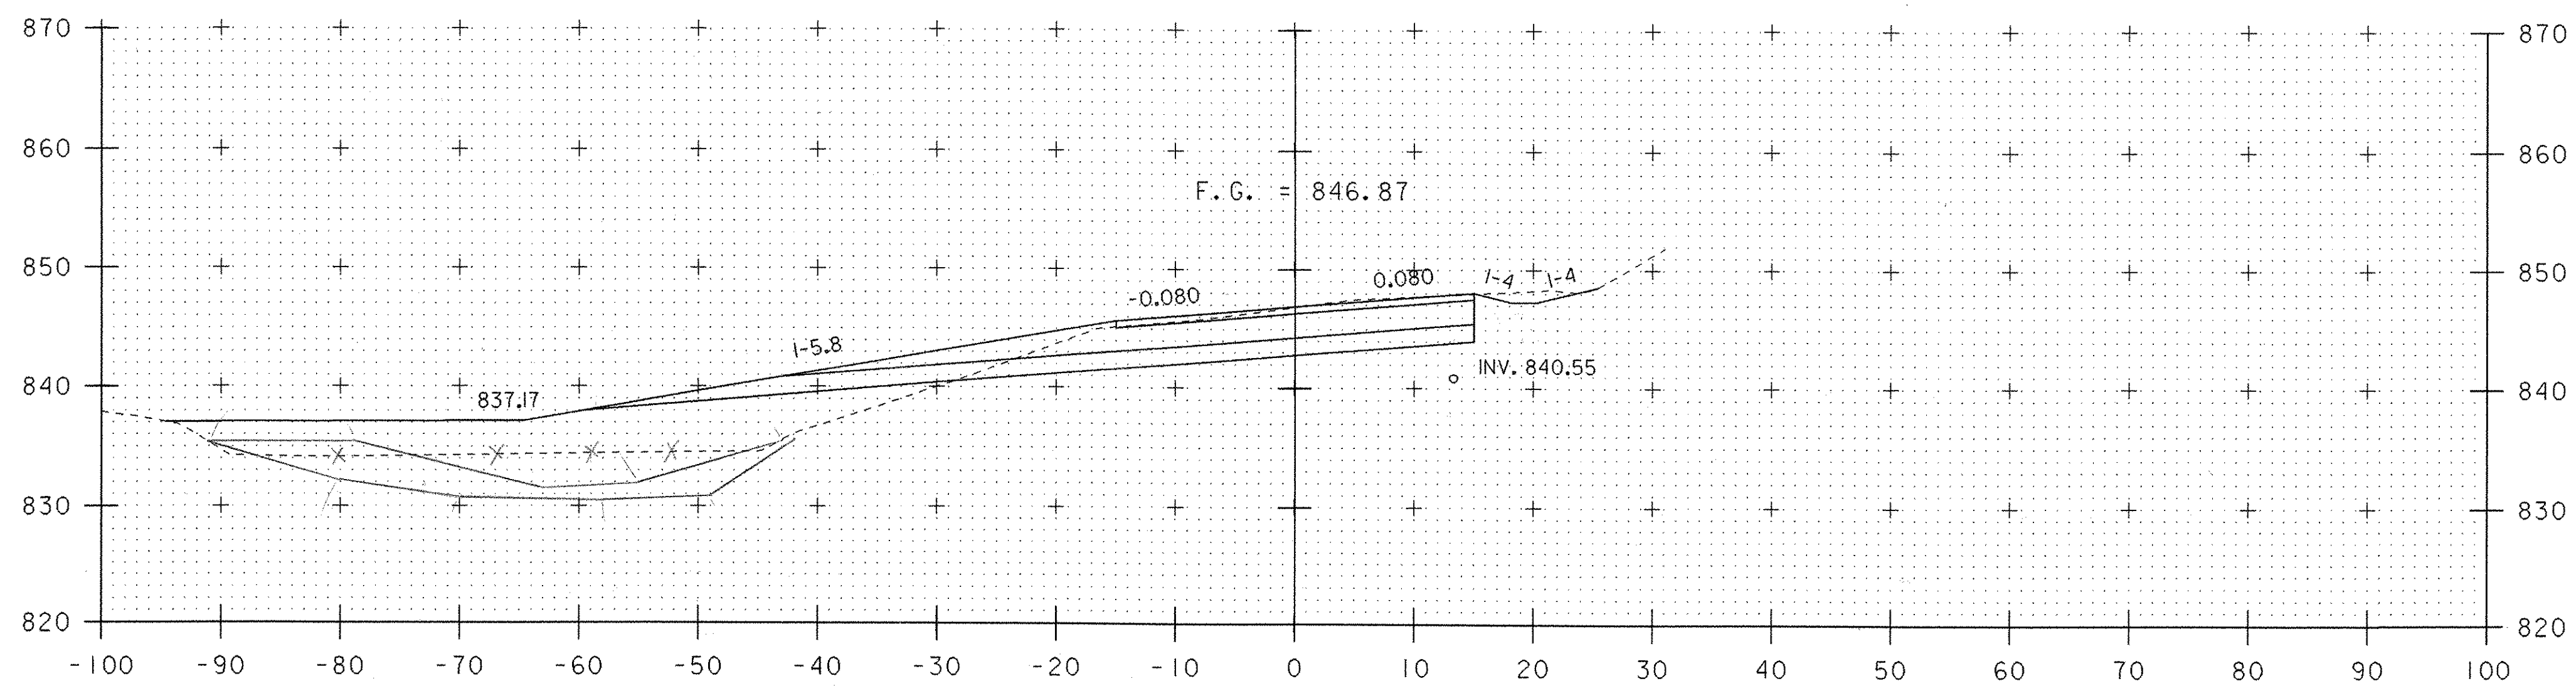

199+00

Muck (60)  
 60 61  
 122  
 $\frac{60.5}{0.64} = 94.53 \text{ FT}^2$   
 61 60  
 120  
 KRM 1-10-07

Common KRM 12-12-06  
 93 94  
 188  
 $\frac{94}{0.64} = 146.88 \text{ FT}^2$   
 93 94  
 188



STA. 199+00 TO STA. 199+20

PROJECT NAME: HARDWICK  
 PROJECT NUMBER: STP ST 030-3(4)

FILE NAME: d04e060xslx.dgn  
 PROJECT LEADER: A. BOMBARDIER  
 DESIGNED BY: M. NUTTER  
 IPARM NAME: de060xs08.1

PLOT DATE: 18-OCT-2005  
 DRAWN BY: M. NUTTER  
 CHECKED BY: A. BOMBARDIER  
 SHEET 39 OF 63