


COMMON 12-14-06
 108 108
 $\frac{108.6}{0.64} = 169.53 \text{ FT}^2$
 110 109
 218

199+60

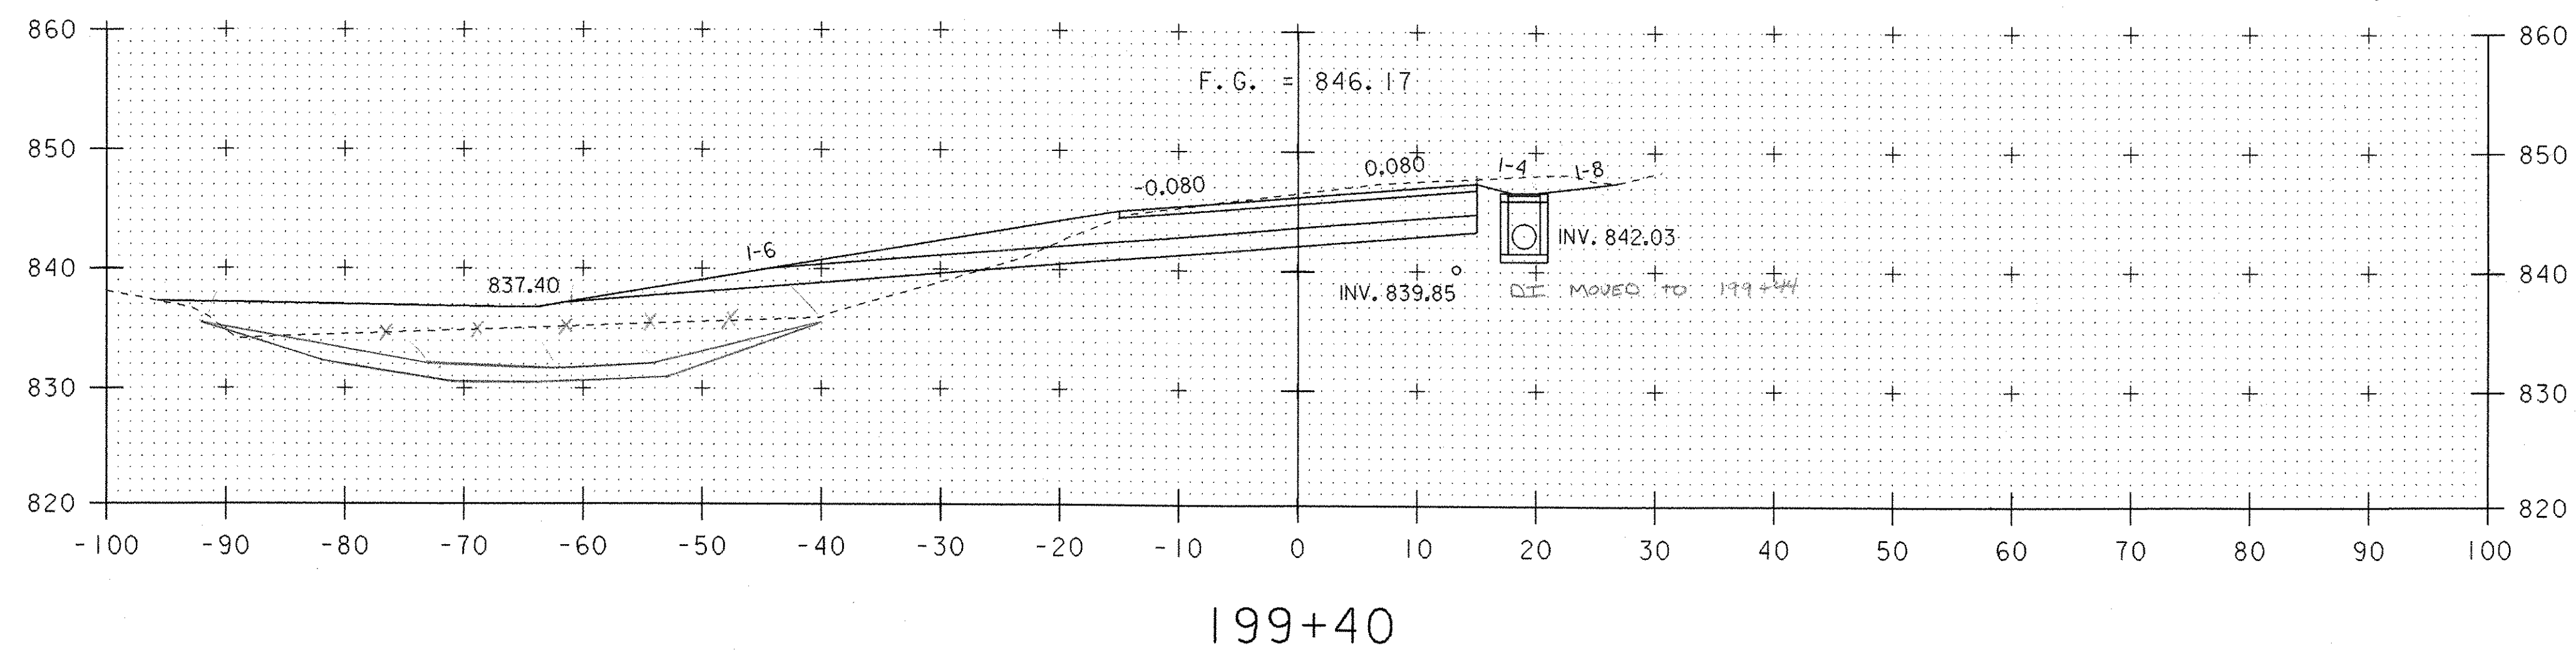

MUCK (3)
 33
 70
 33
 69
 36 34.5
 69
 35
 70
 $\frac{34.35}{0.41} = 54.30 \text{ FT}^2$
 6 IN
 1-10-07

COMMON KRM 12-12-06
 99 98.5
 197
 100
 199 99.5
 $\frac{99}{0.64} = 154.69 \text{ FT}^2$

199+40



PROJECT NAME: HARDWICK
 PROJECT NUMBER: STP ST 030-3(4)
 FILE NAME: d04e060xslx.dgn
 PROJECT LEADER: A. BOMBARDIER
 DESIGNED BY: M. NUTTER
 IPARM NAME: de060xs09.1
 PLOT DATE: 18-OCT-2005
 DRAWN BY: M. NUTTER
 CHECKED BY: A. BOMBARDIER
 SHEET 40 OF 63

STA. 199+40 TO STA. 199+60