


200+00


COMMON KRM 12-14-00
 CS 12-20-00
 28 28.5
 57 28.5
 27 28
 56 28
 $\frac{28.5}{0.16} = 176.56 \text{ FT}^2$

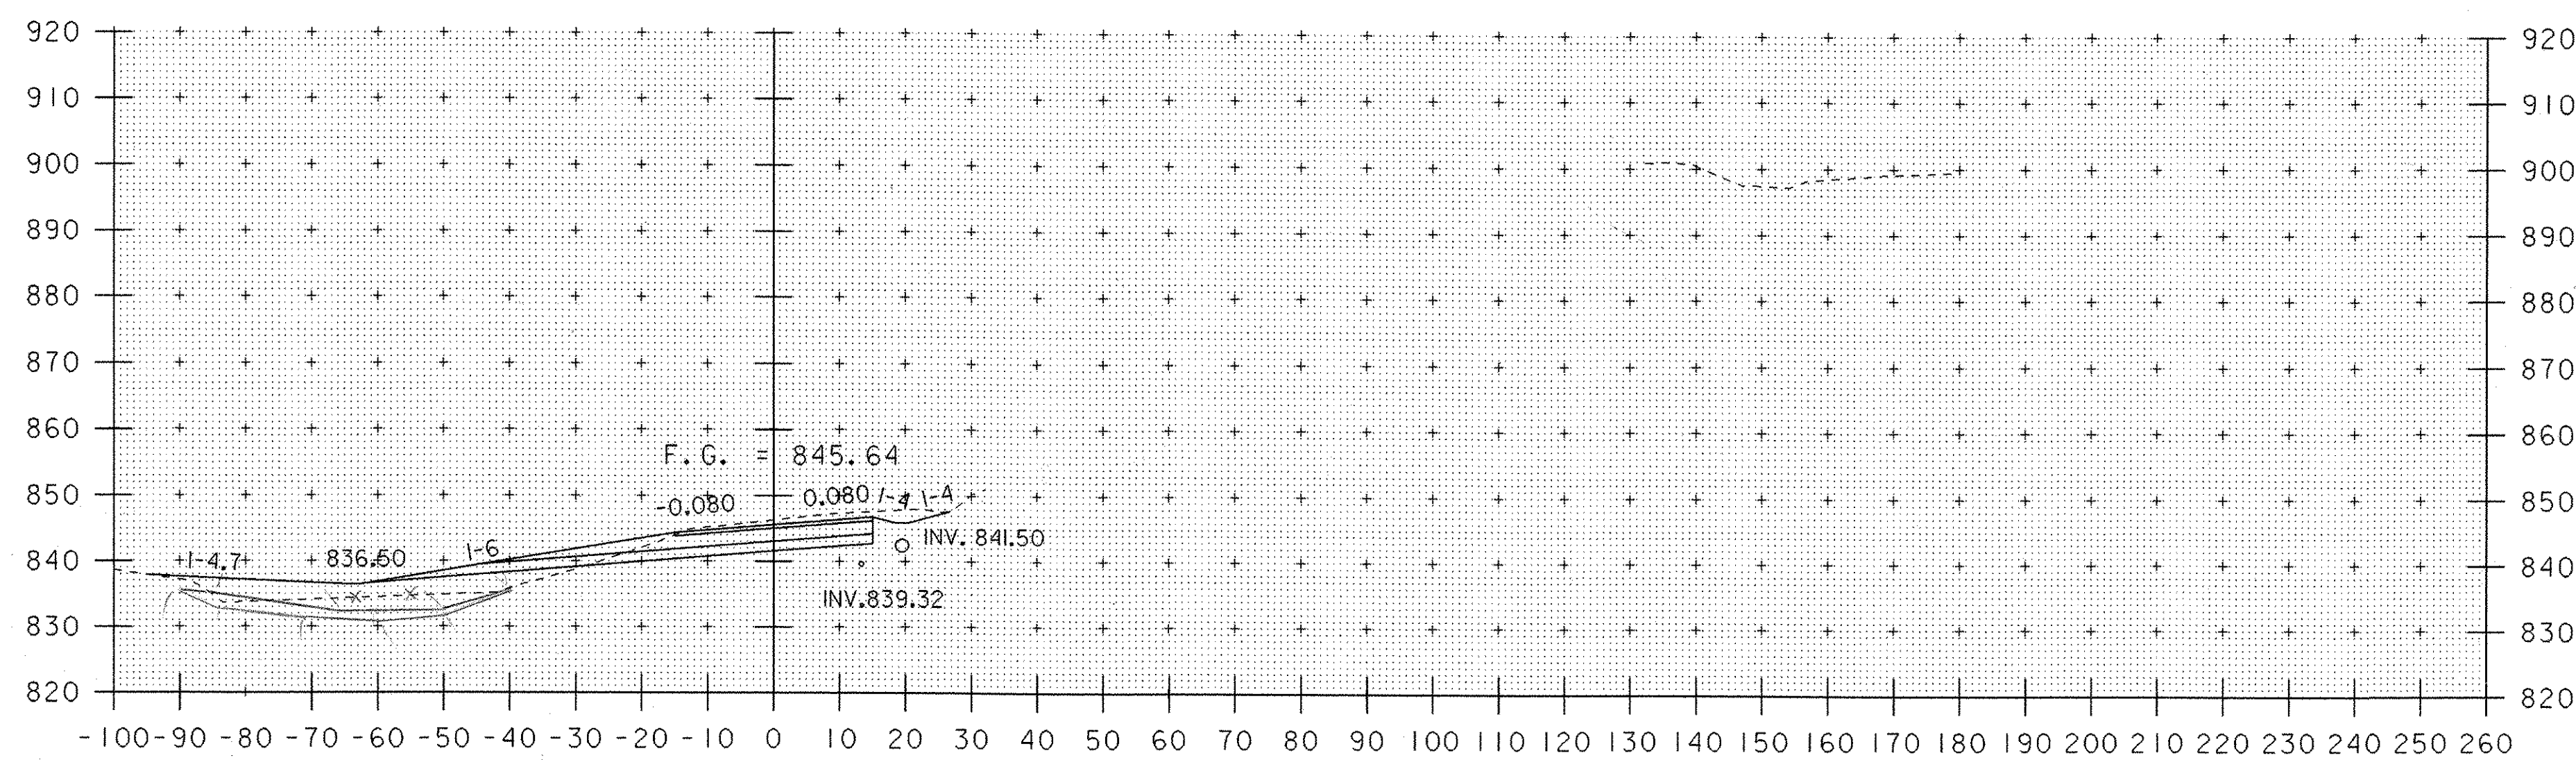

199+80

Muck (CS)
 10 10.5
 21 10.5
 10 11
 22 11
 $\frac{10.75}{16} = 67.19 \text{ FT}^2$
 CS

COMMON KRM 12-14-00
 CS 12-07
 28 28
 56 28
 28 28
 56 28
 $\frac{28}{0.16} = 175.00 \text{ FT}^2$

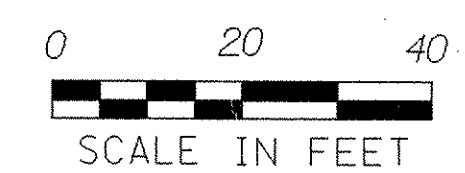

PROJECT NAME: HARDWICK	
PROJECT NUMBER: STP ST 030-3(4)	
FILE NAME: d04e060xslx.dgn	PLOT DATE: 18-OCT-2005
PROJECT LEADER: A. BOMBARDIER	DRAWN BY: M. NUTTER
DESIGNED BY: M. NUTTER	CHECKED BY: A. BOMBARDIER
IPARM NAME: de060xsl0.i	SHEET 42 OF 63

STA. 199+80 TO STA. 200+00