



Common KRM 12-14-06
 38 38.5
 77
 $\frac{38.25}{0.16} = 239.06 \text{ FT}^2$
 39 38.0
 76

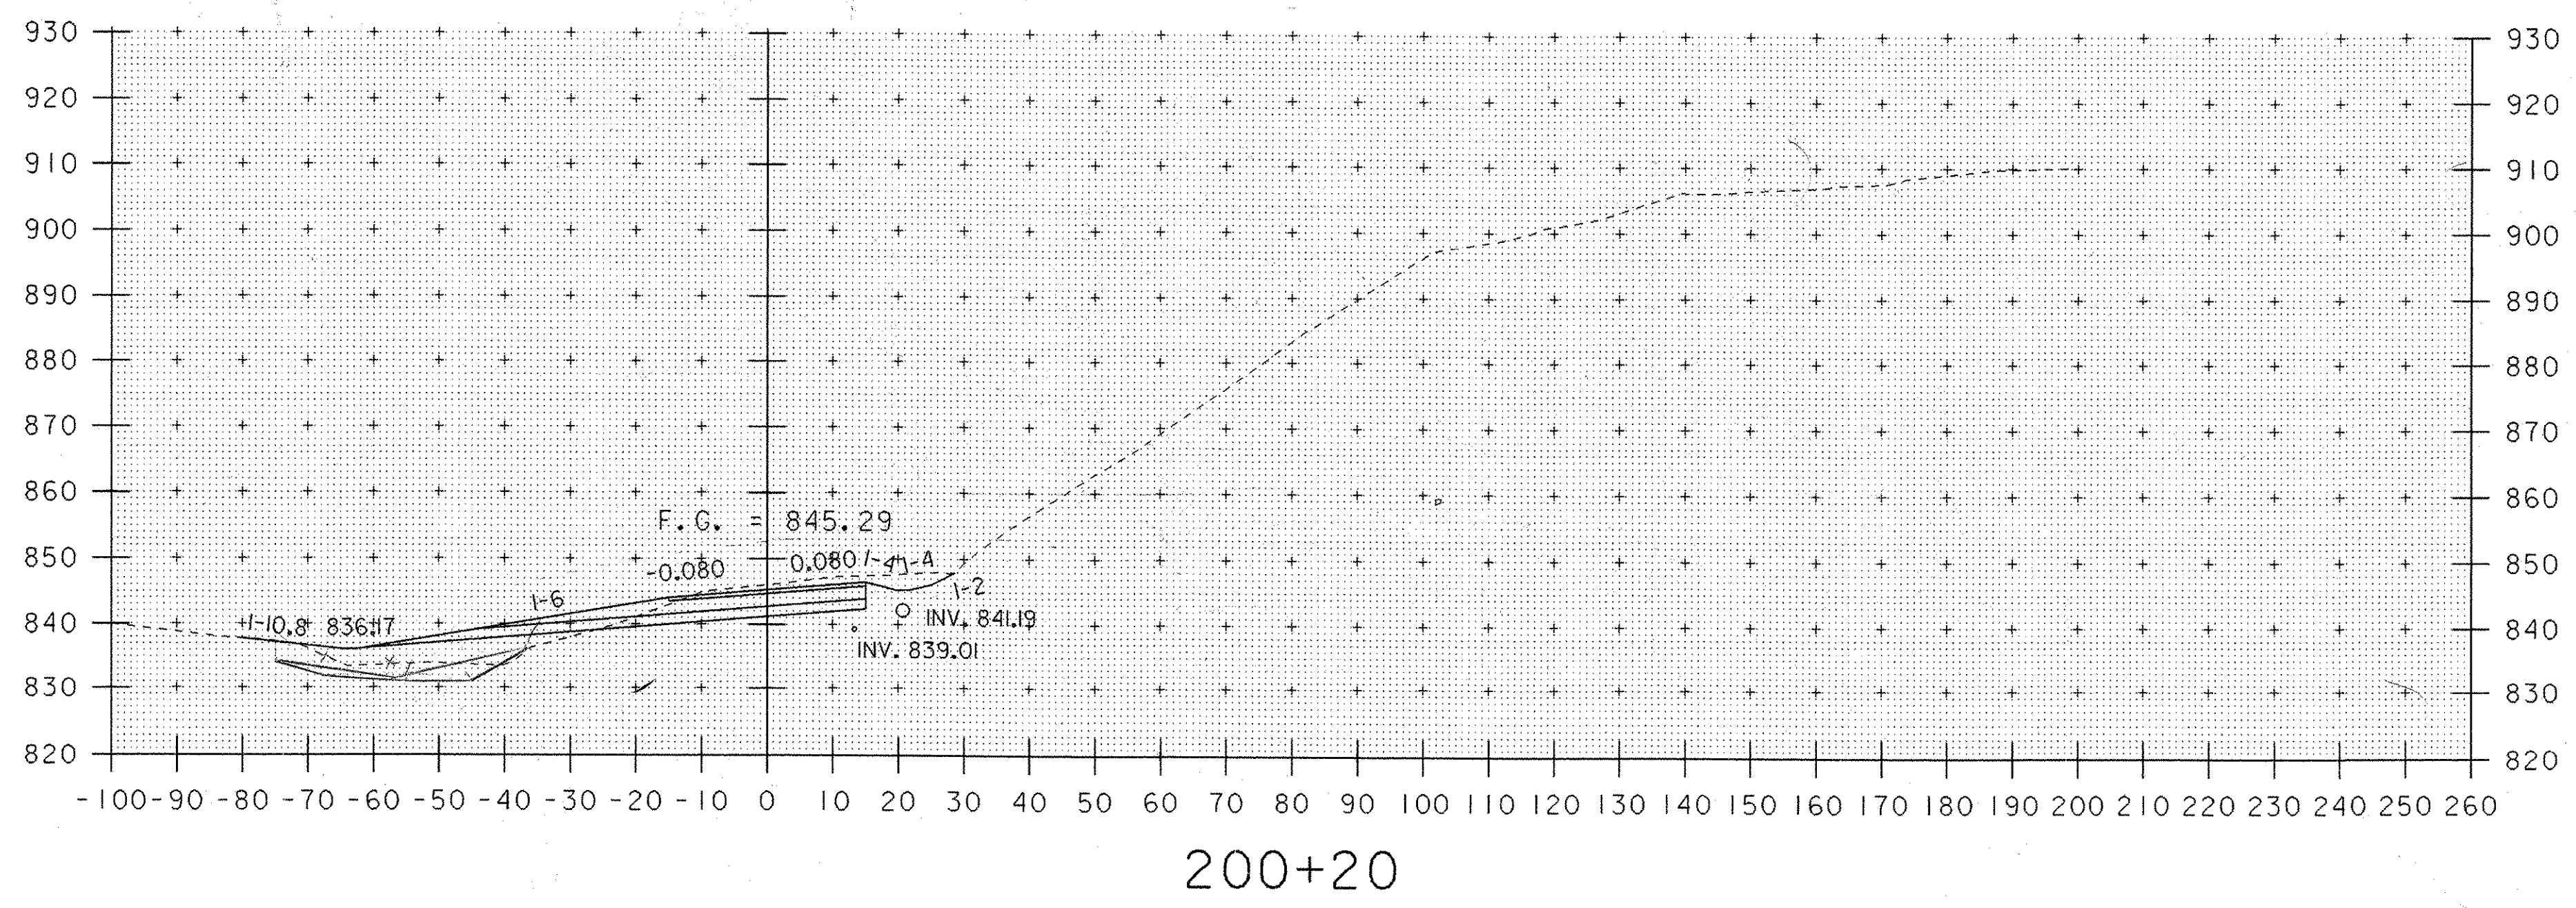

MULL (S)
 8
 16 8
 $\frac{8 \times 50}{16} = 25 \text{ FT}^2$
 8
 16 8
 COMMON KRM 12-14-06
 30 29
 58
 $\frac{29}{0.16} = 181.25 \text{ FT}^2$
 29 29
 58

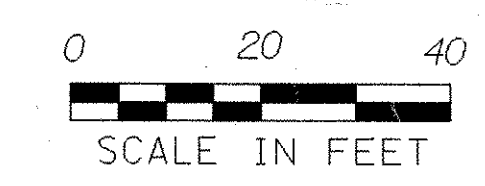

STA. 200+20 TO STA. 200+40

| | |
|---------------------------------|---------------------------|
| PROJECT NAME: HARDWICK | |
| PROJECT NUMBER: STP ST 030-3(4) | |
| FILE NAME: d04e060xstx.dgn | PLOT DATE: 18-OCT-2005 |
| PROJECT LEADER: A. BOMBARDIER | DRAWN BY: M. NUTTER |
| DESIGNED BY: M. NUTTER | CHECKED BY: A. BOMBARDIER |
| IPARM NAME: de060xsl1 | SHEET 43 OF 63 |