



200+80

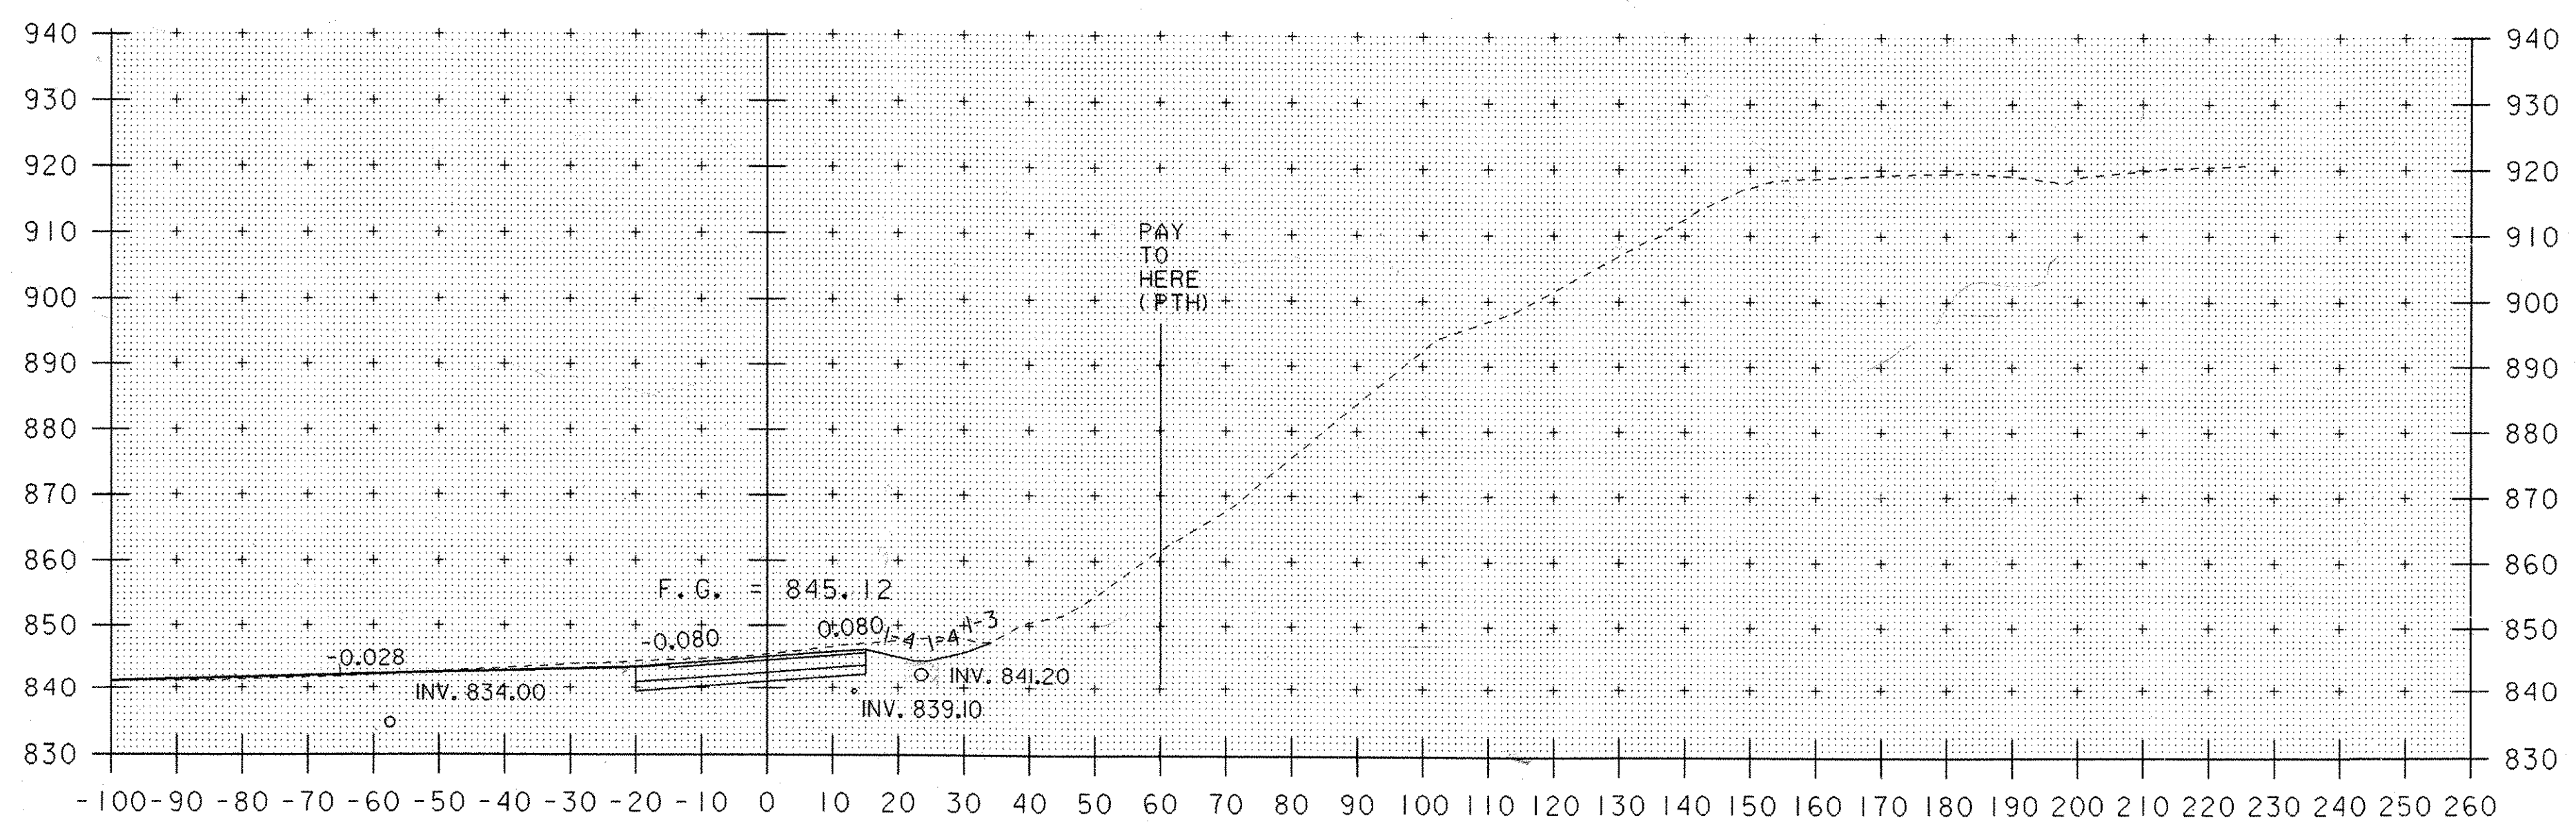

200+60

SEE FINAL SECTIONS PLOT DATE 11-20-06
 FOR PLANIMETERED AREAS, STATIONS 200+60 ~ 203+00,
 (COMMON EXCAVATION, STONE FILL TYPE III AND STONE FILL TYPE II)

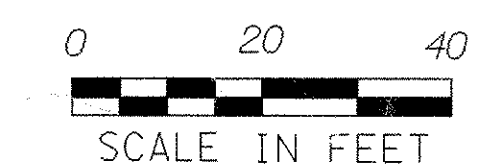

STA. 200+60 TO STA. 200+80

PROJECT NAME: HARDWICK	PLOT DATE: 18-OCT-2005
PROJECT NUMBER: STP ST 030-3(4)	DRAWN BY: M. NUTTER
FILE NAME: d04e060xslx.dgn	CHECKED BY: A. BOMBARDIER
PROJECT LEADER: A. BOMBARDIER	SHEET 44 OF 63
DESIGNED BY: M. NUTTER	
IPARM NAME: de060xsl2.l	