



SEE FINAL SECTIONS PLOT DATE 11-20-06

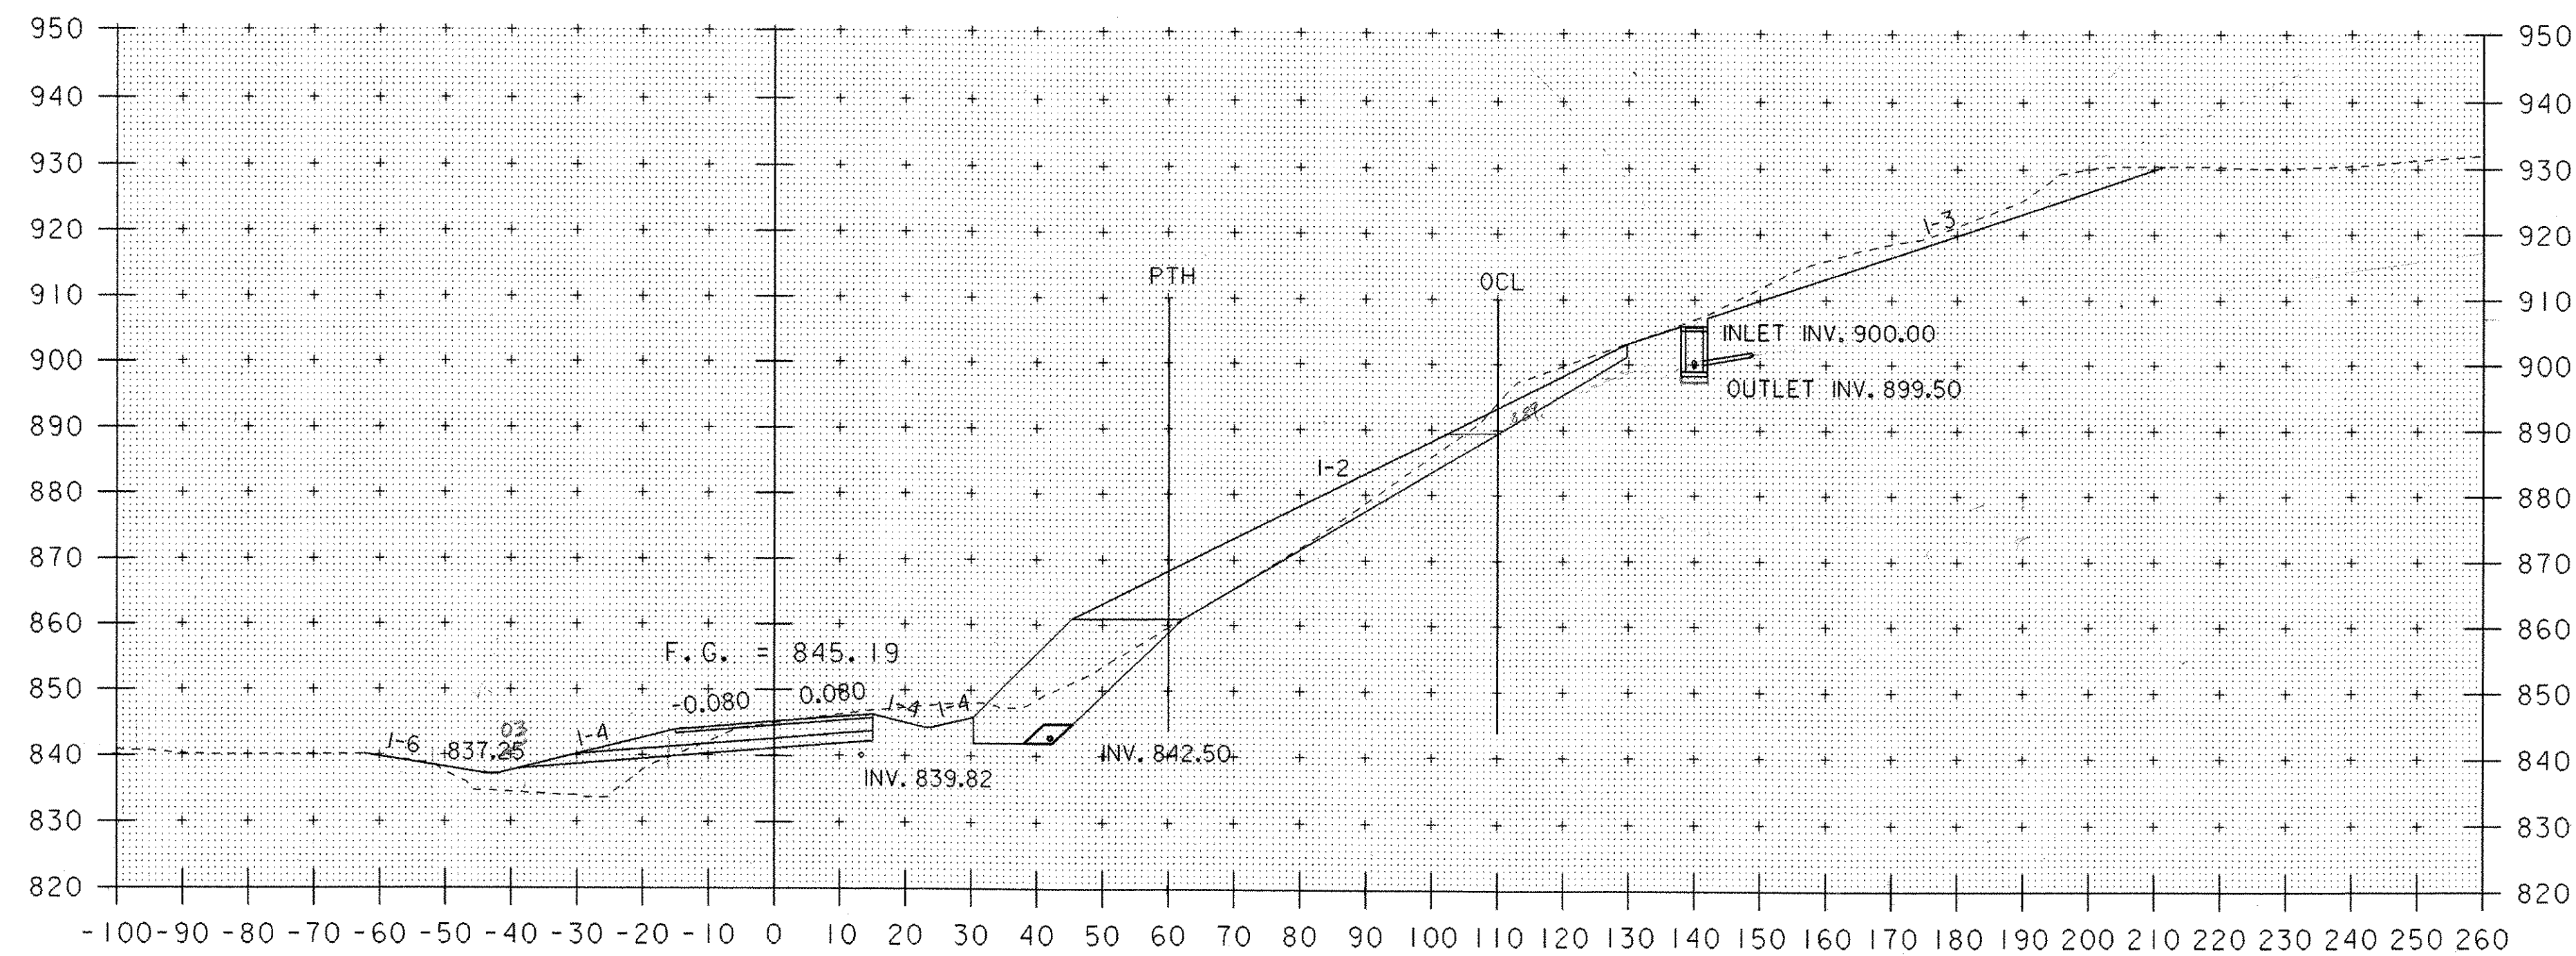

201+20

TRENCH EARTH - DI @ 140 BT @ 1:2.07
 6' W x 6' L x 50' DEEP = 667 CY
 15' (6' W x 6' L x 4.5' DEEP) = 90 CY
 15.67 CY / 11 RM 1-7-07

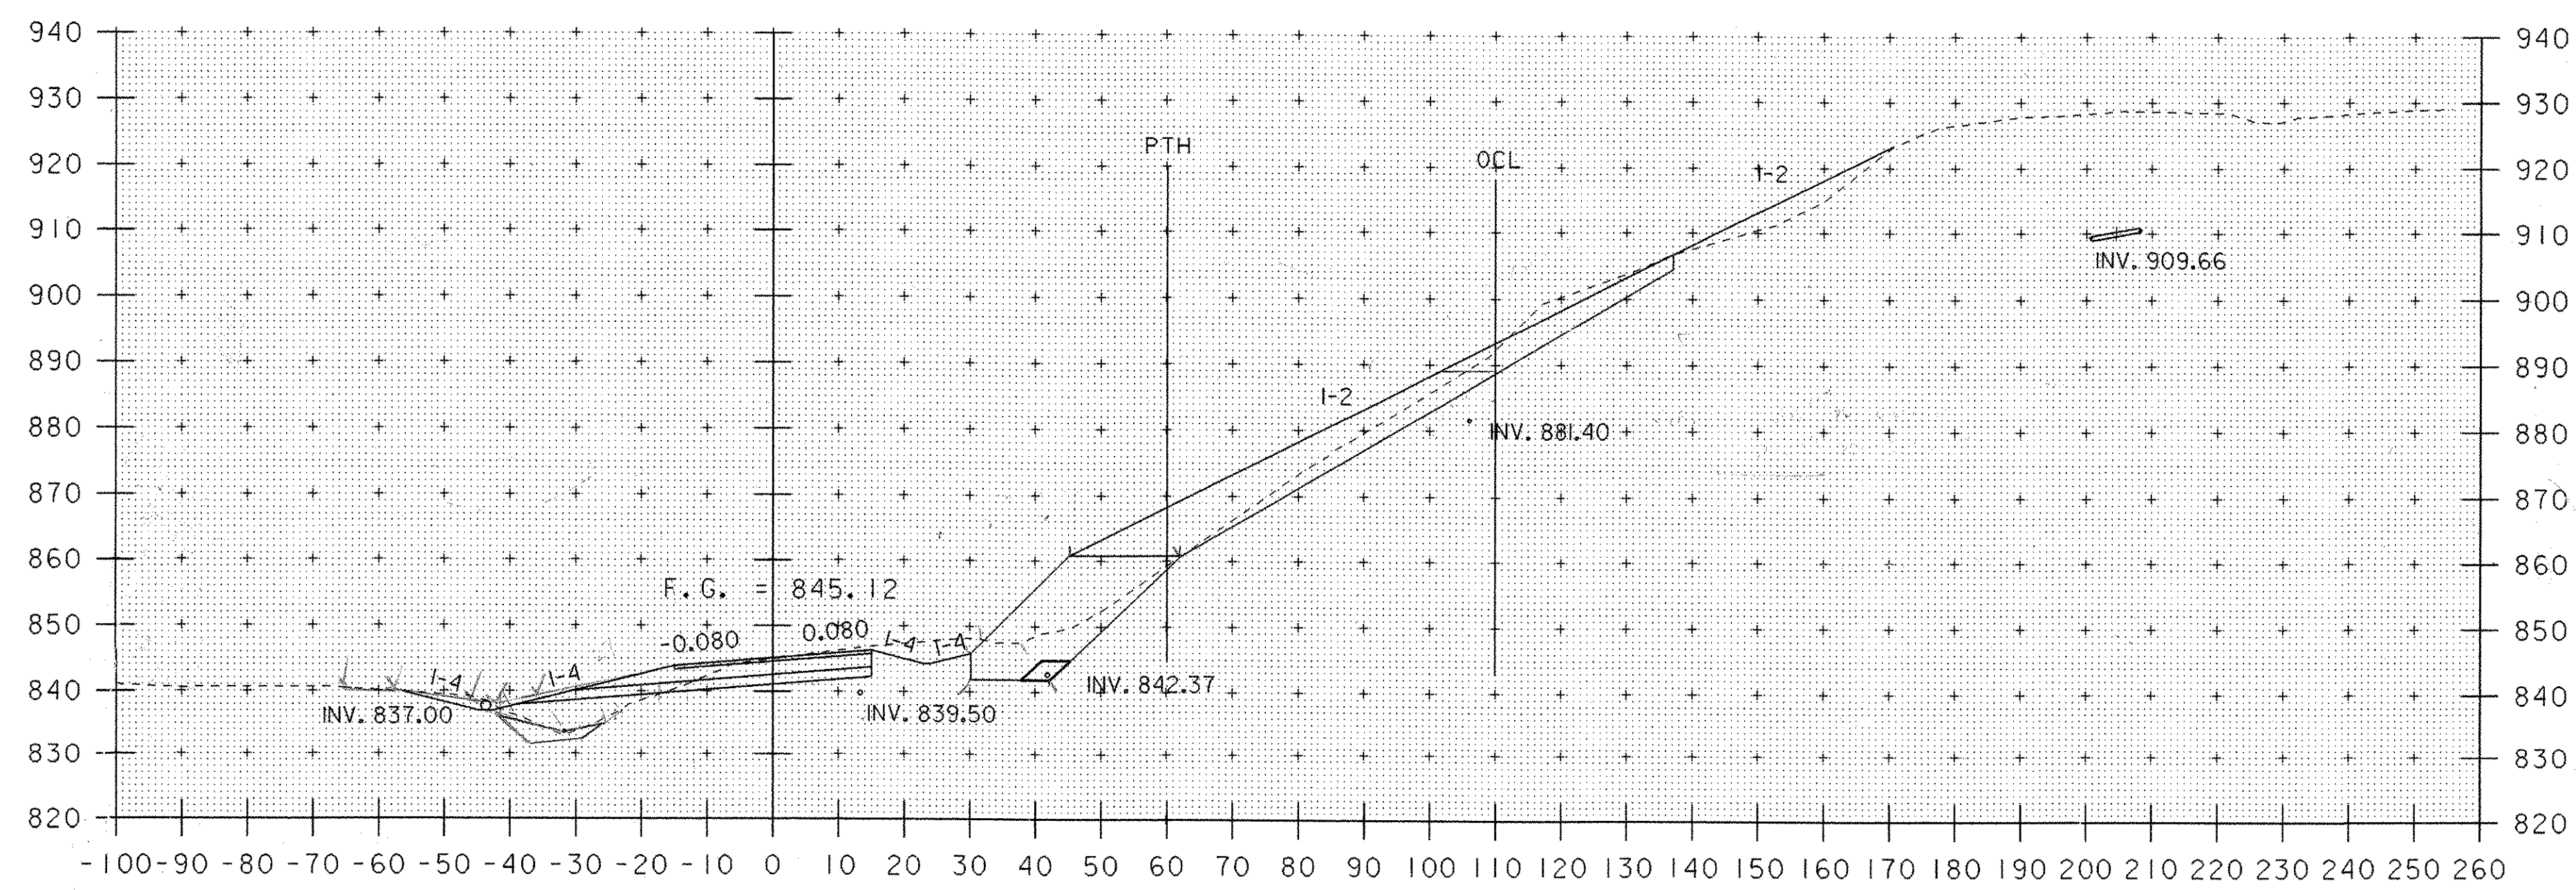

201+00

MUCK (45)
 45
 45 / 0.16 = 281.3 FT =
 45
 45
 LJM
 KRM 1-10-07



STA. 201+00 TO STA. 201+20

PROJECT NAME: HARDWICK	PLOT DATE: 18-OCT-2005
PROJECT NUMBER: STP ST 030-3(4)	DRAWN BY: M. NUTTER
FILE NAME: d04e060xslx.dgn	CHECKED BY: A. BOMBARDIER
PROJECT LEADER: A. BOMBARDIER	SHEET 45 OF 63
DESIGNED BY: M. NUTTER	
IPARM NAME: de060xst3.1	