

UPDATED GROUND SURVEY
MAY 2006 USED FOR COMMON

COMMON KRM 12-14-06
MAINLINE 110' LT TO THE PTH LINE @ 60' RT
45' 45
90 45.75
46 46.5
93 46.5

STONE FILL TYPE III KRM 1-2-07
MAINLINE 110' LT TO THE PTH @ 60' RT
46 47
94 46.5
46 46
92 46

STONE FILL TYPE II KRM 1-2-07
MAINLINE 110' LT TO PTH @ 60' RT
8
16 8
7 8
16 8

PTH @ 60' RT TO 260' RT
37 37.5
75 37.5
38 37.5
75 37.5

PTH @ 60' RT TO 260' RT
SCALED 1/2(2' X 2') = 2 FT²

PTH @ 60' RT TO 260' RT
62 62
124 61.75
61 61.5
123 61.5


$$\frac{45.75}{0.16} = 285.94 \text{ FT}^2$$

$$\frac{46.5}{0.16} = 290.63 \text{ FT}^2$$

$$\frac{8}{0.16} = 50.0 \text{ FT}^2$$

$$\frac{37.5}{0.16} = 234.38 \text{ FT}^2$$

201+20

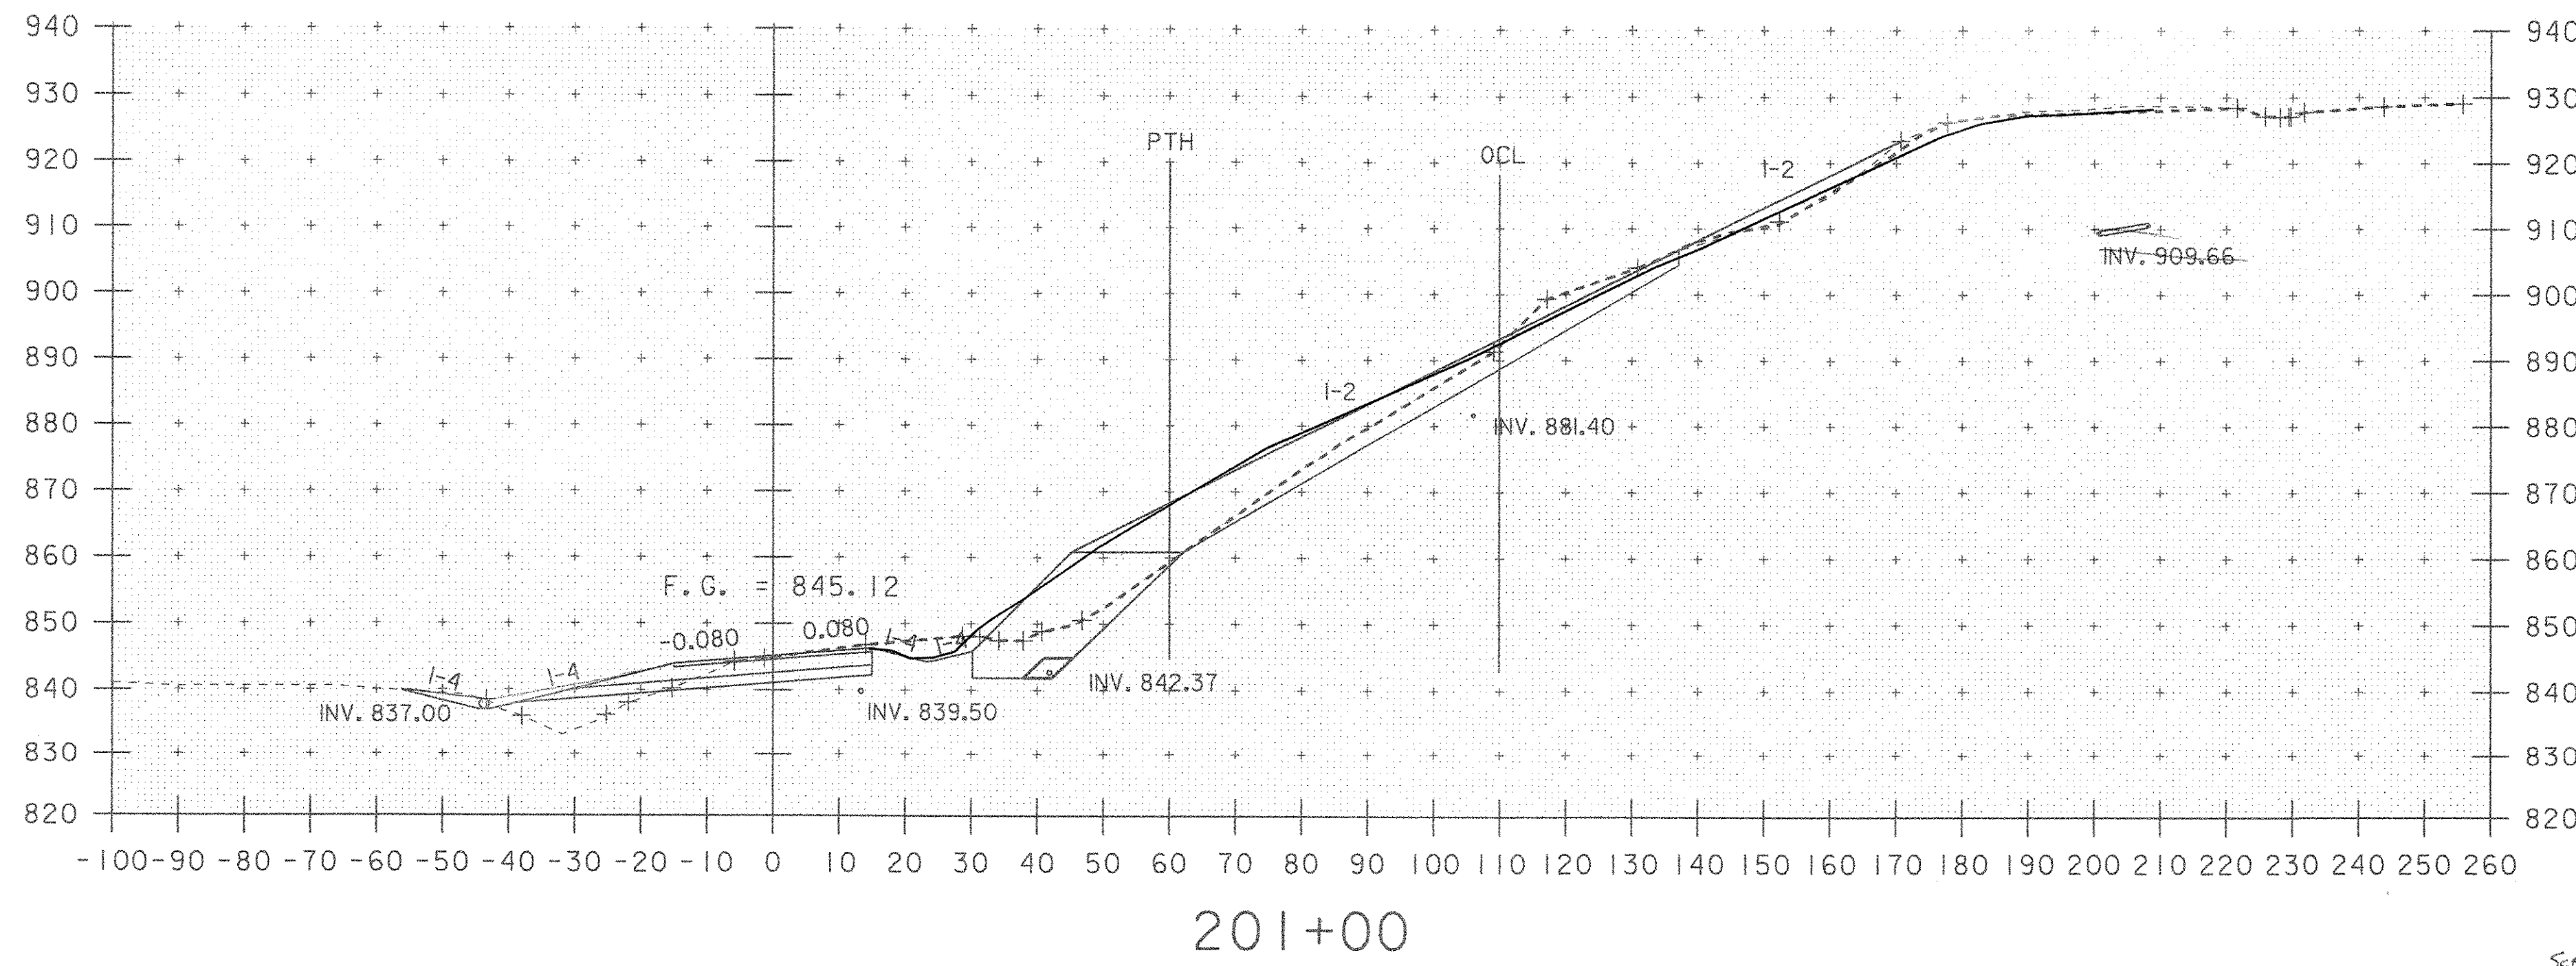

UPDATED GROUND SURVEY
MAY 2006 USED FOR COMMON

COMMON KRM 12-14-06
MAINLINE 110' LT TO THE PTH LINE @ 60' RT
45 45.5
91 46.0
46 46.5
93 46.5

STONE FILL TYPE III KRM 1-2-07
MAINLINE 110' LT TO PTH @ 60' RT
48 48
96 48
48 48
96 48

STONE FILL TYPE II KRM 1-2-07
MAINLINE 110' LT TO PTH @ 60' RT
7 7
14 7
14 7
14 7

PTH @ 60' RT TO 260' RT
38 38
76 38
37 38
76 38

PTH @ 60' RT TO 260' RT
SCALED 1/2(2' X 2') = 2 FT²

PTH @ 60' RT TO 260' RT
68 67.5
135 67.5
67 67
134 67

$$\frac{46.0}{0.16} = 287.50 \text{ FT}^2$$


$$\frac{48}{0.16} = 300.00 \text{ FT}^2$$

$$\frac{7}{0.16} = 43.75 \text{ FT}^2$$

$$\frac{38}{0.16} = 237.50 \text{ FT}^2$$

201+00

SCALE TO CHECK
1/2(2' X 7.2') = 43.2 FT²

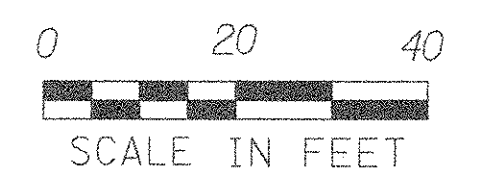

PROJECT NAME:	HARDWICK	FILE NAME:	d04e060xsix.dgn	PLOT DATE:	20-NOV-2006
PROJECT NUMBER:	STP ST 030-3(4)	PROJECT LEADER:	A. BOMBARDIER	DRAWN BY:	M. NUTTER
		DESIGNED BY:	M. NUTTER	CHECKED BY:	A. BOMBARDIER
		IPARM NAME:	de060xsl3.1	SHEET	45 A OF 63