



SEE FINAL SECTIONS PLOT DATE 11-20-06

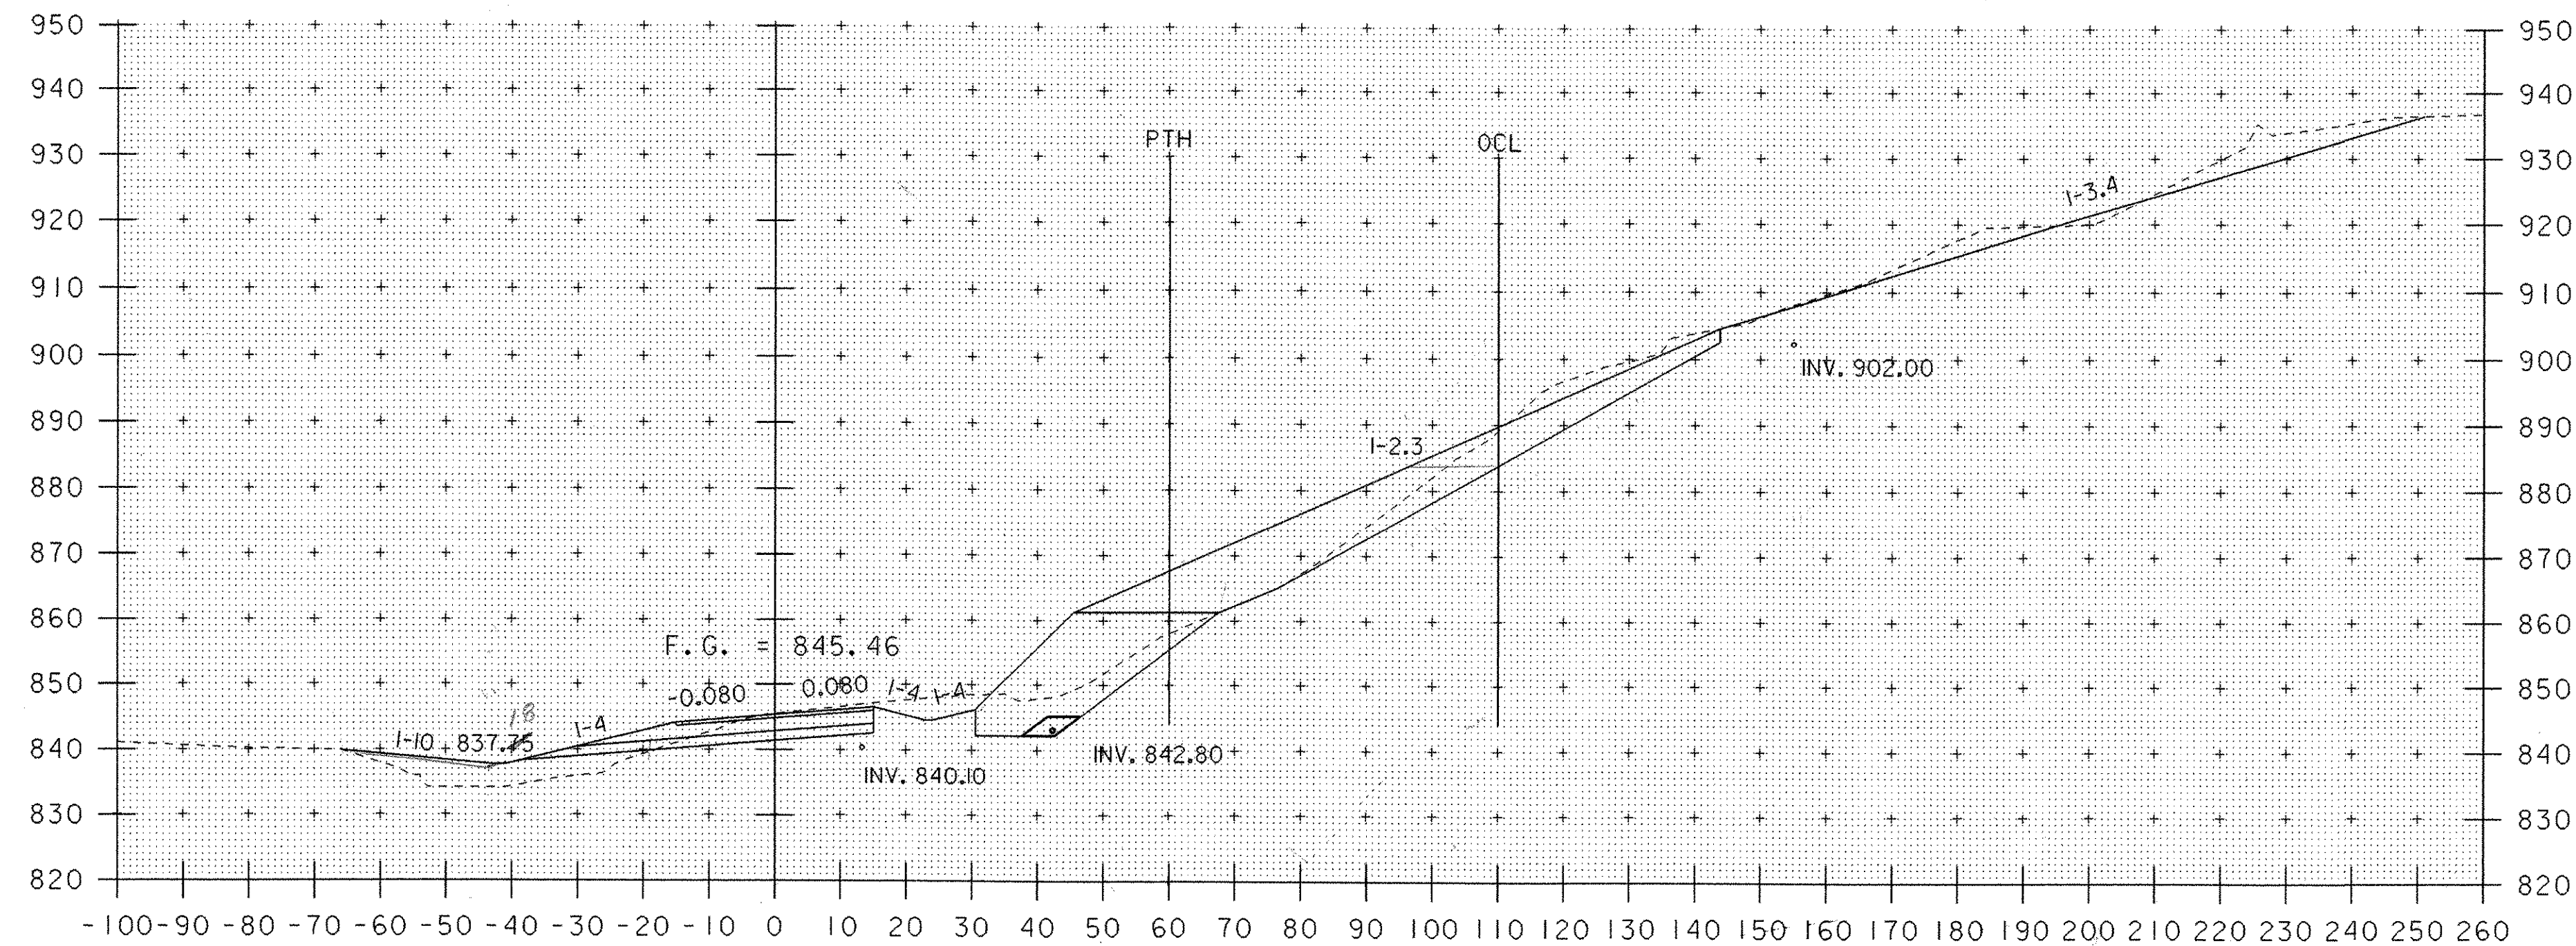


201+60

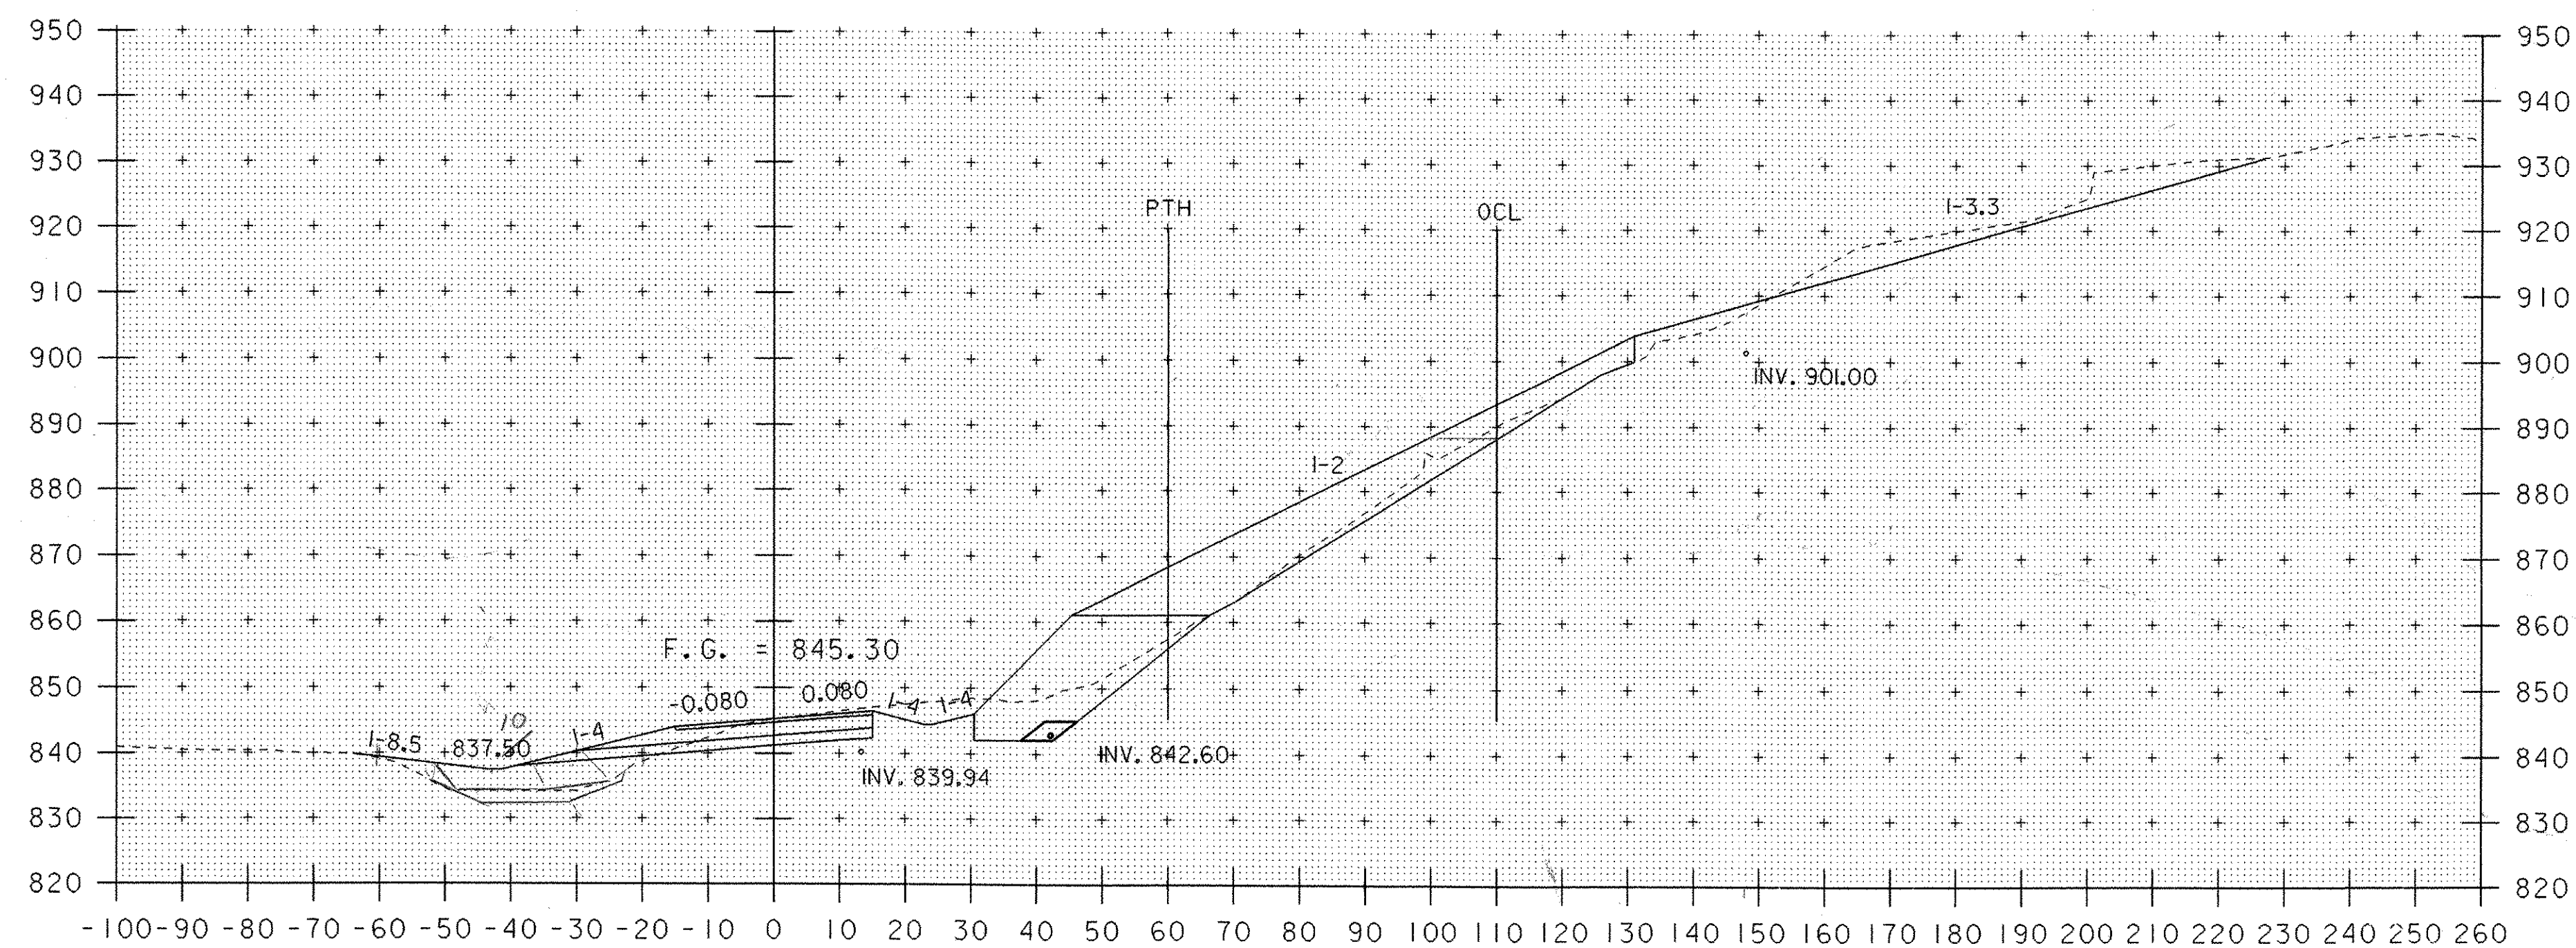

201+40

Muck  
 8  
 16  
 8  
 16  
 $8/0.16 = 50' \text{ ft}^2$   
 LTH  
 KRM 11-10-07

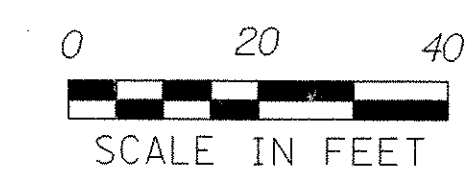

PROJECT NAME: HARDWICK	PLOT DATE: 18-OCT-2005
PROJECT NUMBER: STP ST 030-3(4)	DRAWN BY: M. NUTTER
FILE NAME: d04e060xslx.dgn	CHECKED BY: A. BOMBARDIER
DESIGNED BY: M. NUTTER	SHEET 46 OF 63
IPARM NAME: de060xsl4.1	

STA. 201+40 TO STA. 201+60