



SEE FINAL SECTIONS PLOT DATE 11-20-06
 FOR COMMON, STONE FILL III & III,
 COMMON AREA FOR 42' LT TO 70' LT KRM 12-27-06

8
 15 7.5
 8 7.75 = 48.44 FT²
 16 8

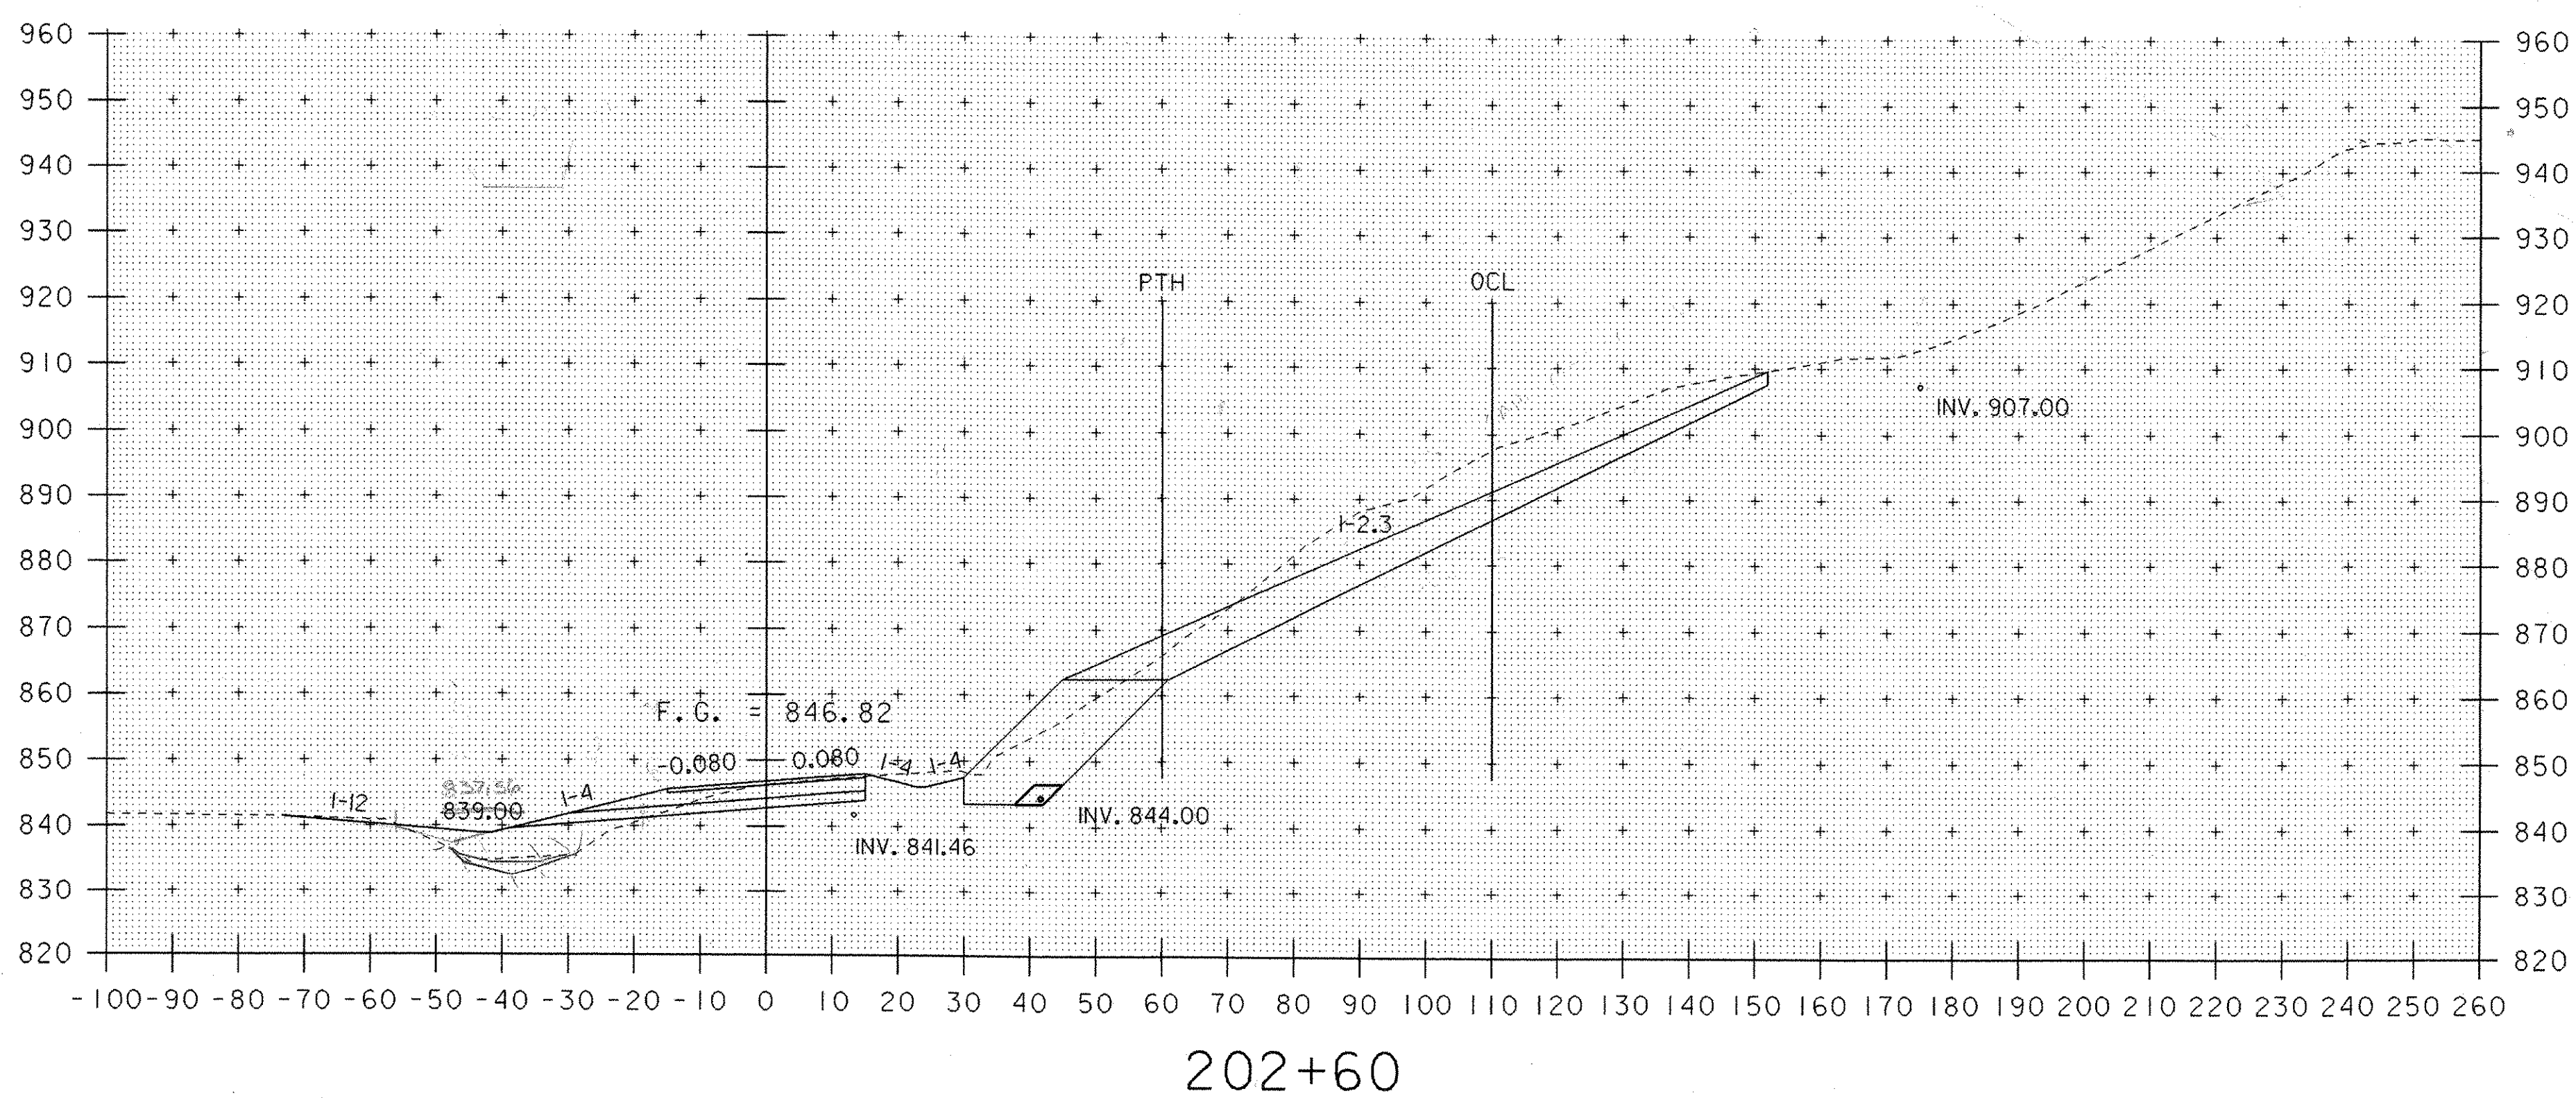

Much 3
 3 325/0.16 = 2031 FT²
 2 35

SEE FINAL SECTIONS PLOT DATE 11-20-06
 FOR COMMON, STONE FILL III & III,
 COMMON AREA FOR 58' LT TO 72' LT KRM 12-27-06
 1 1 1/16 = 6.25 FT²
 2 1 1/16

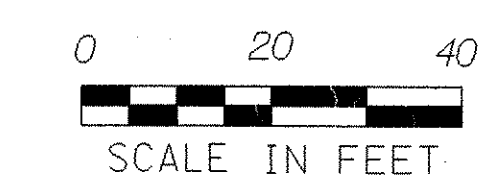

STA. 202+60 TO STA. 202+80

PROJECT NAME: HARDWICK	PLOT DATE: 18-OCT-2005
PROJECT NUMBER: STP ST 030-3(4)	DRAWN BY: M. NUTTER
FILE NAME: d04e060xslx.dgn	CHECKED BY: A. BOMBARDIER
DESIGNED BY: M. NUTTER	SHEET 49 OF 63
IPARM NAME: de060xsl7.1	