



SEE FINAL SECTIONS PLOT DATE 11-20-06

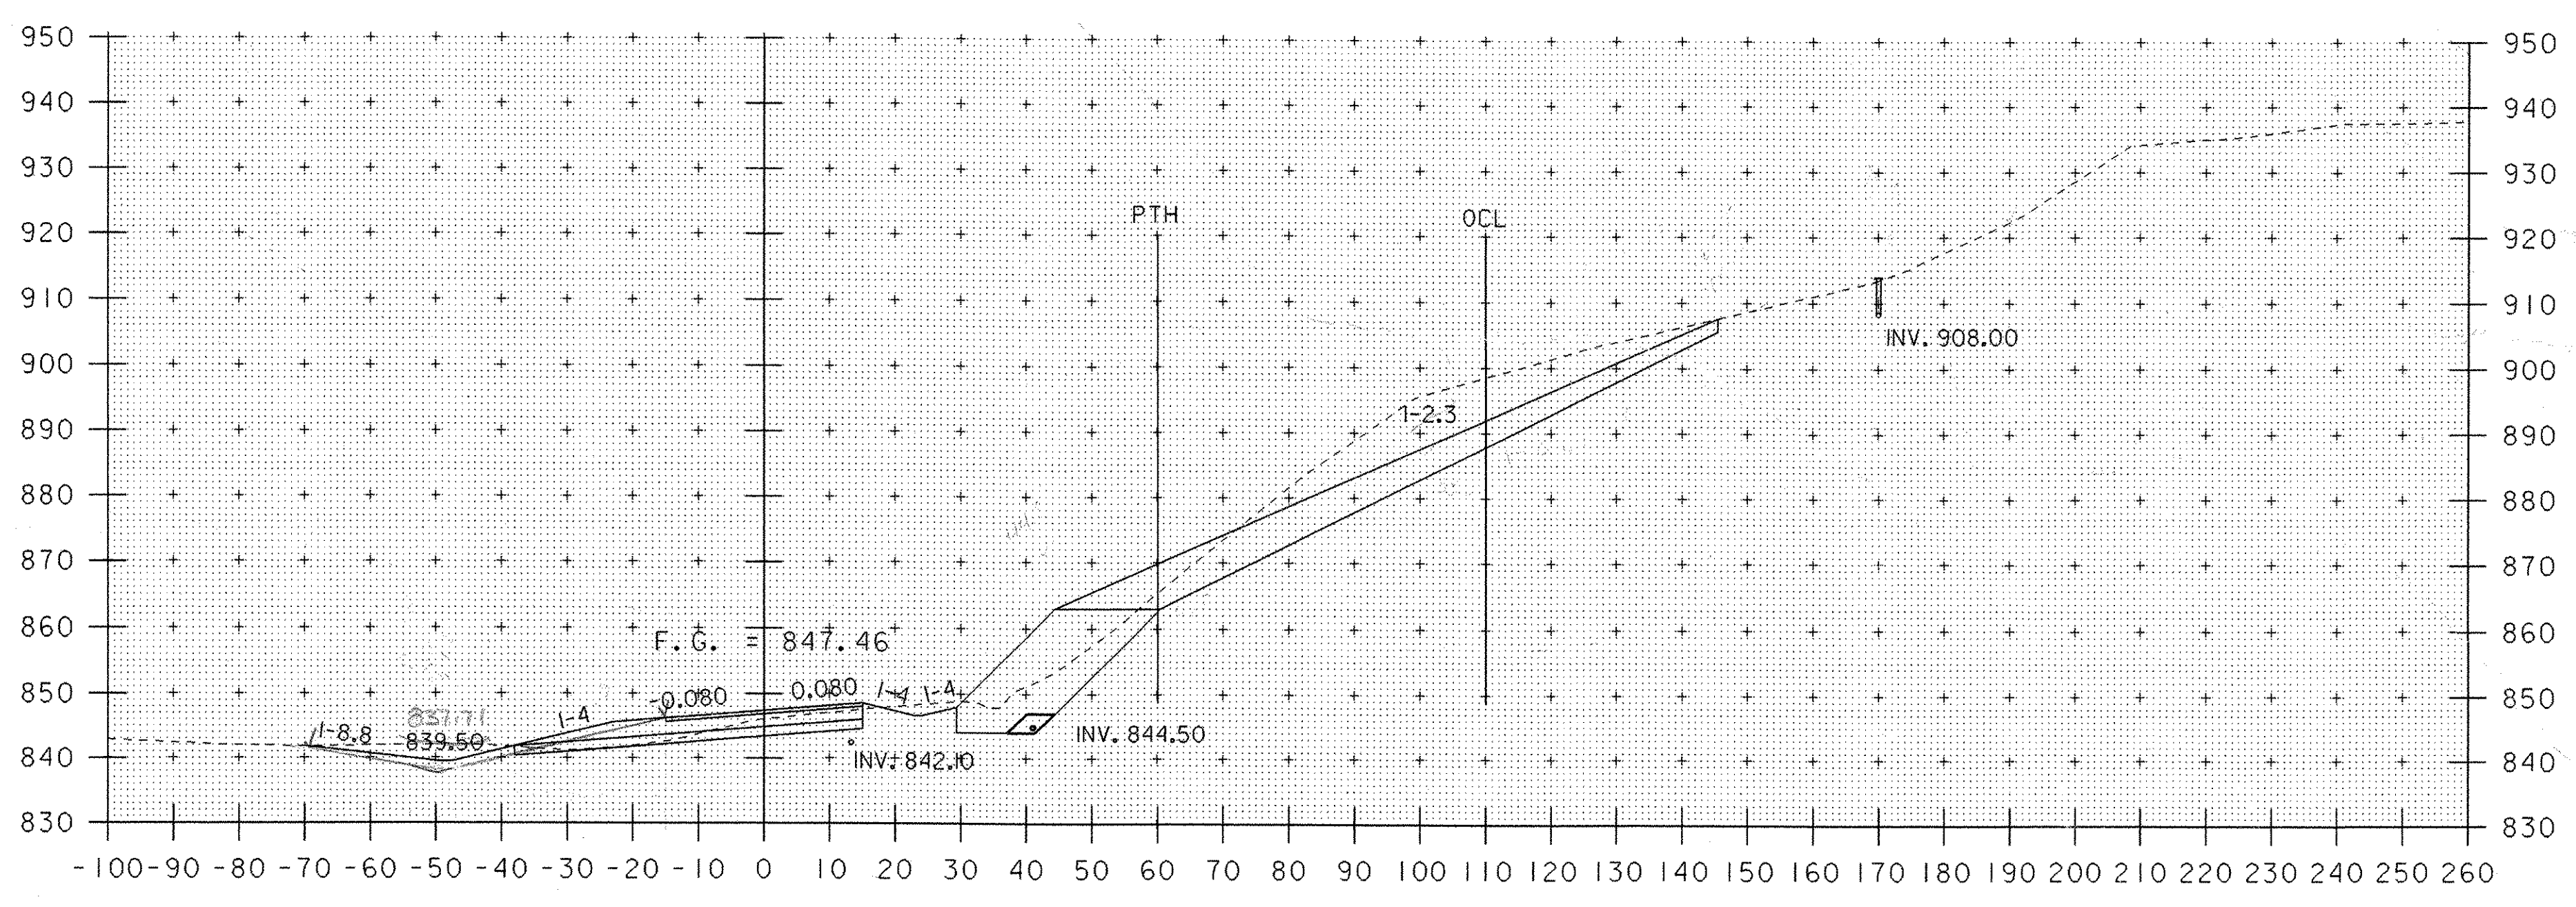

SEE FINAL SECTIONS PLOT DATE 11-20-06 FOR COMMON, STONE FALL III & II
 PLANIMETERED AREAS,
 COMMON AREA FOR 20' LT TO 70' LT. Rem 12-27-06
 CJJ 12-07

11	
20	10
10	$\frac{10}{0.16} = 62.50 \text{ FT}^2$
20	10

203+00

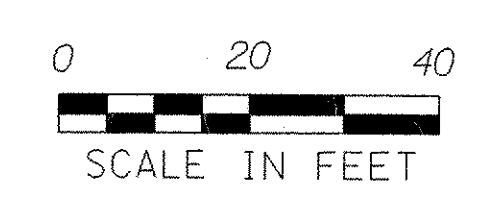

STA. 203+00 TO STA. 203+00

PROJECT NAME: HARDWICK	
PROJECT NUMBER: STP ST 030-3(4)	
FILE NAME: d04e060xslx.dgn	PLOT DATE: 18-OCT-2005
PROJECT LEADER: A. BOMBARDIER	DRAWN BY: M. NUTTER
DESIGNED BY: M. NUTTER	CHECKED BY: A. BOMBARDIER
IPARM NAME: de060xsl8.1	SHEET 50 OF 63