


Common KRM 12-27-06
 132 131
 262
 $\frac{131}{0.104} = 204.69' FT$
 131 131
 262

Common KRM 12-28-06
 PTH @ 60' RT TO 260' RT 0' FT

STONE FILL TYPE II / III KRM 1-3-07 0' FT
 SEE PLAN SHEET 14 OF 63

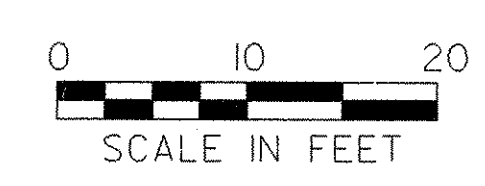

PROJECT NAME: HARDWICK
 PROJECT NUMBER: STP ST 030-3(4)
 FILE NAME: d04e060xslx.dgn
 PROJECT LEADER: A. BOMBARDIER
 DESIGNED BY: M. NUTTER
 IPARM NAME: de060xsl9.1
 PLOT DATE: 18-OCT-2005
 DRAWN BY: M. NUTTER
 CHECKED BY: A. BOMBARDIER
 SHEET 51 OF 63

STA. 203+20 TO STA. 203+20