


203+80

Common Rem 12-28-06  
 WJ 1-2-07  
 35 35  
 70 35  
 36 35  
 70 35  
 $\frac{35}{0.69} = 54.69 \text{ FT}^2$

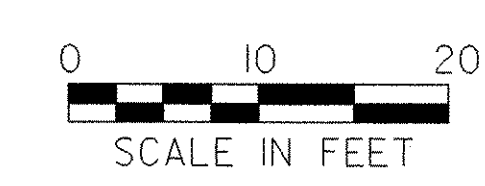

STA. 203+80 TO STA. 203+80

PROJECT NAME: HARDWICK	PLOT DATE: 18-OCT-2005
PROJECT NUMBER: STP ST 030-3(4)	DRAWN BY: M. NUTTER
FILE NAME: d04e060xslx.dgn	CHECKED BY: A. BOMBARDIER
PROJECT LEADER: A. BOMBARDIER	SHEET 54 OF 63
DESIGNED BY: M. NUTTER	
IPARM NAME: de060xs22.i	