



Common KRM 12-28-06
 24 25
 50
 23 24
 48
 $\frac{24.5}{0.04} = 38.28 \text{ FT}^2$

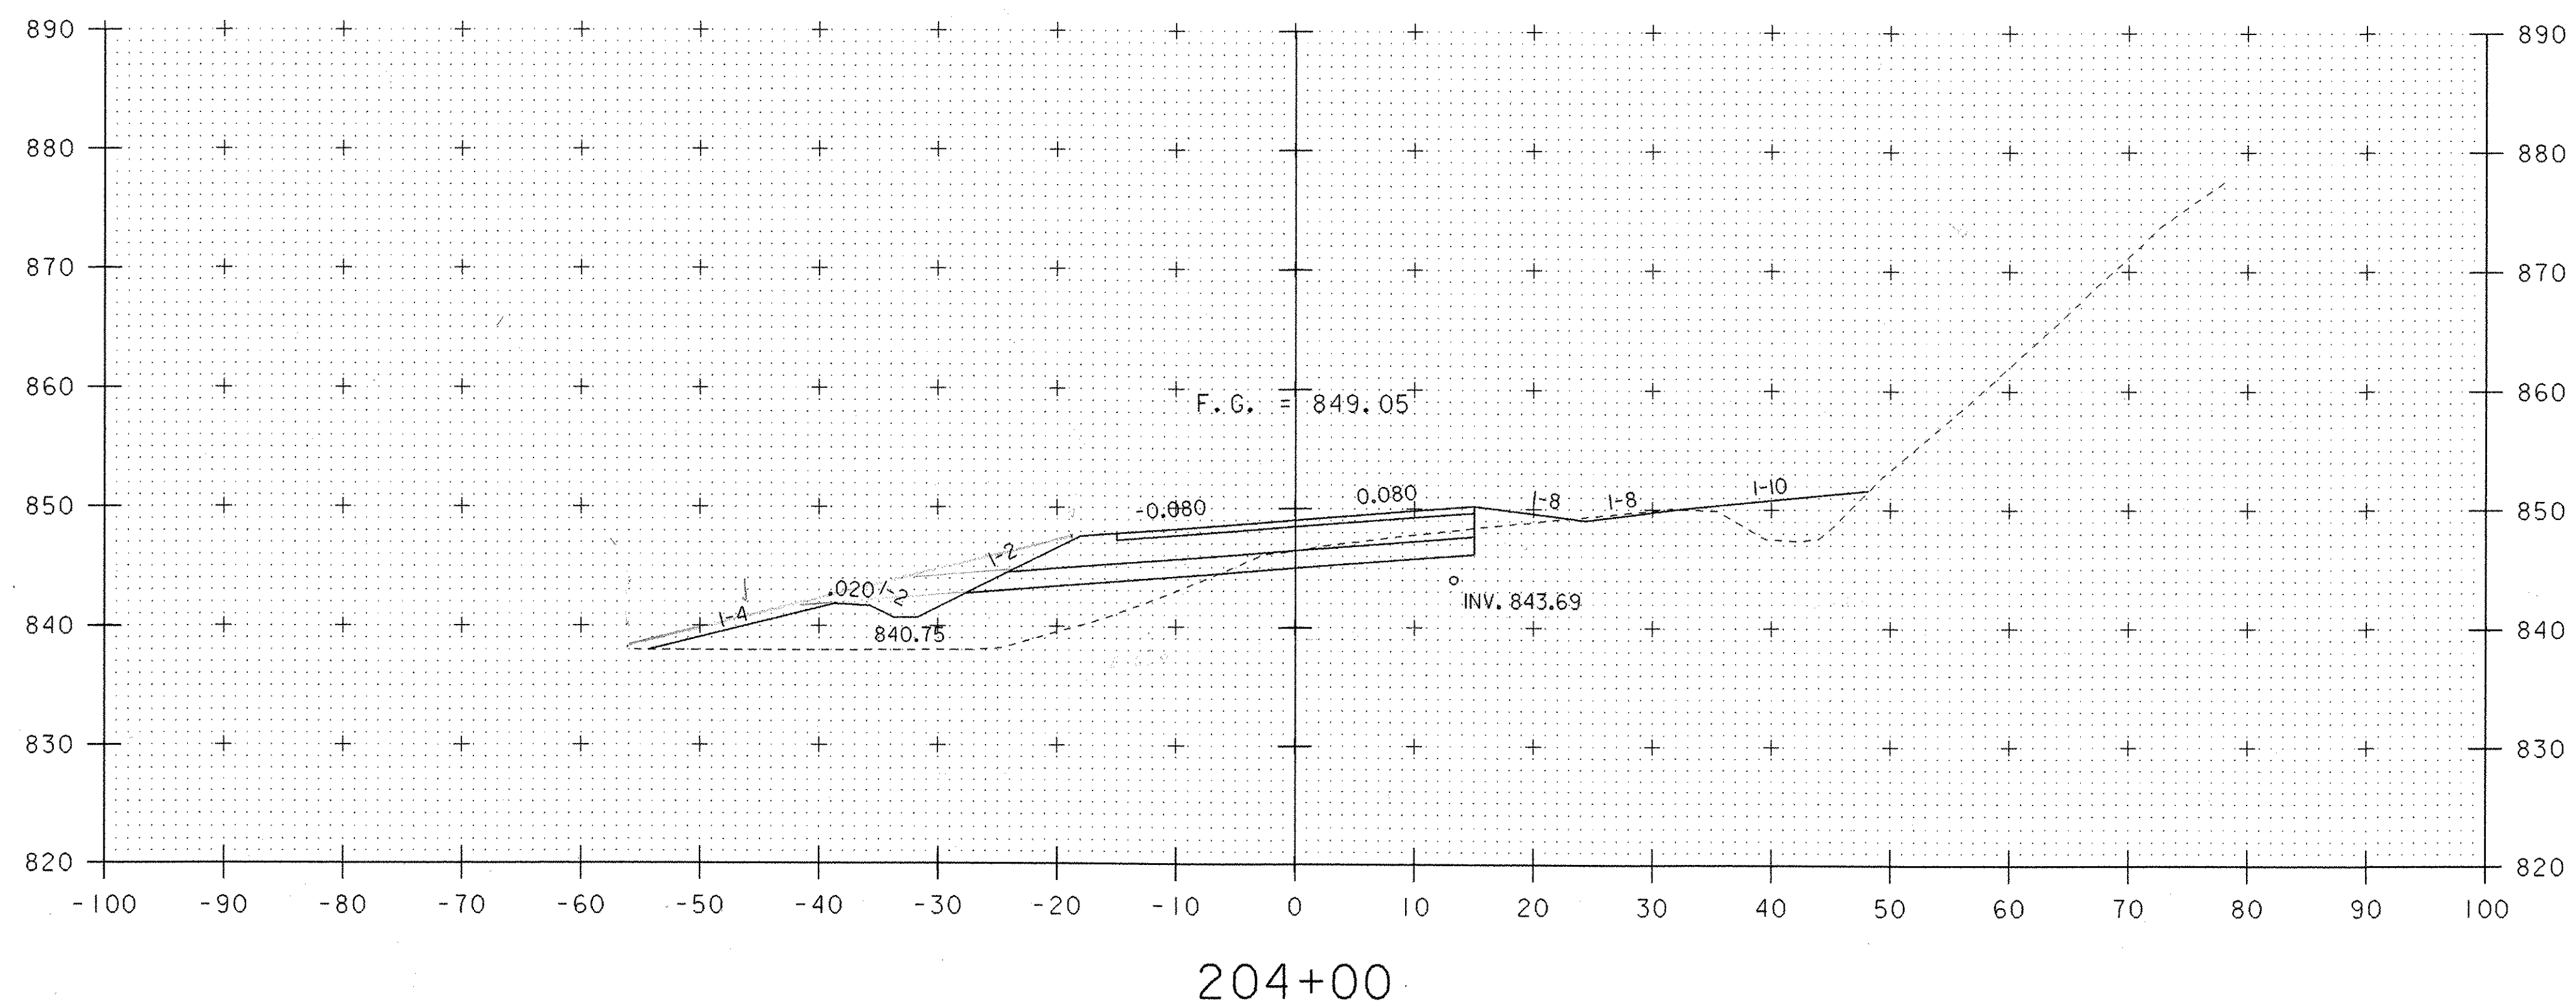

Common KRM 12-28-06
 23 24
 48
 24 24
 48
 $\frac{24}{0.04} = 37.50 \text{ FT}^2$

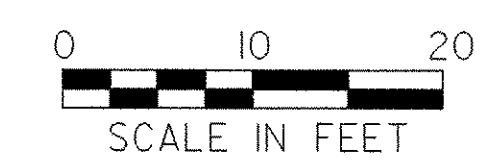

STA. 204+00 TO STA. 204+20

PROJECT NAME: HARDWICK
 PROJECT NUMBER: STP ST 030-3(4)

FILE NAME: d04e060xslx.dgn
 PROJECT LEADER: A. BOMBARDIER
 DESIGNED BY: M. NUTTER
 IPARM NAME: de060xs23.j

PLOT DATE: 18-OCT-2005
 DRAWN BY: M. NUTTER
 CHECKED BY: A. BOMBARDIER
 SHEET 55 OF 63