



204+60

COMMON KRM 12-28-00  
 (3) 1-2-01  
 38 38  
 76 38  
 $\frac{38}{0.64} = 59.38 \text{ FT}^2$   
 38 38  
 76 38

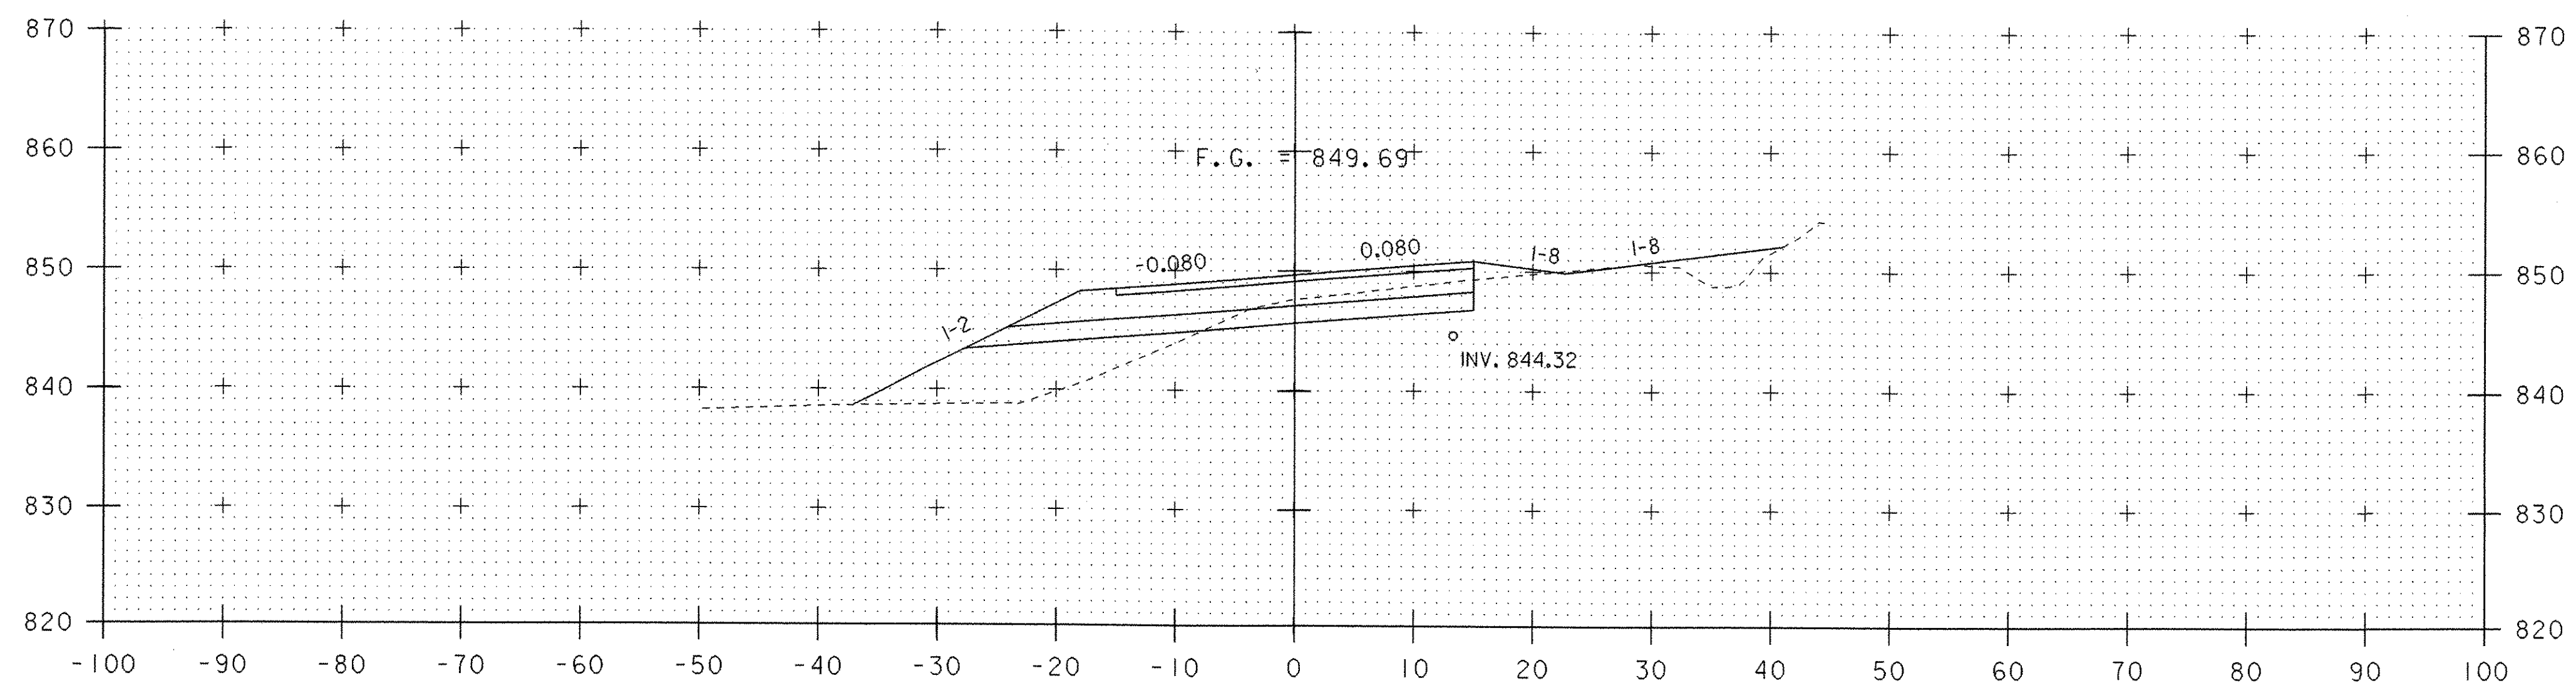

204+40

COMMON KRM 12-28-00  
 (3) 12-29-06  
 29 28.5  
 57 28.5  
 $\frac{28.75}{0.64} = 44.92 \text{ FT}^2$   
 29 29  
 58 29

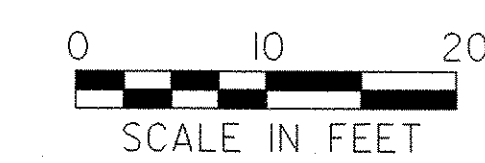

STA. 204+40 TO STA. 204+60

PROJECT NAME: HARDWICK  
 PROJECT NUMBER: STP ST 030-3(4)  
 FILE NAME: d04e060xslx.dgn PLOT DATE: 18-OCT-2005  
 PROJECT LEADER: A. BOMBARDIER DRAWN BY: M. NUTTER  
 DESIGNED BY: M. NUTTER CHECKED BY: A. BOMBARDIER  
 PARM NAME: de060xs24.i SHEET 56 OF 63