



205+00

Common KRM 12-28-06
 (3) 1 2 07
 47 46.5
 93 $\frac{46.75}{0.64} = 73.05 \text{ FT}^2$
 47 47.0
 94

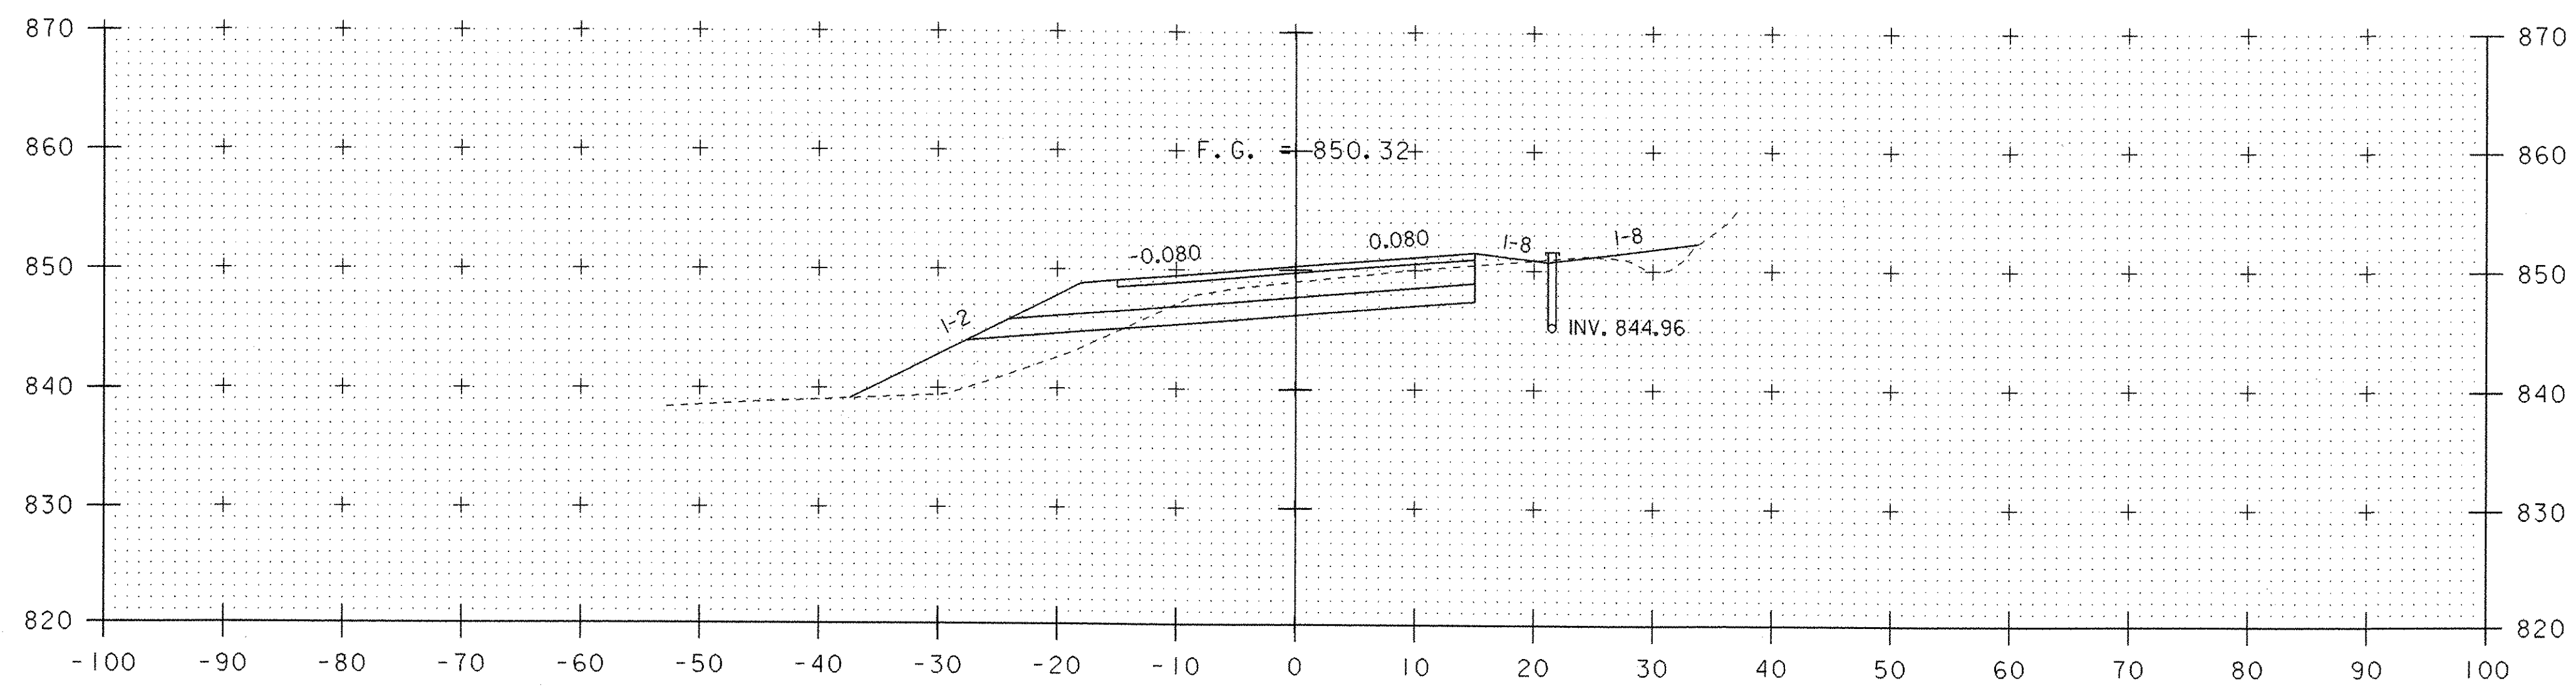

204+80

Common KRM 12-28-06
 48 47.5
 95 $\frac{47.5}{2.64} = 17.99 \text{ FT}^2$
 47 47.5
 95

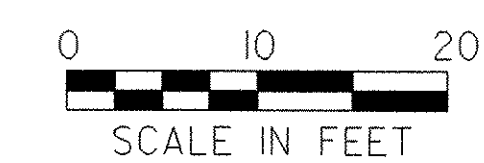

STA. 204+80 TO STA. 205+00

PROJECT NAME: HARDWICK	PLOT DATE: 18-OCT-2005
PROJECT NUMBER: STP ST 030-3(4)	DRAWN BY: M. NUTTER
FILE NAME: d04e060xslx.dgn	CHECKED BY: A. BOMBARDIER
PROJECT LEADER: A. BOMBARDIER	SHEET 57 OF 63
DESIGNED BY: M. NUTTER	
IPARM NAME: de060xs25.1	