


205+40

COMMON KRM 12-28-00  
 35  
 71 35.5  
 33 34.5  
 69  
 $\frac{350}{0.64} = 54.69 \text{ FT}^2$

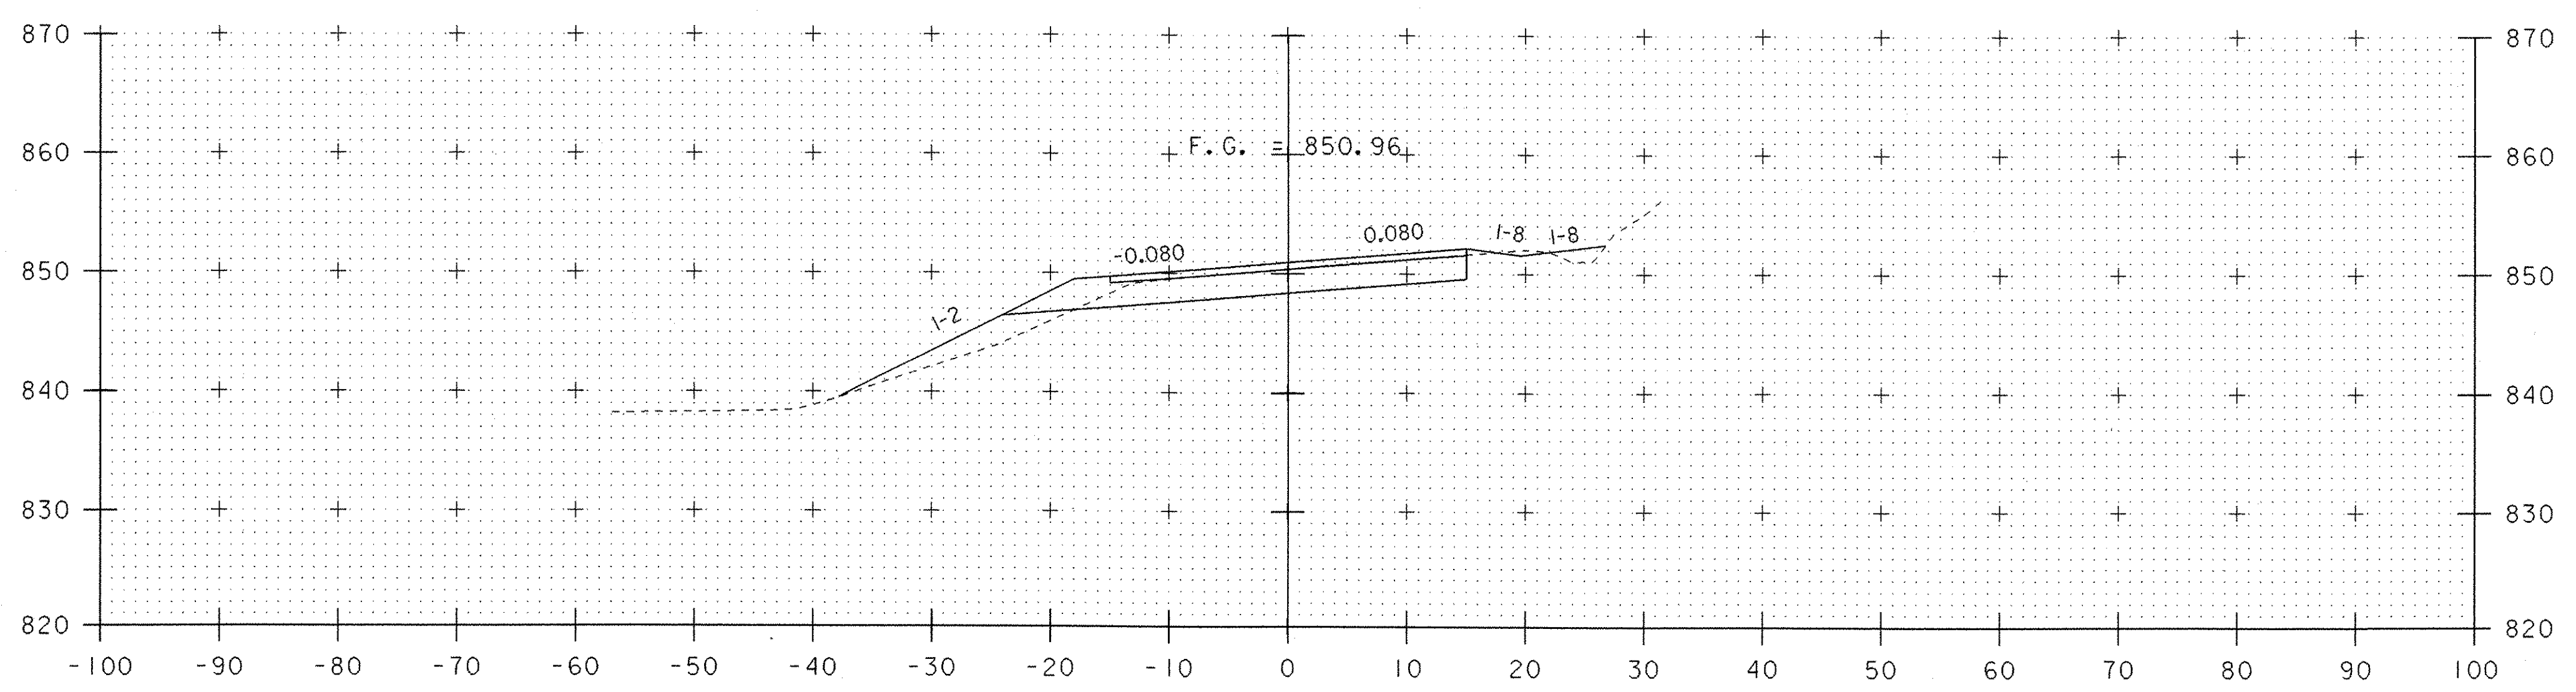

205+20

COMMON KRM 12-28-00  
 40  
 80 40  
 39 40  
 80  
 $\frac{40}{0.64} = 62.50 \text{ FT}^2$



STA. 205+20 TO STA. 205+40

PROJECT NAME: HARDWICK	
PROJECT NUMBER: STP ST 030-3(4)	
FILE NAME: d04e060xslx.dgn	PLOT DATE: 18-OCT-2005
PROJECT LEADER: A. BOMBARDIER	DRAWN BY: M. NUTTER
DESIGNED BY: M. NUTTER	CHECKED BY: A. BOMBARDIER
IPARM NAME: de060xs26.1	SHEET 58 OF 63