



206+60

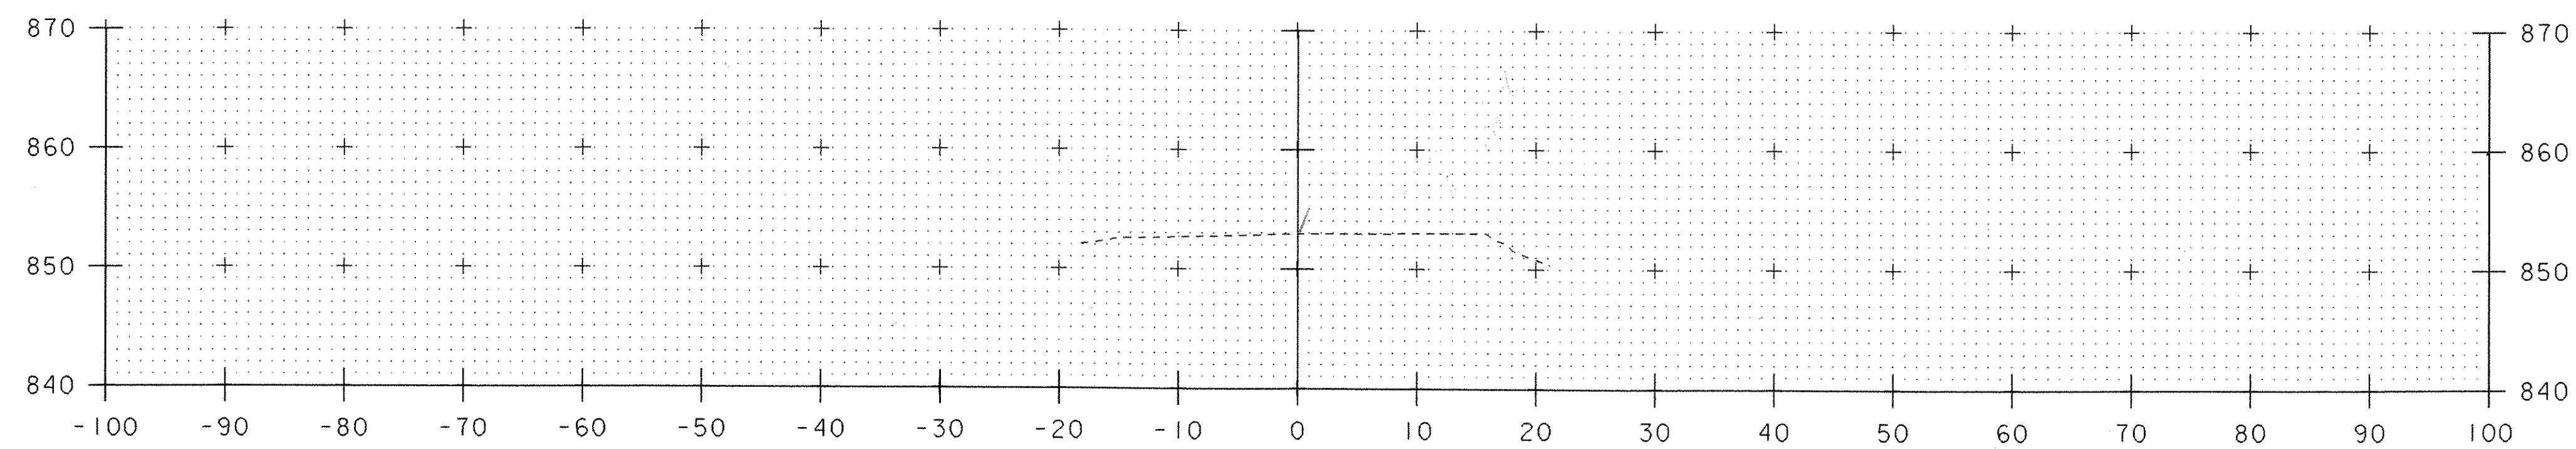

206+40

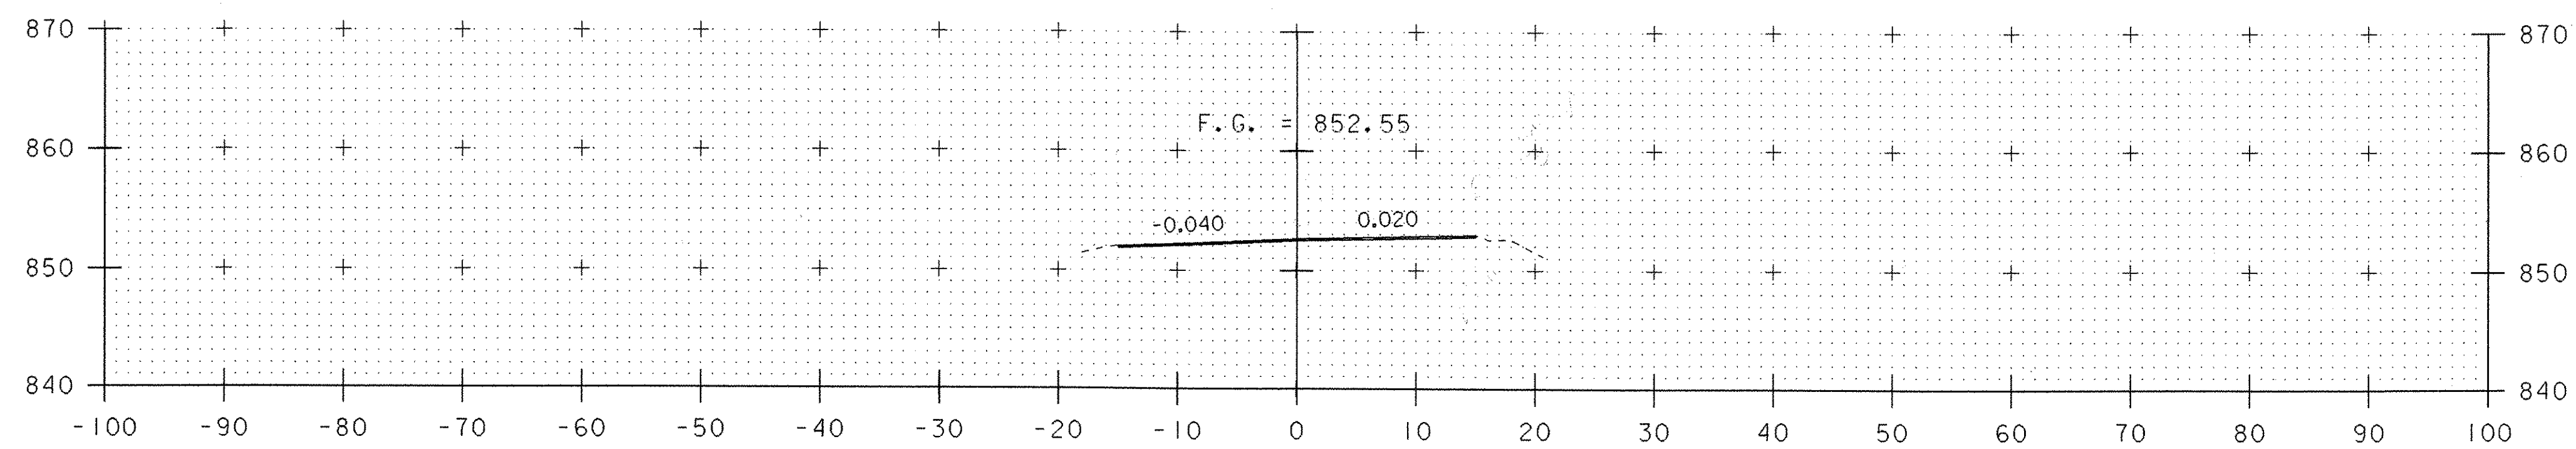

206+20

MATCH EXISTING



STA. 206+20 TO STA. 206+60

PROJECT NAME: HARDWICK
PROJECT NUMBER: STP ST 030-3(4)

FILE NAME: d04e060xslx.dgn	PLOT DATE: 18-OCT-2005
PROJECT LEADER: A. BOMBARDIER	DRAWN BY: M. NUTTER
DESIGNED BY: M. NUTTER	CHECKED BY: A. BOMBARDIER
IPARM NAME: de060xs28.i	SHEET 60 OF 63