




309+00

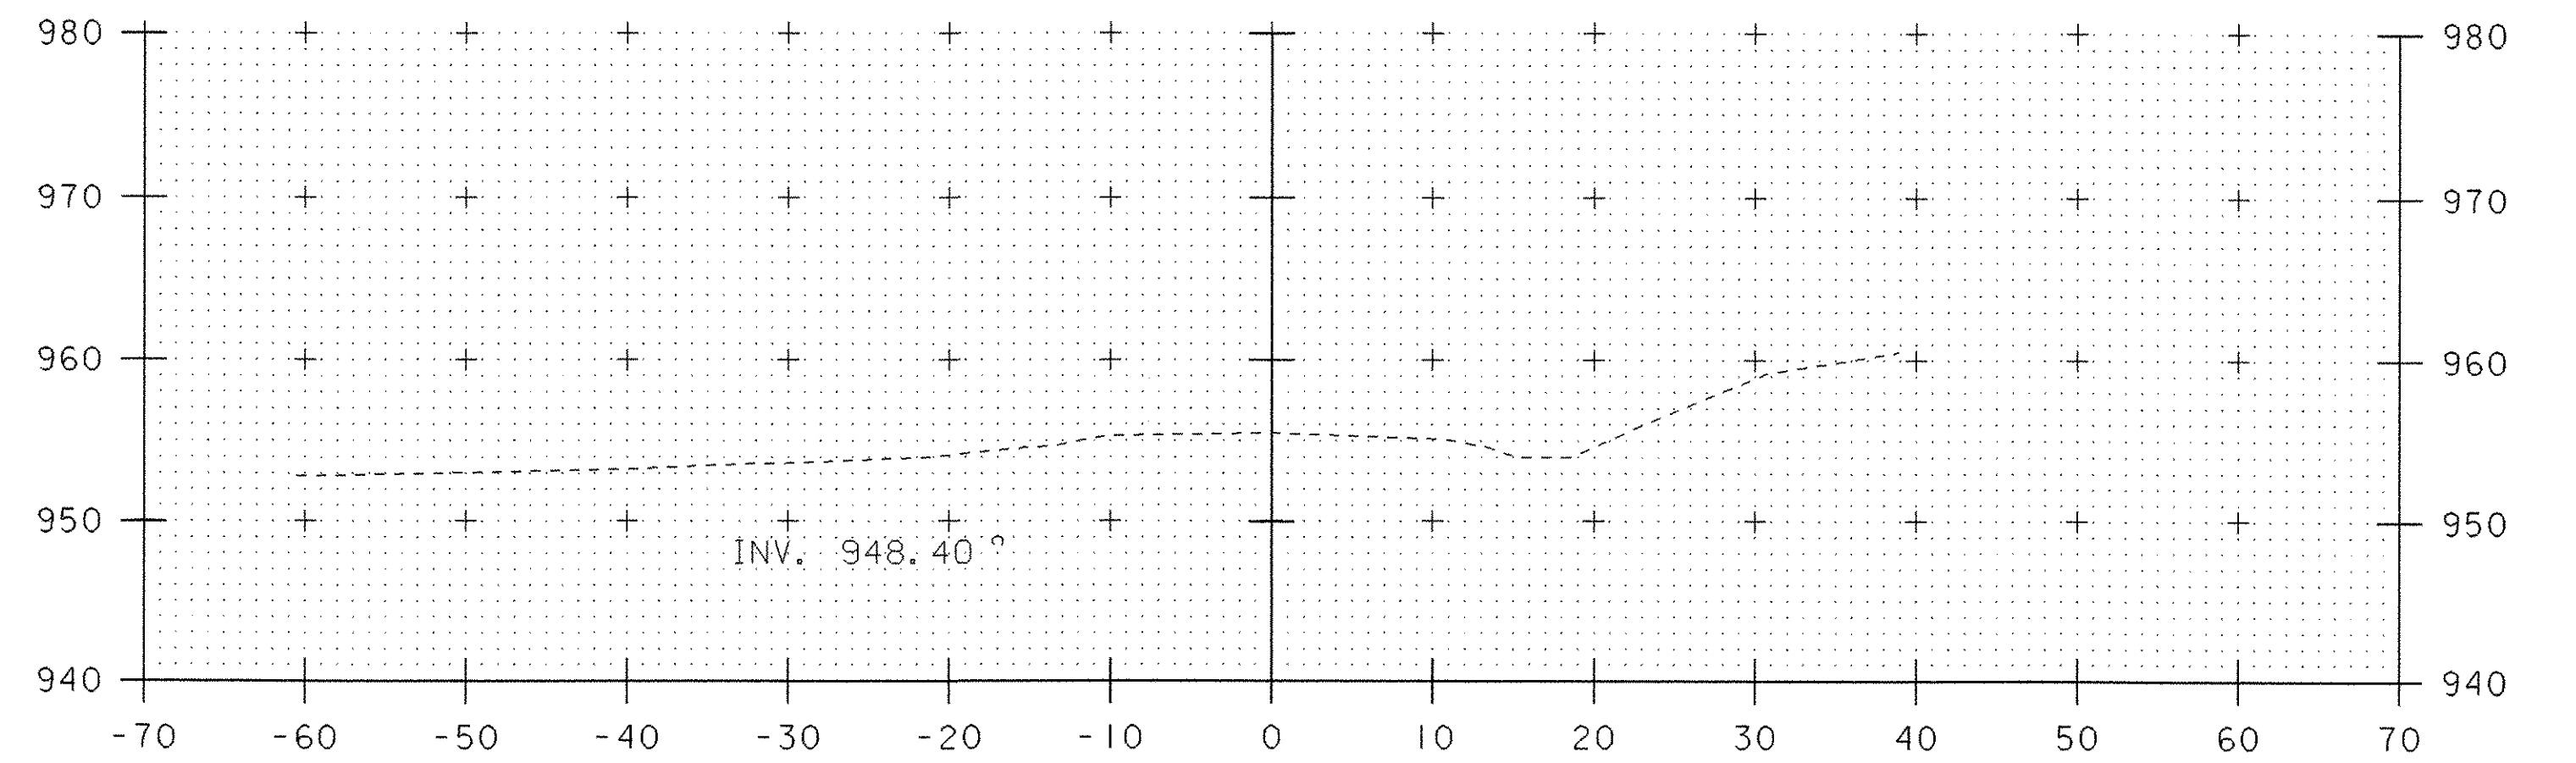


310+50

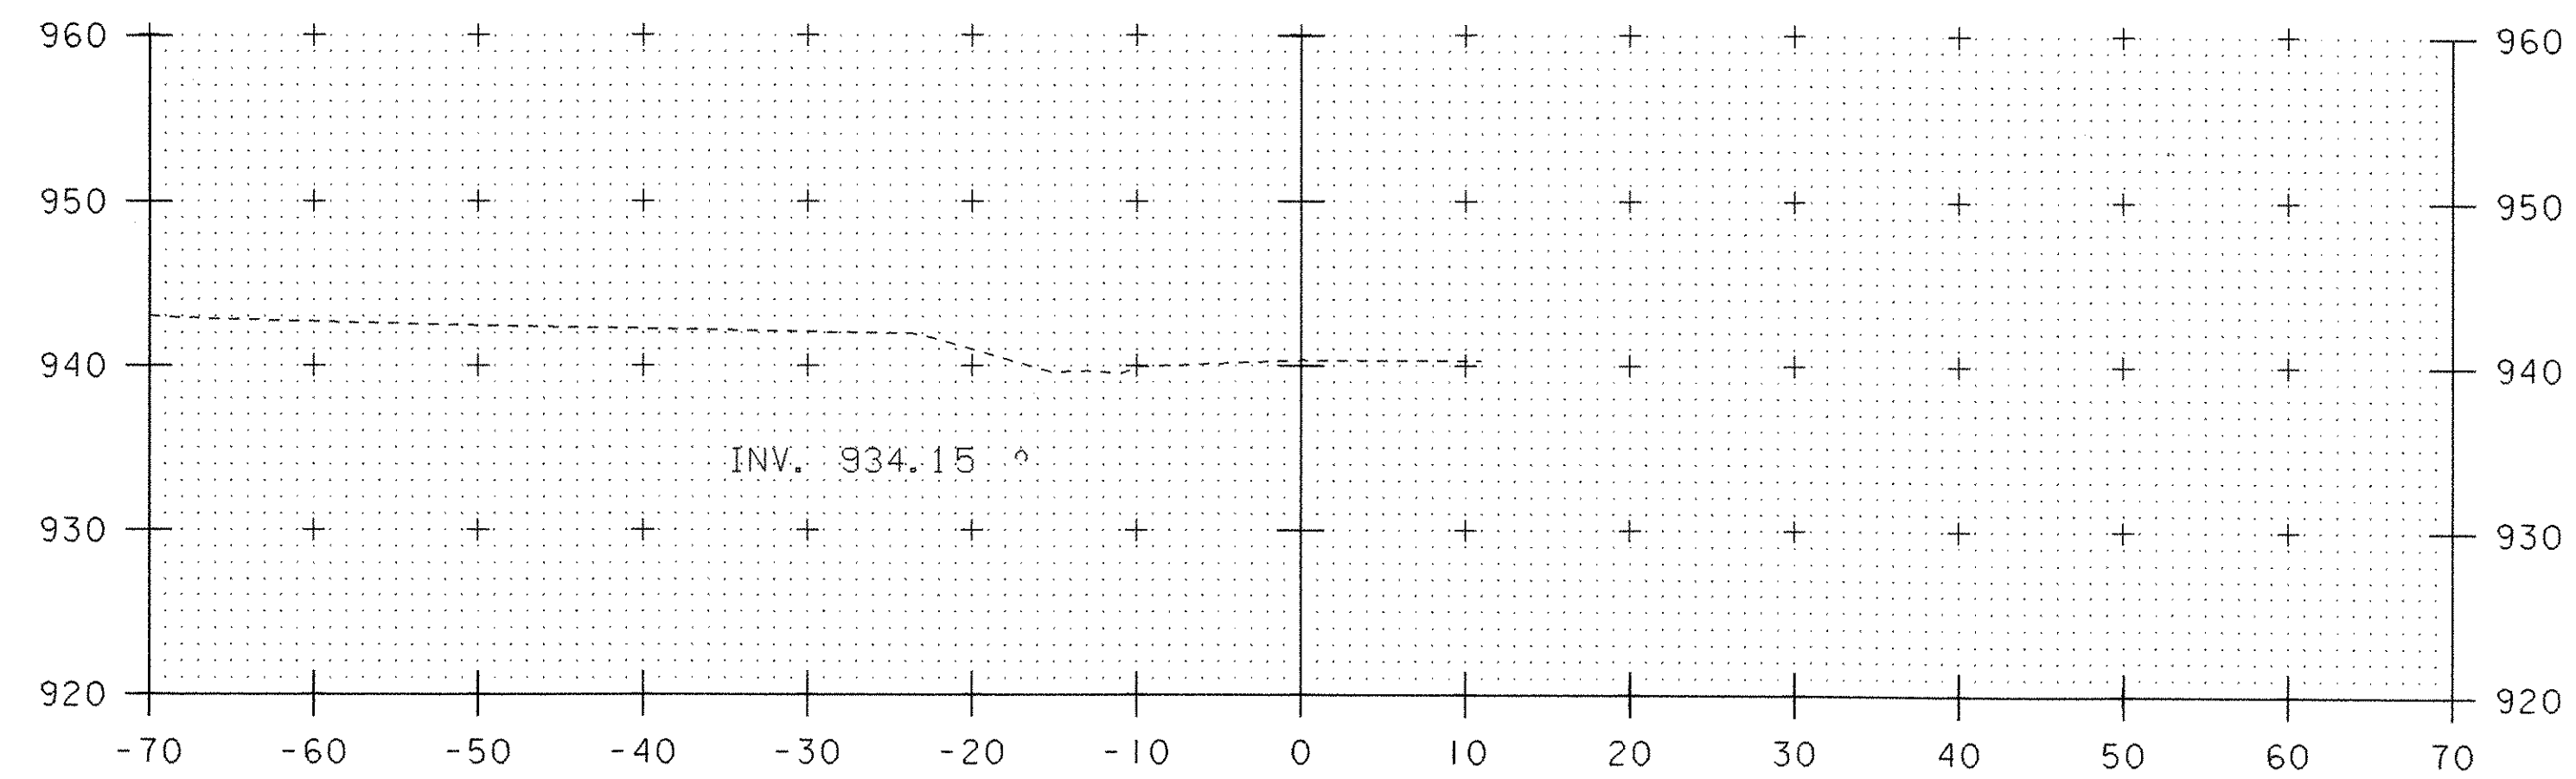


308+50

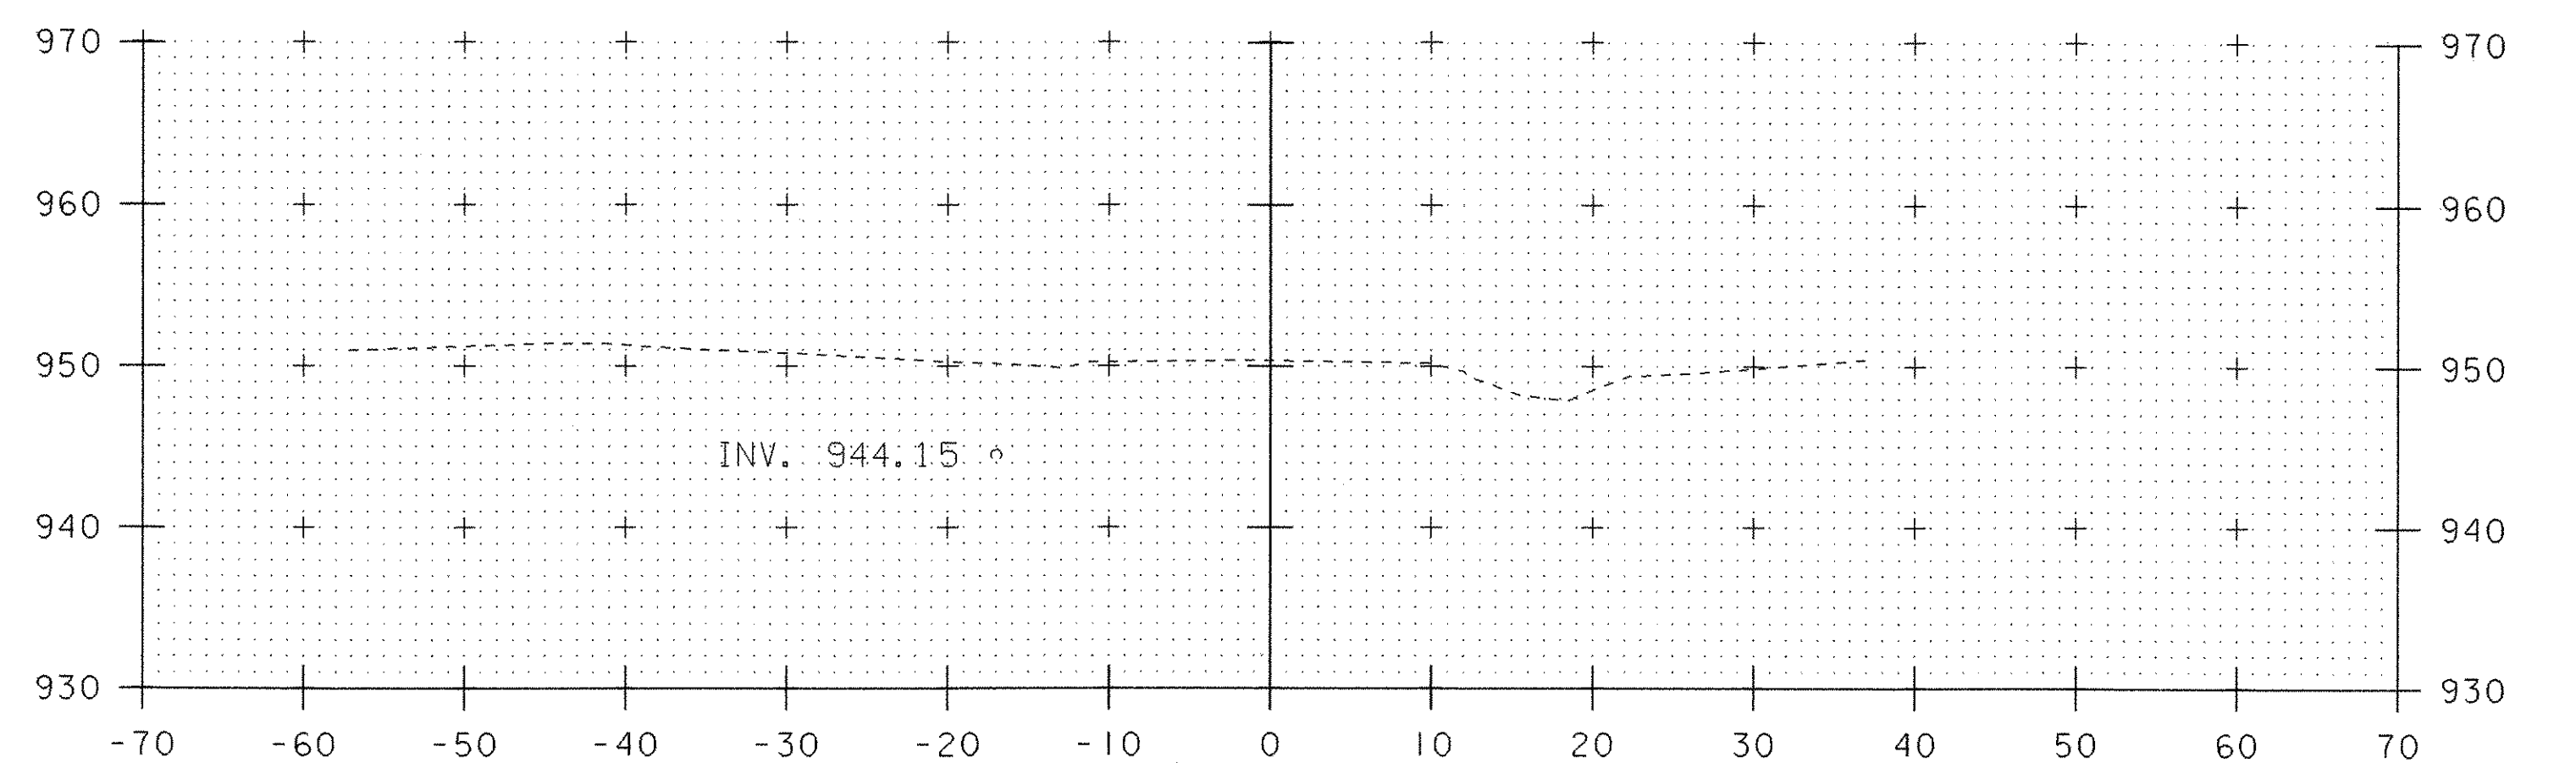


310+00

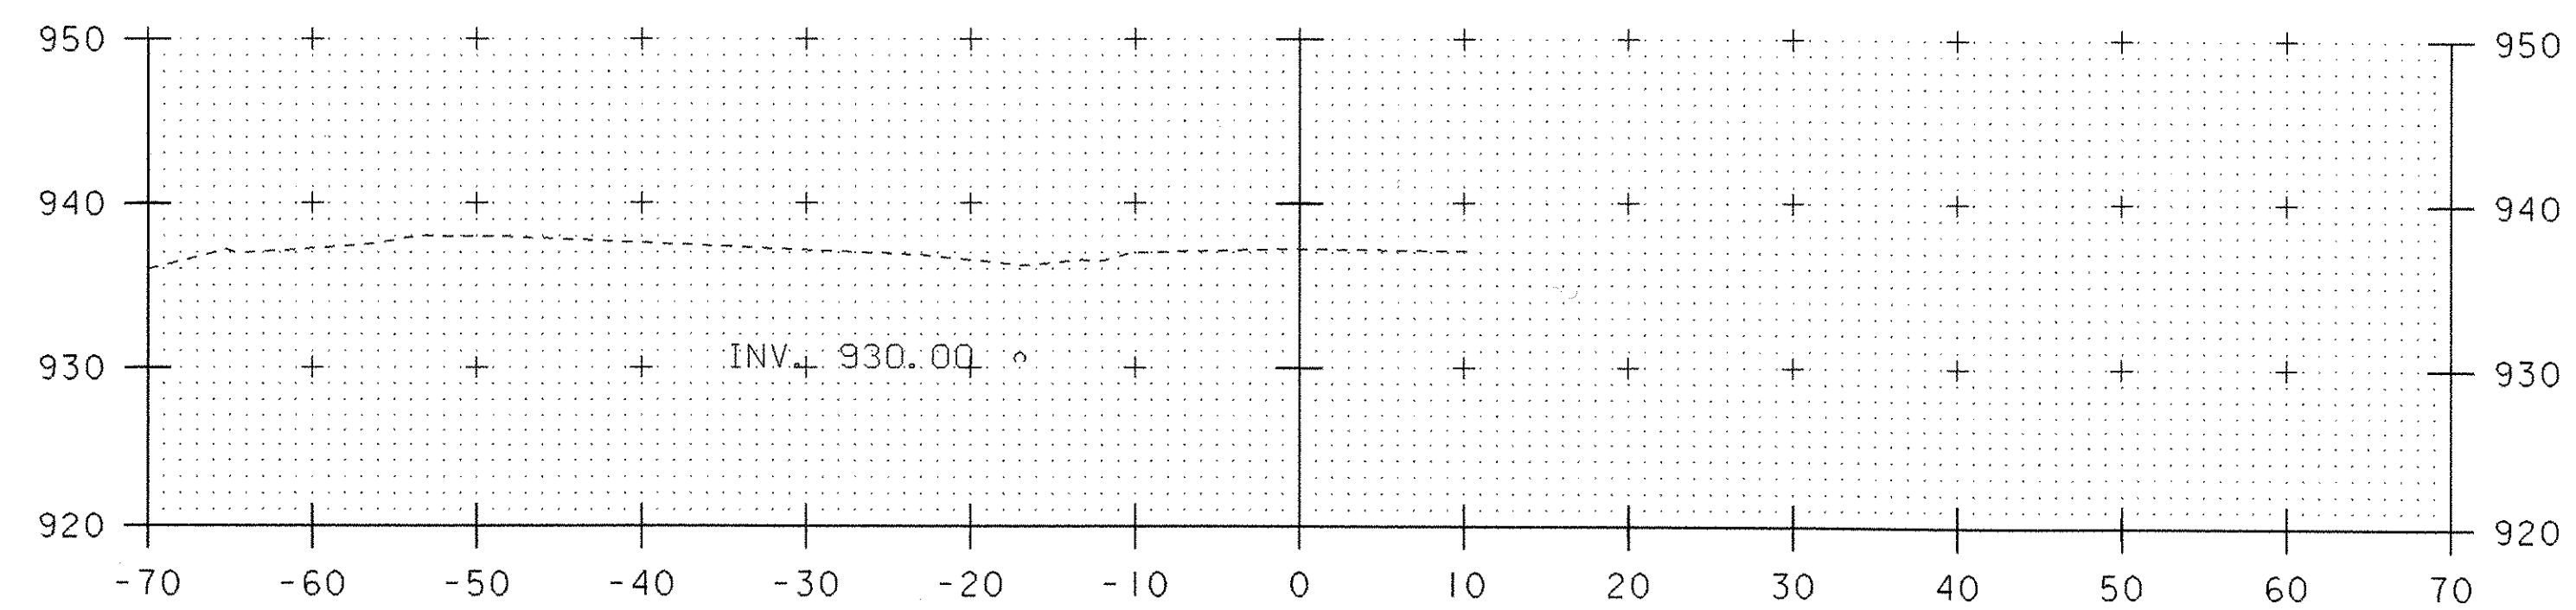

308+00

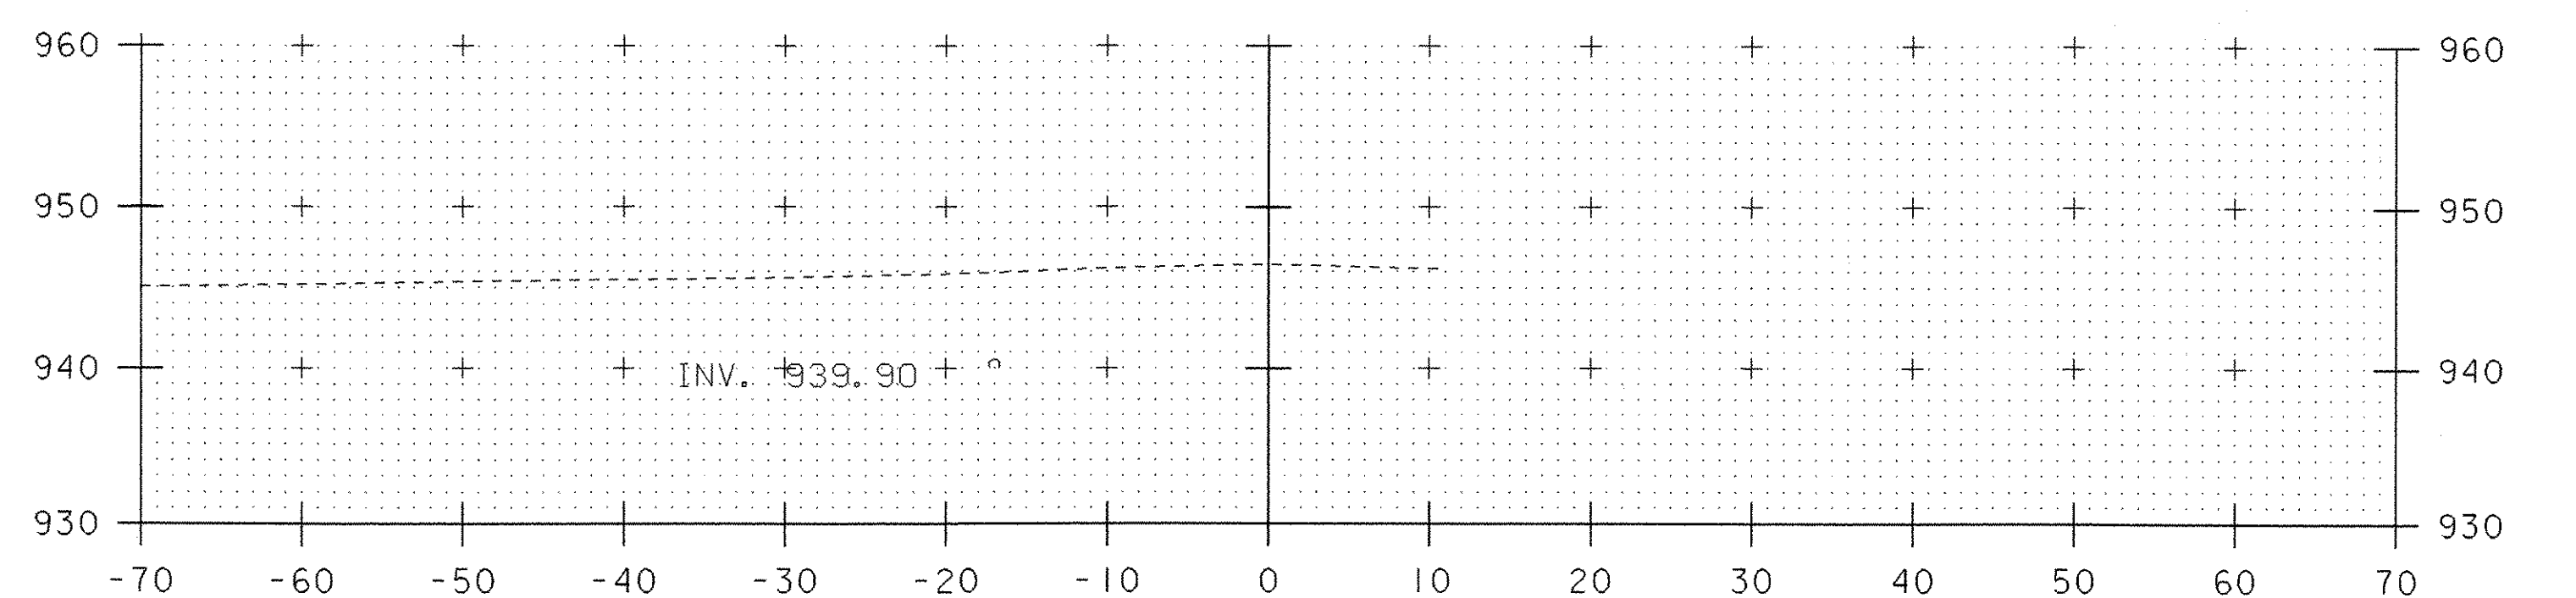

309+50

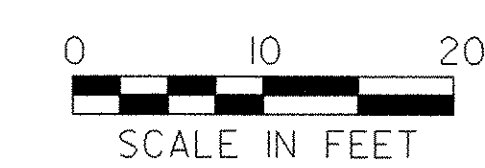

STA. 308+00 TO STA. 310+50

PROJECT NAME:	HARDWICK	PLLOT DATE:	18-OCT-2005
PROJECT NUMBER:	STP ST 030-3(4)	DRAWN BY:	M. NUTTER
FILE NAME:	d04e060xslx.dgn	CHECKED BY:	A. BOMBARDIER
PROJECT LEADER:	A. BOMBARDIER	SHEET	62 OF 63
DESIGNED BY:	M. NUTTER		
IPARM NAME:	de060xs30.i		