


FINAL SURVEY
DATE: 8/2/06
BY: [Signature]



FINAL SURVEY
DATE: 8/2/06
BY: [Signature]

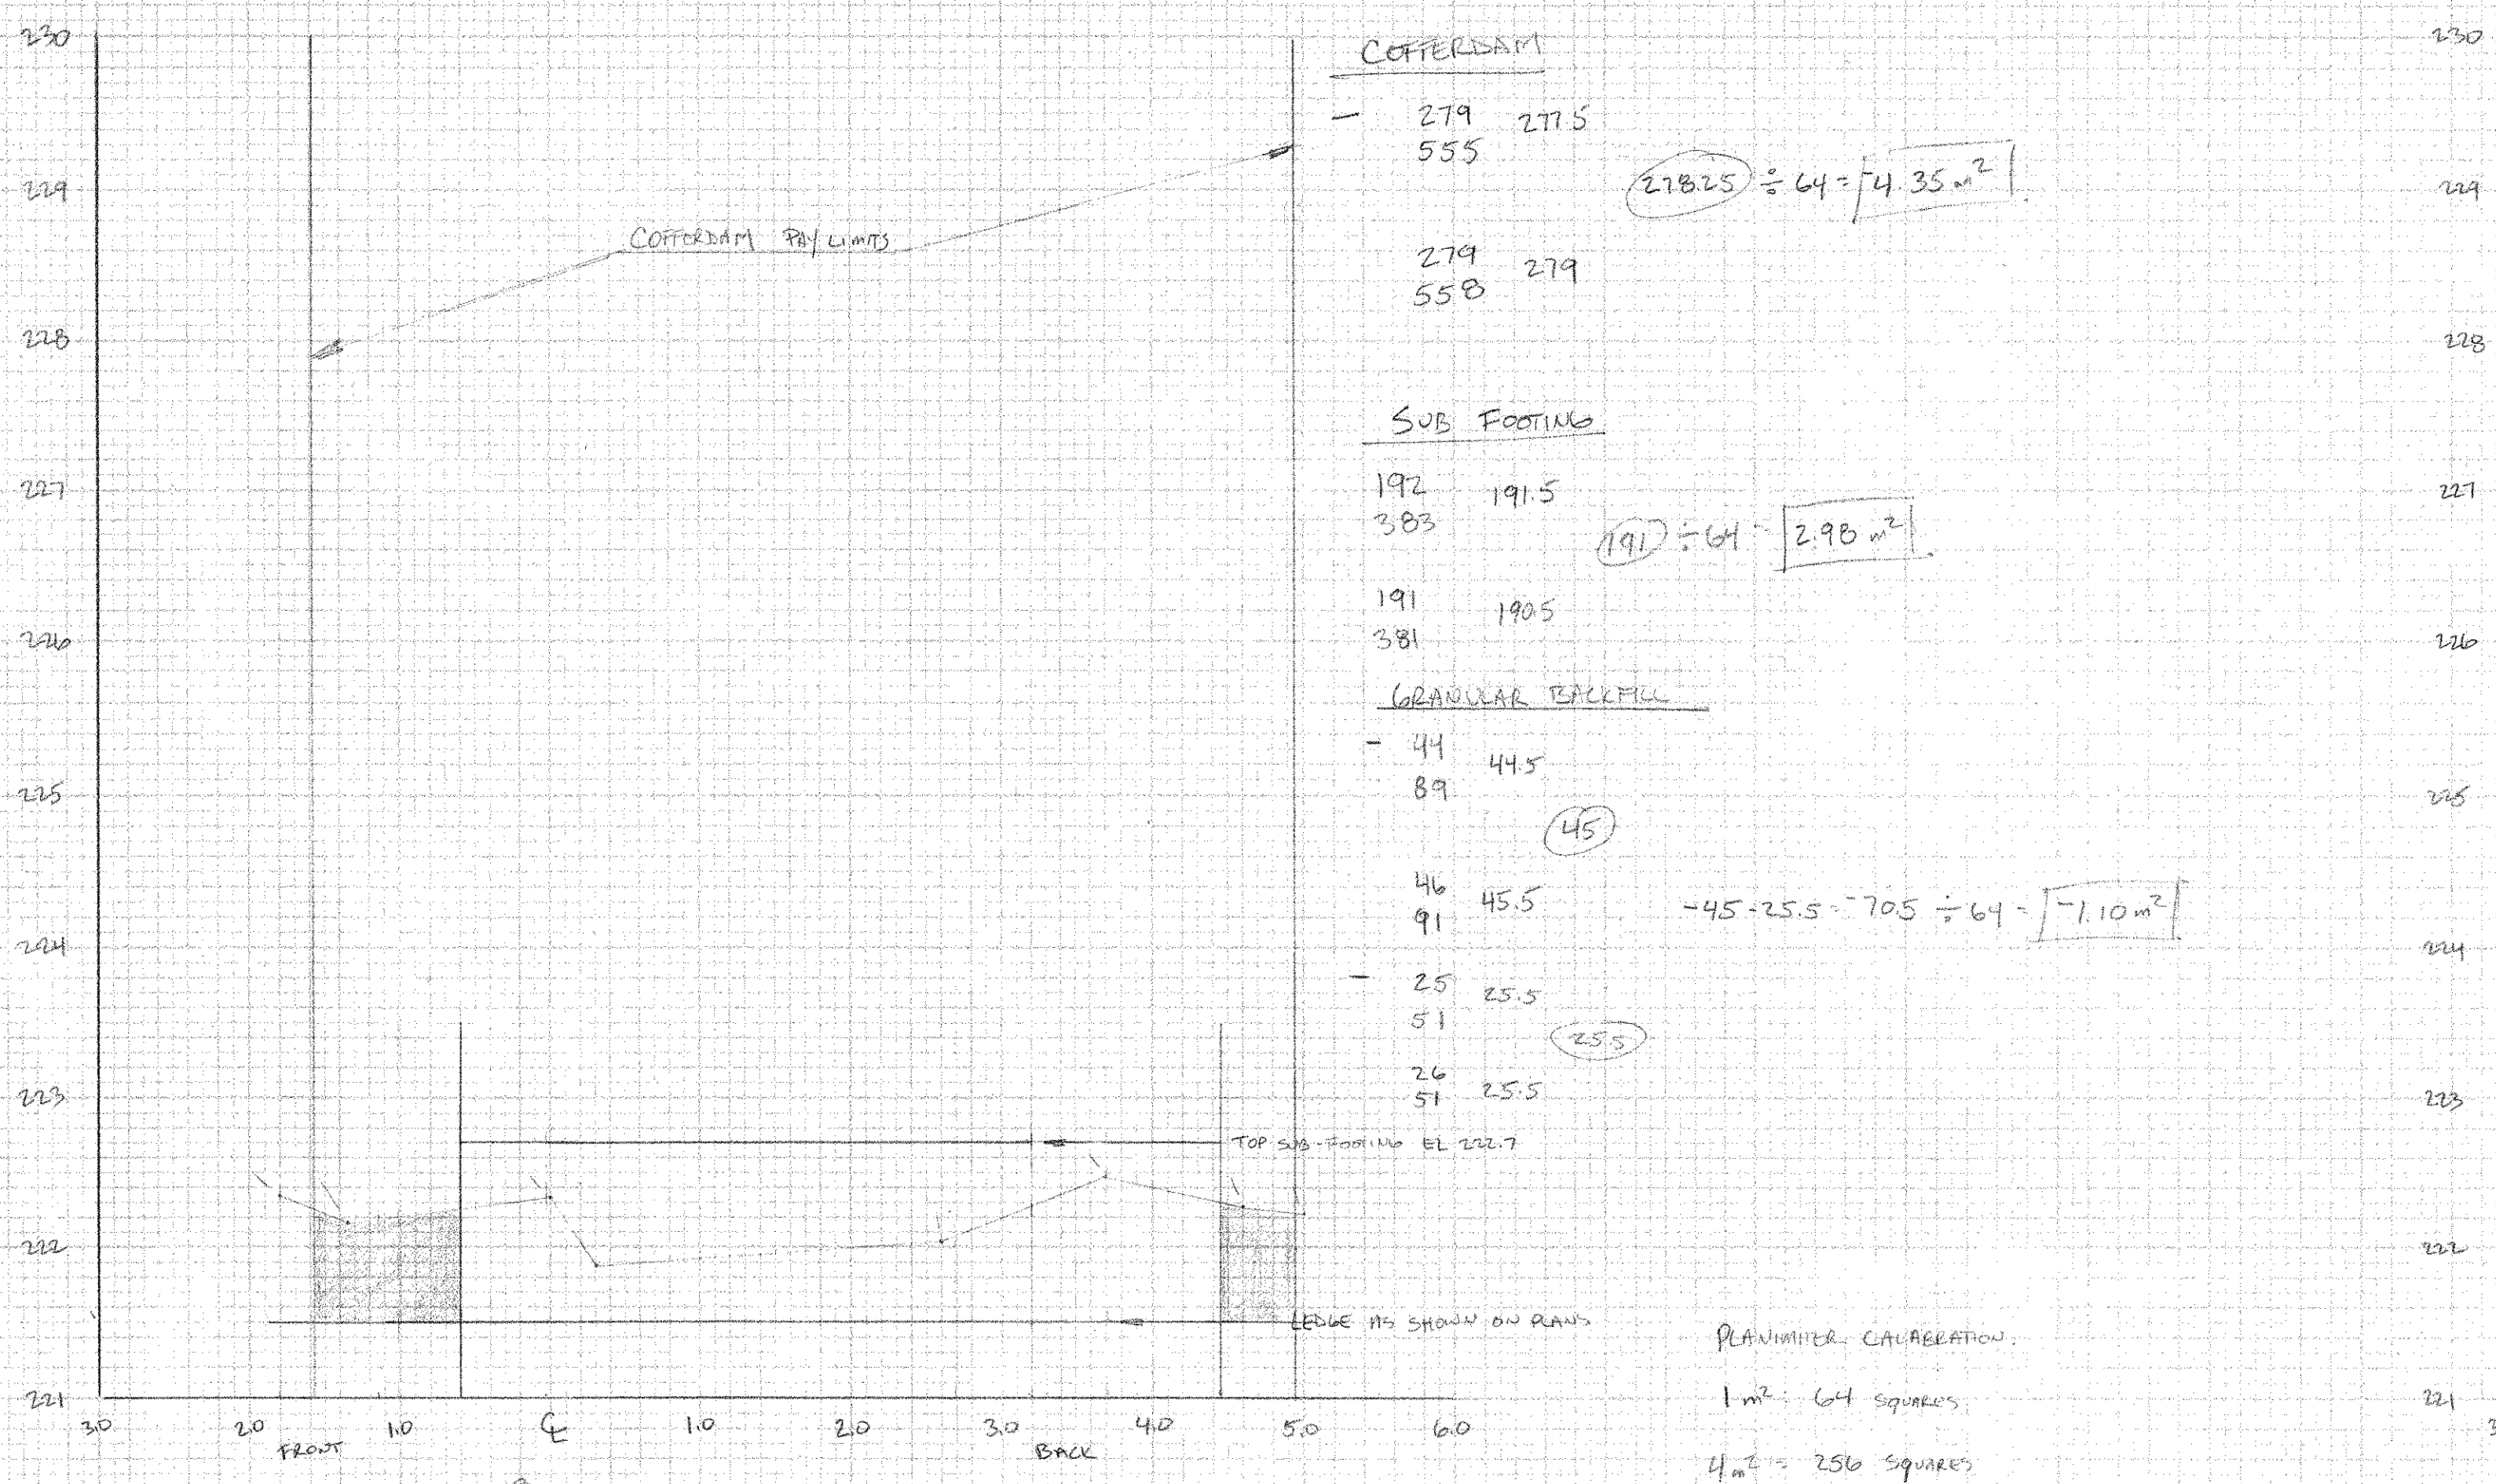