


LYNDON BRS 0269(8)



SECTIONS ALONG E BRG ABUT #2  
CS 619.00

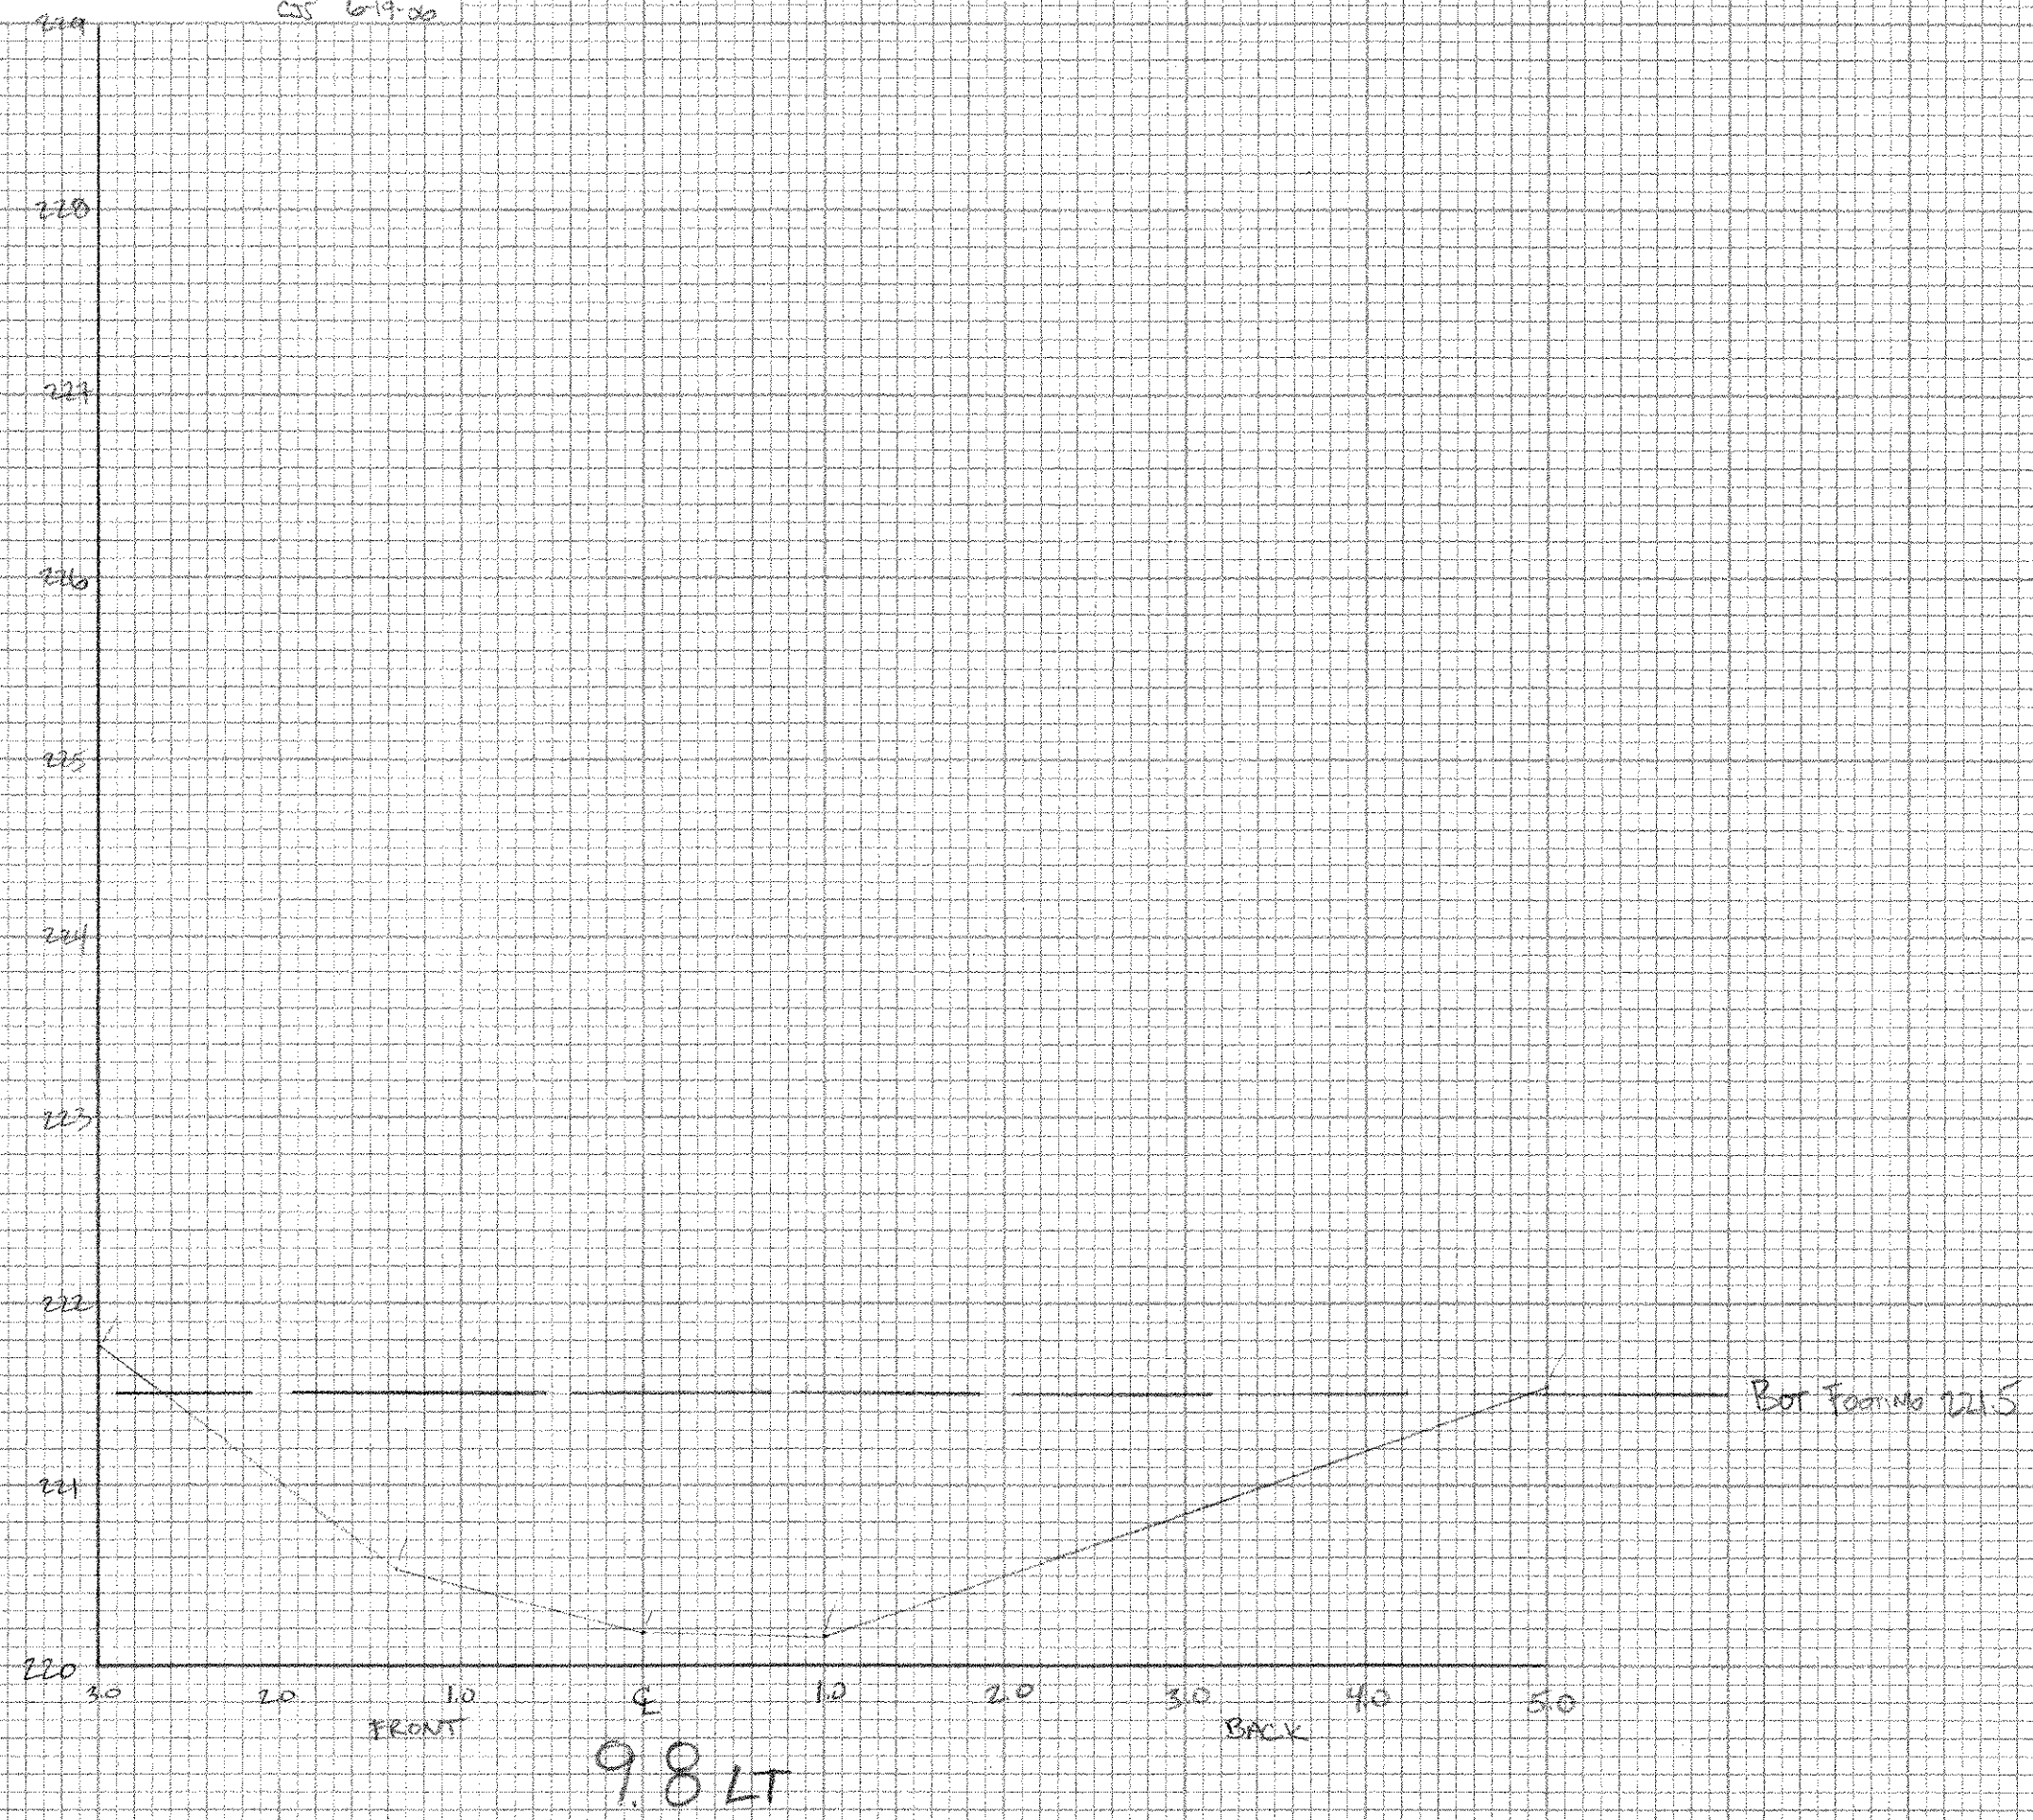

PLANIMETER CALIBRATION:

1 sm = 64 sq


4 sm = 256 sq

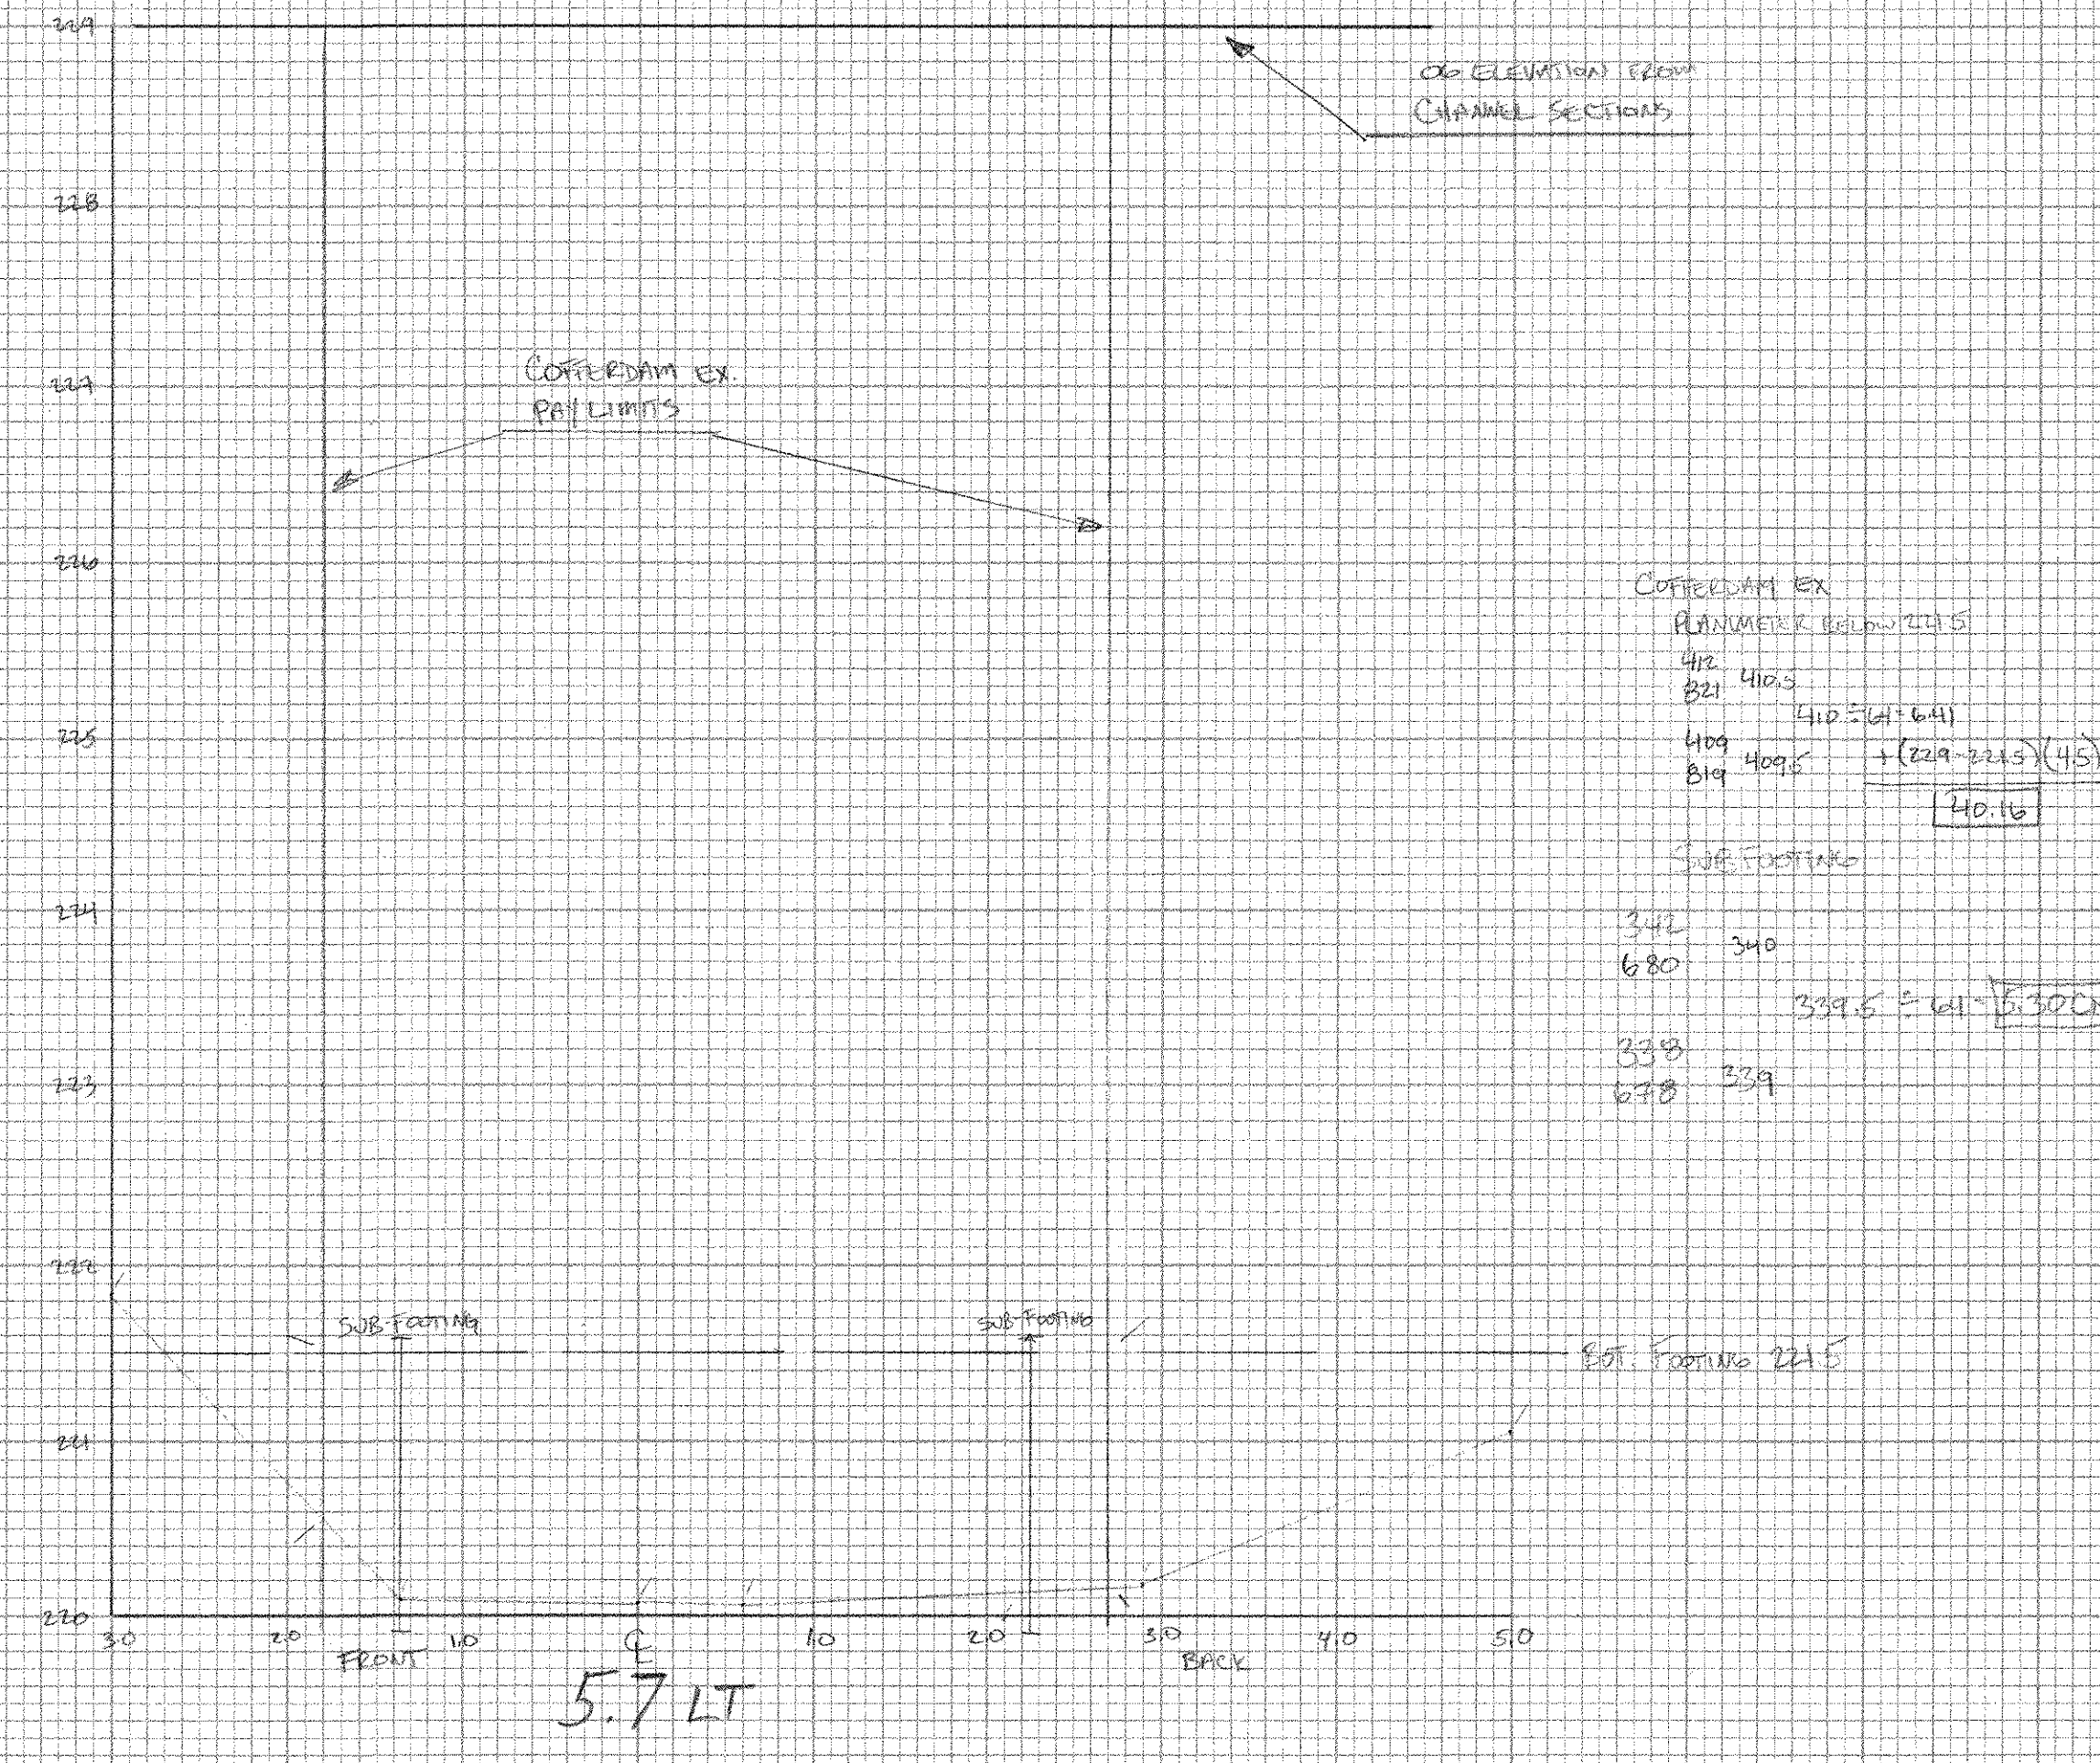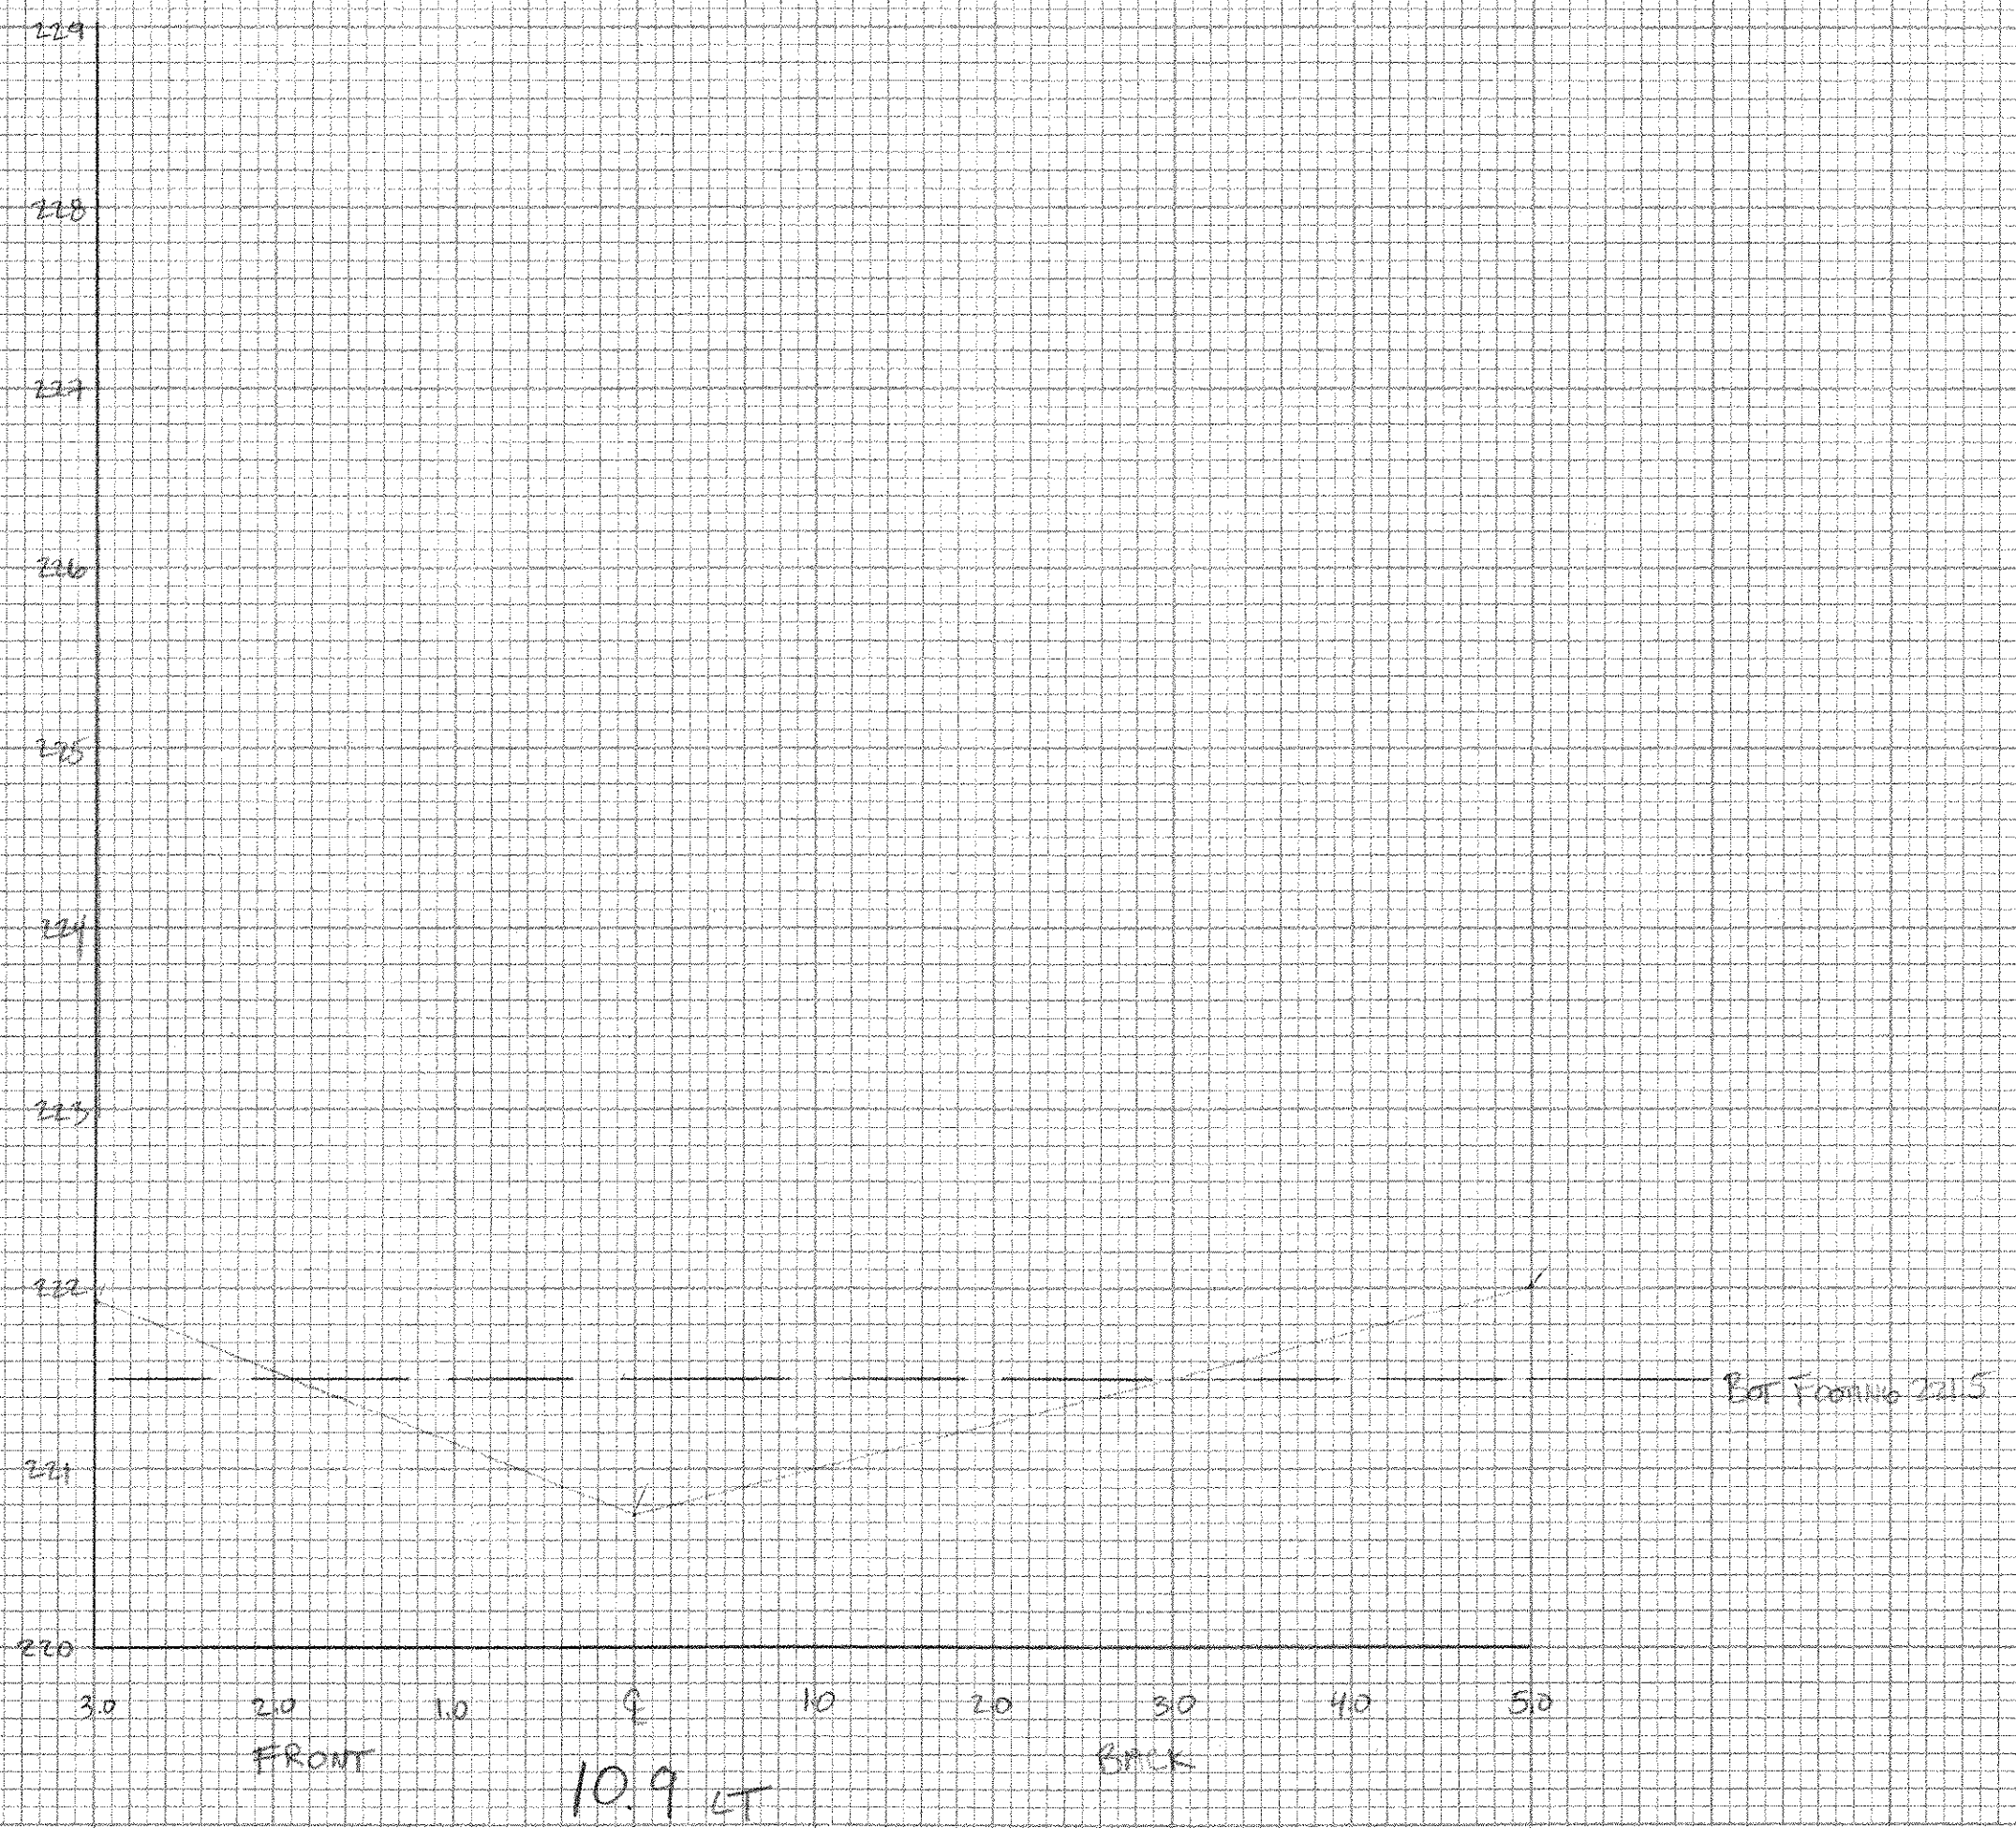

CORRECTION EX  
PLANIMETER BELOW 221.5  
392 390  
680 410  
409 409.5  
819 409.5  
+ (221.5 - 221.5) (4.5)  
140.16

SUB FOOTING  
392 390  
680 410  
399.5 410 = 5.30 CM

399 399  
678 678

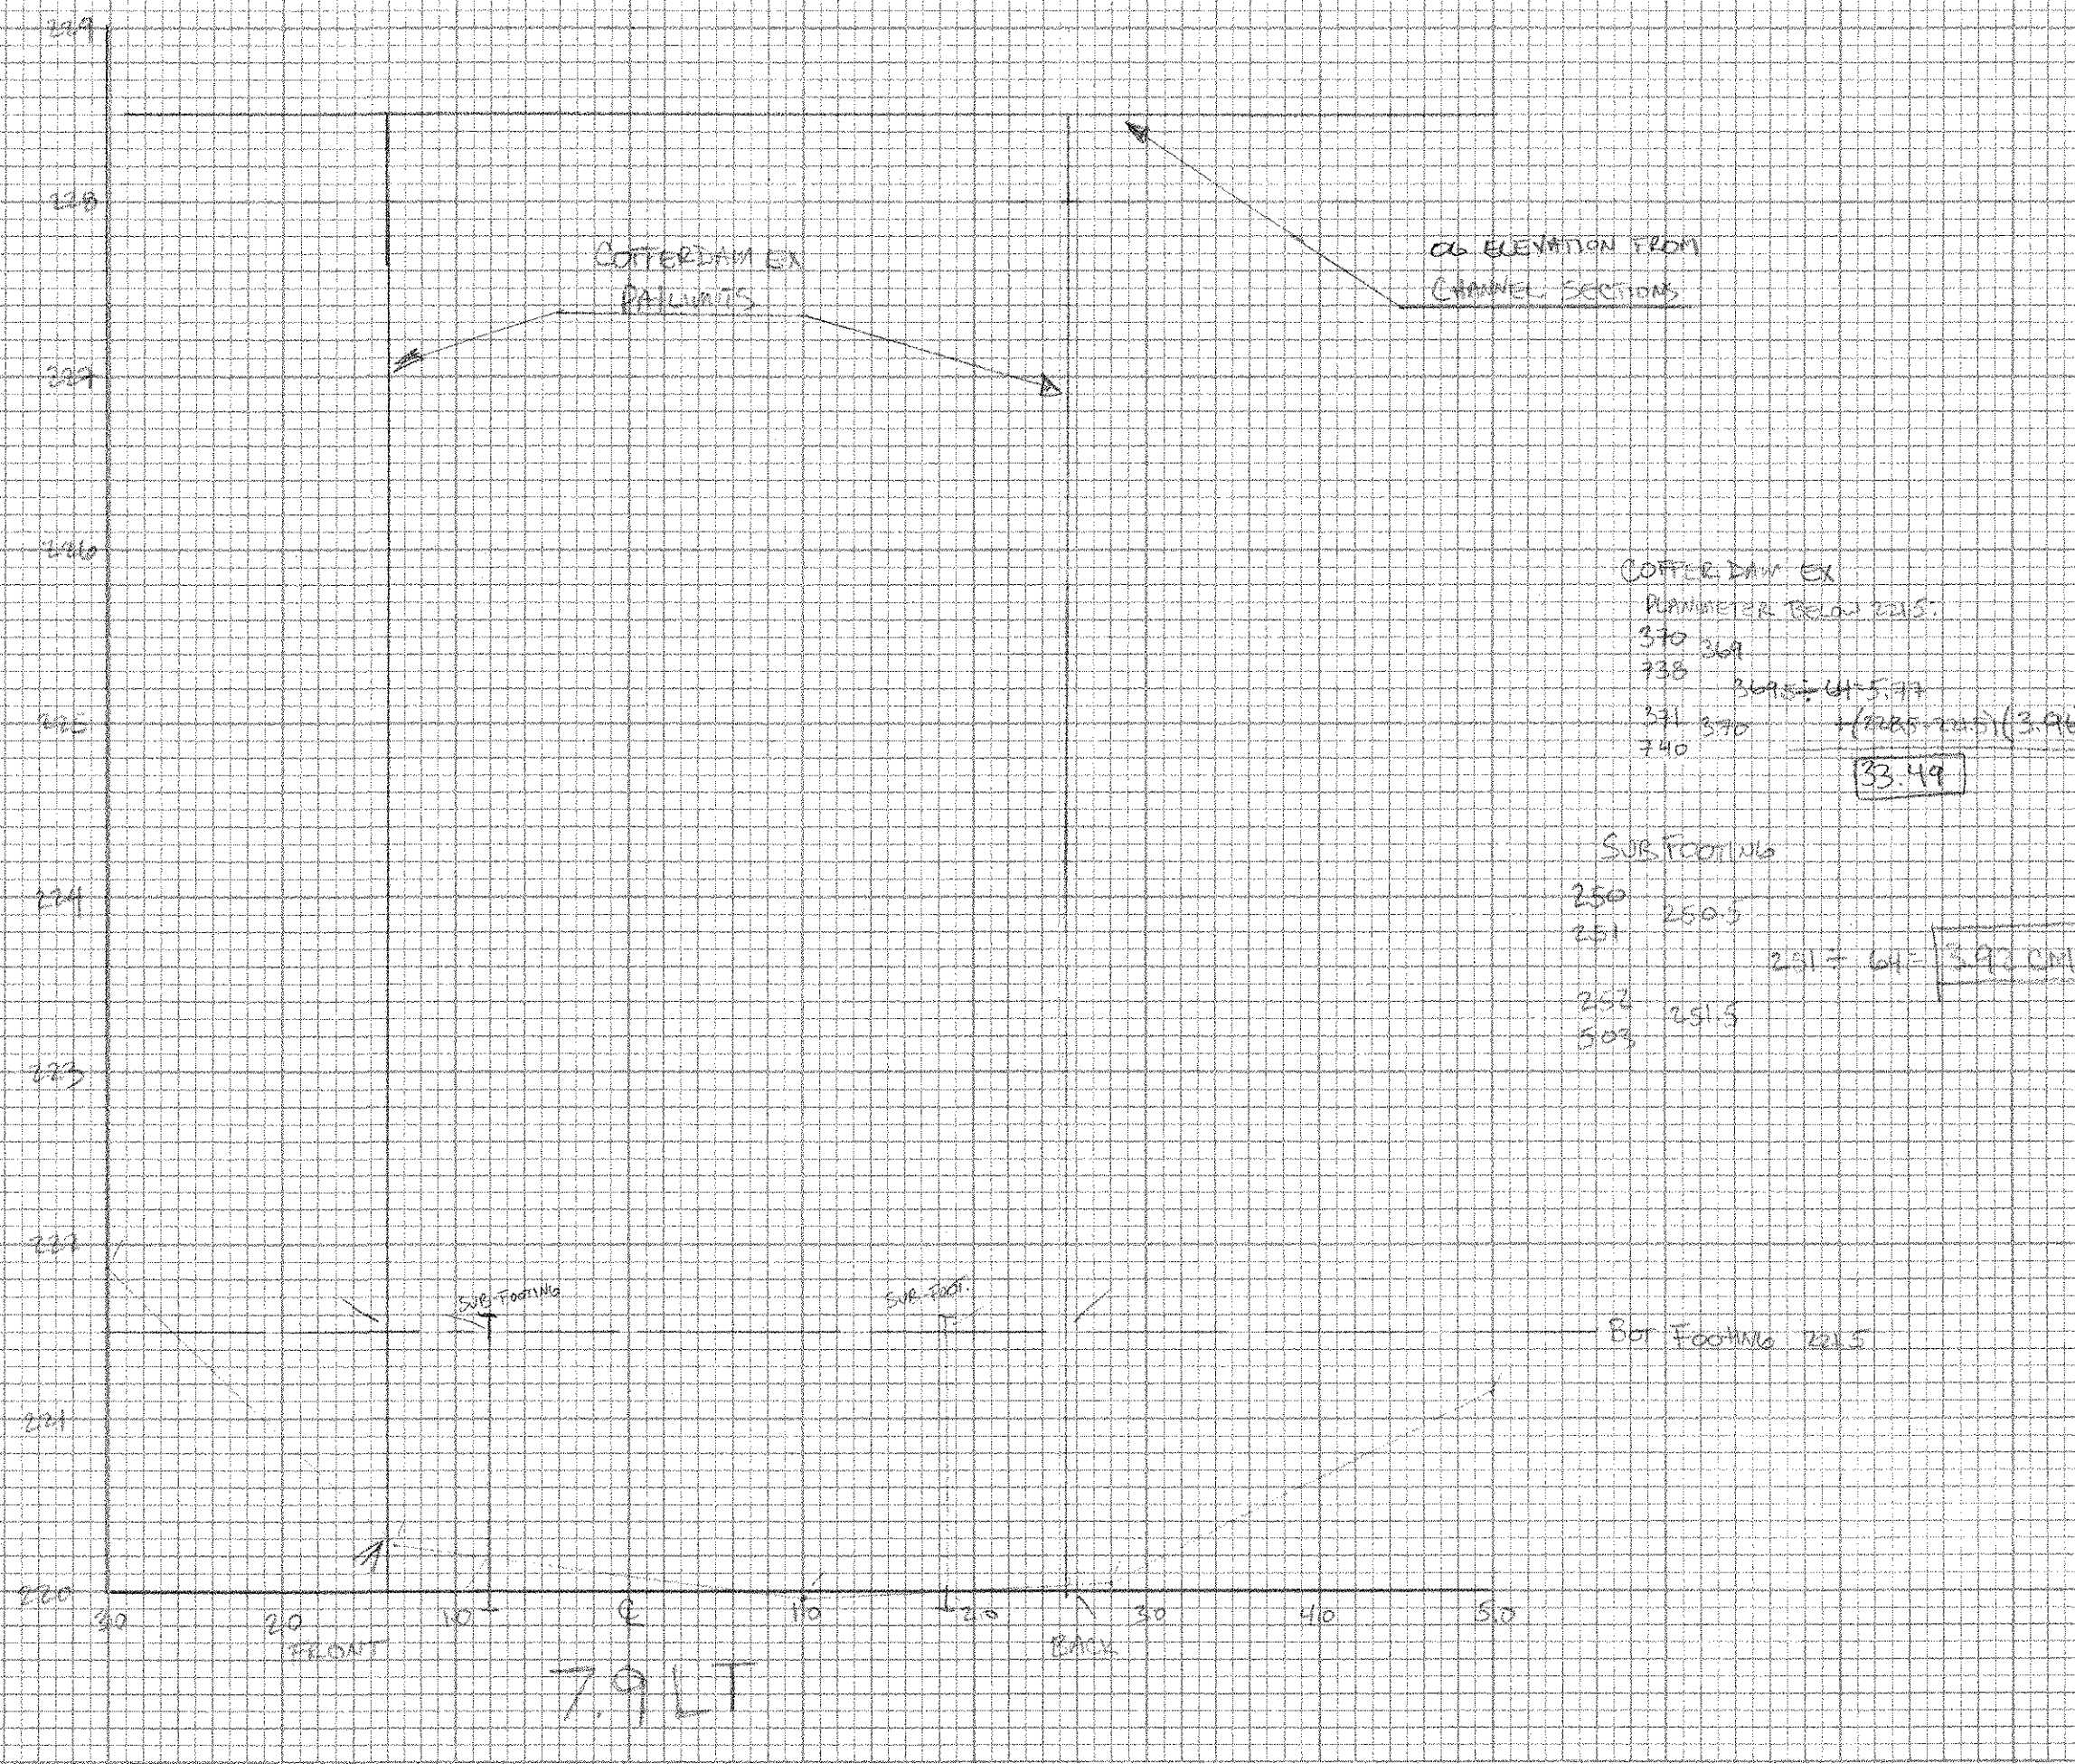

CORRECTION EX  
PLANIMETER BELOW 221.5:  
390 390  
738 410  
391 390  
740 410  
+ (221.5 - 221.5) (3.96)  
13.49

SUB FOOTING  
250 250.5  
251 250.5  
250 250.5  
509 250.5  
251 = 64 = 3.93 CM

NO.	DATE
BY	BY
CHECKED	CHECKED
APPROVED	APPROVED

NO.	DATE
BY	BY
CHECKED	CHECKED
APPROVED	APPROVED