

LYNDON BRS 0269(B)
 SECTIONS ALONG E R26 ABUT #2

CSJ 6/19/06

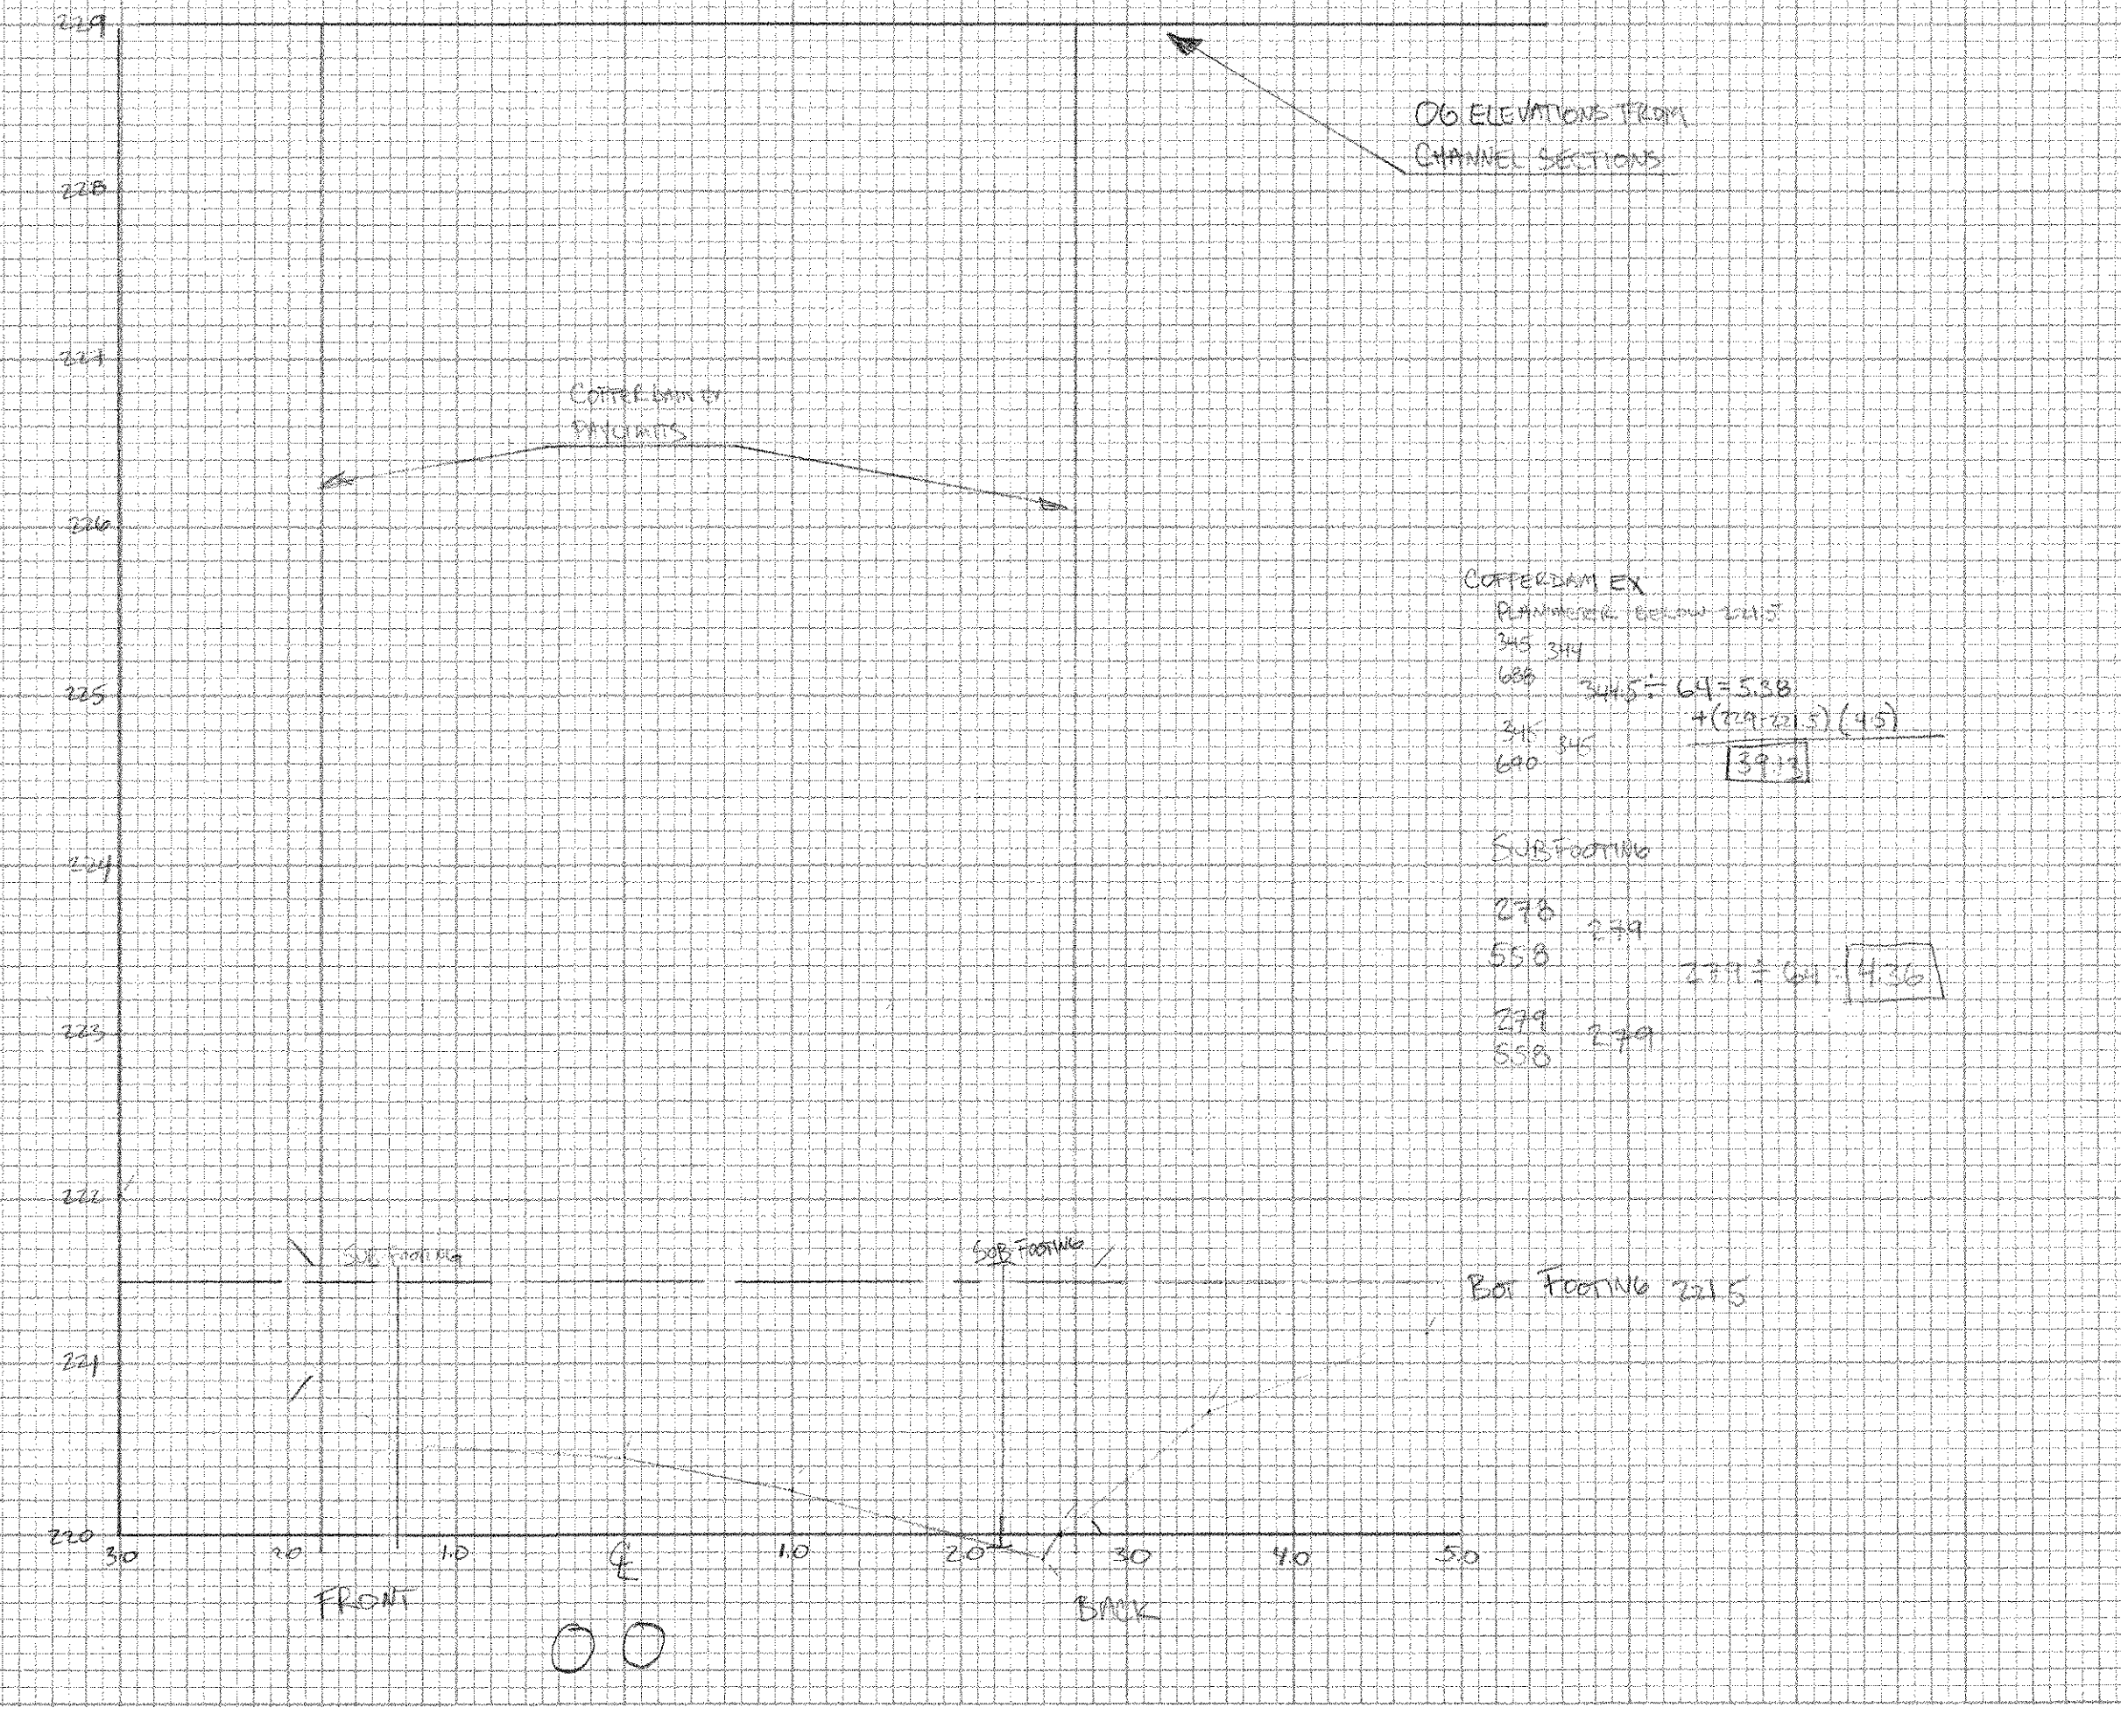
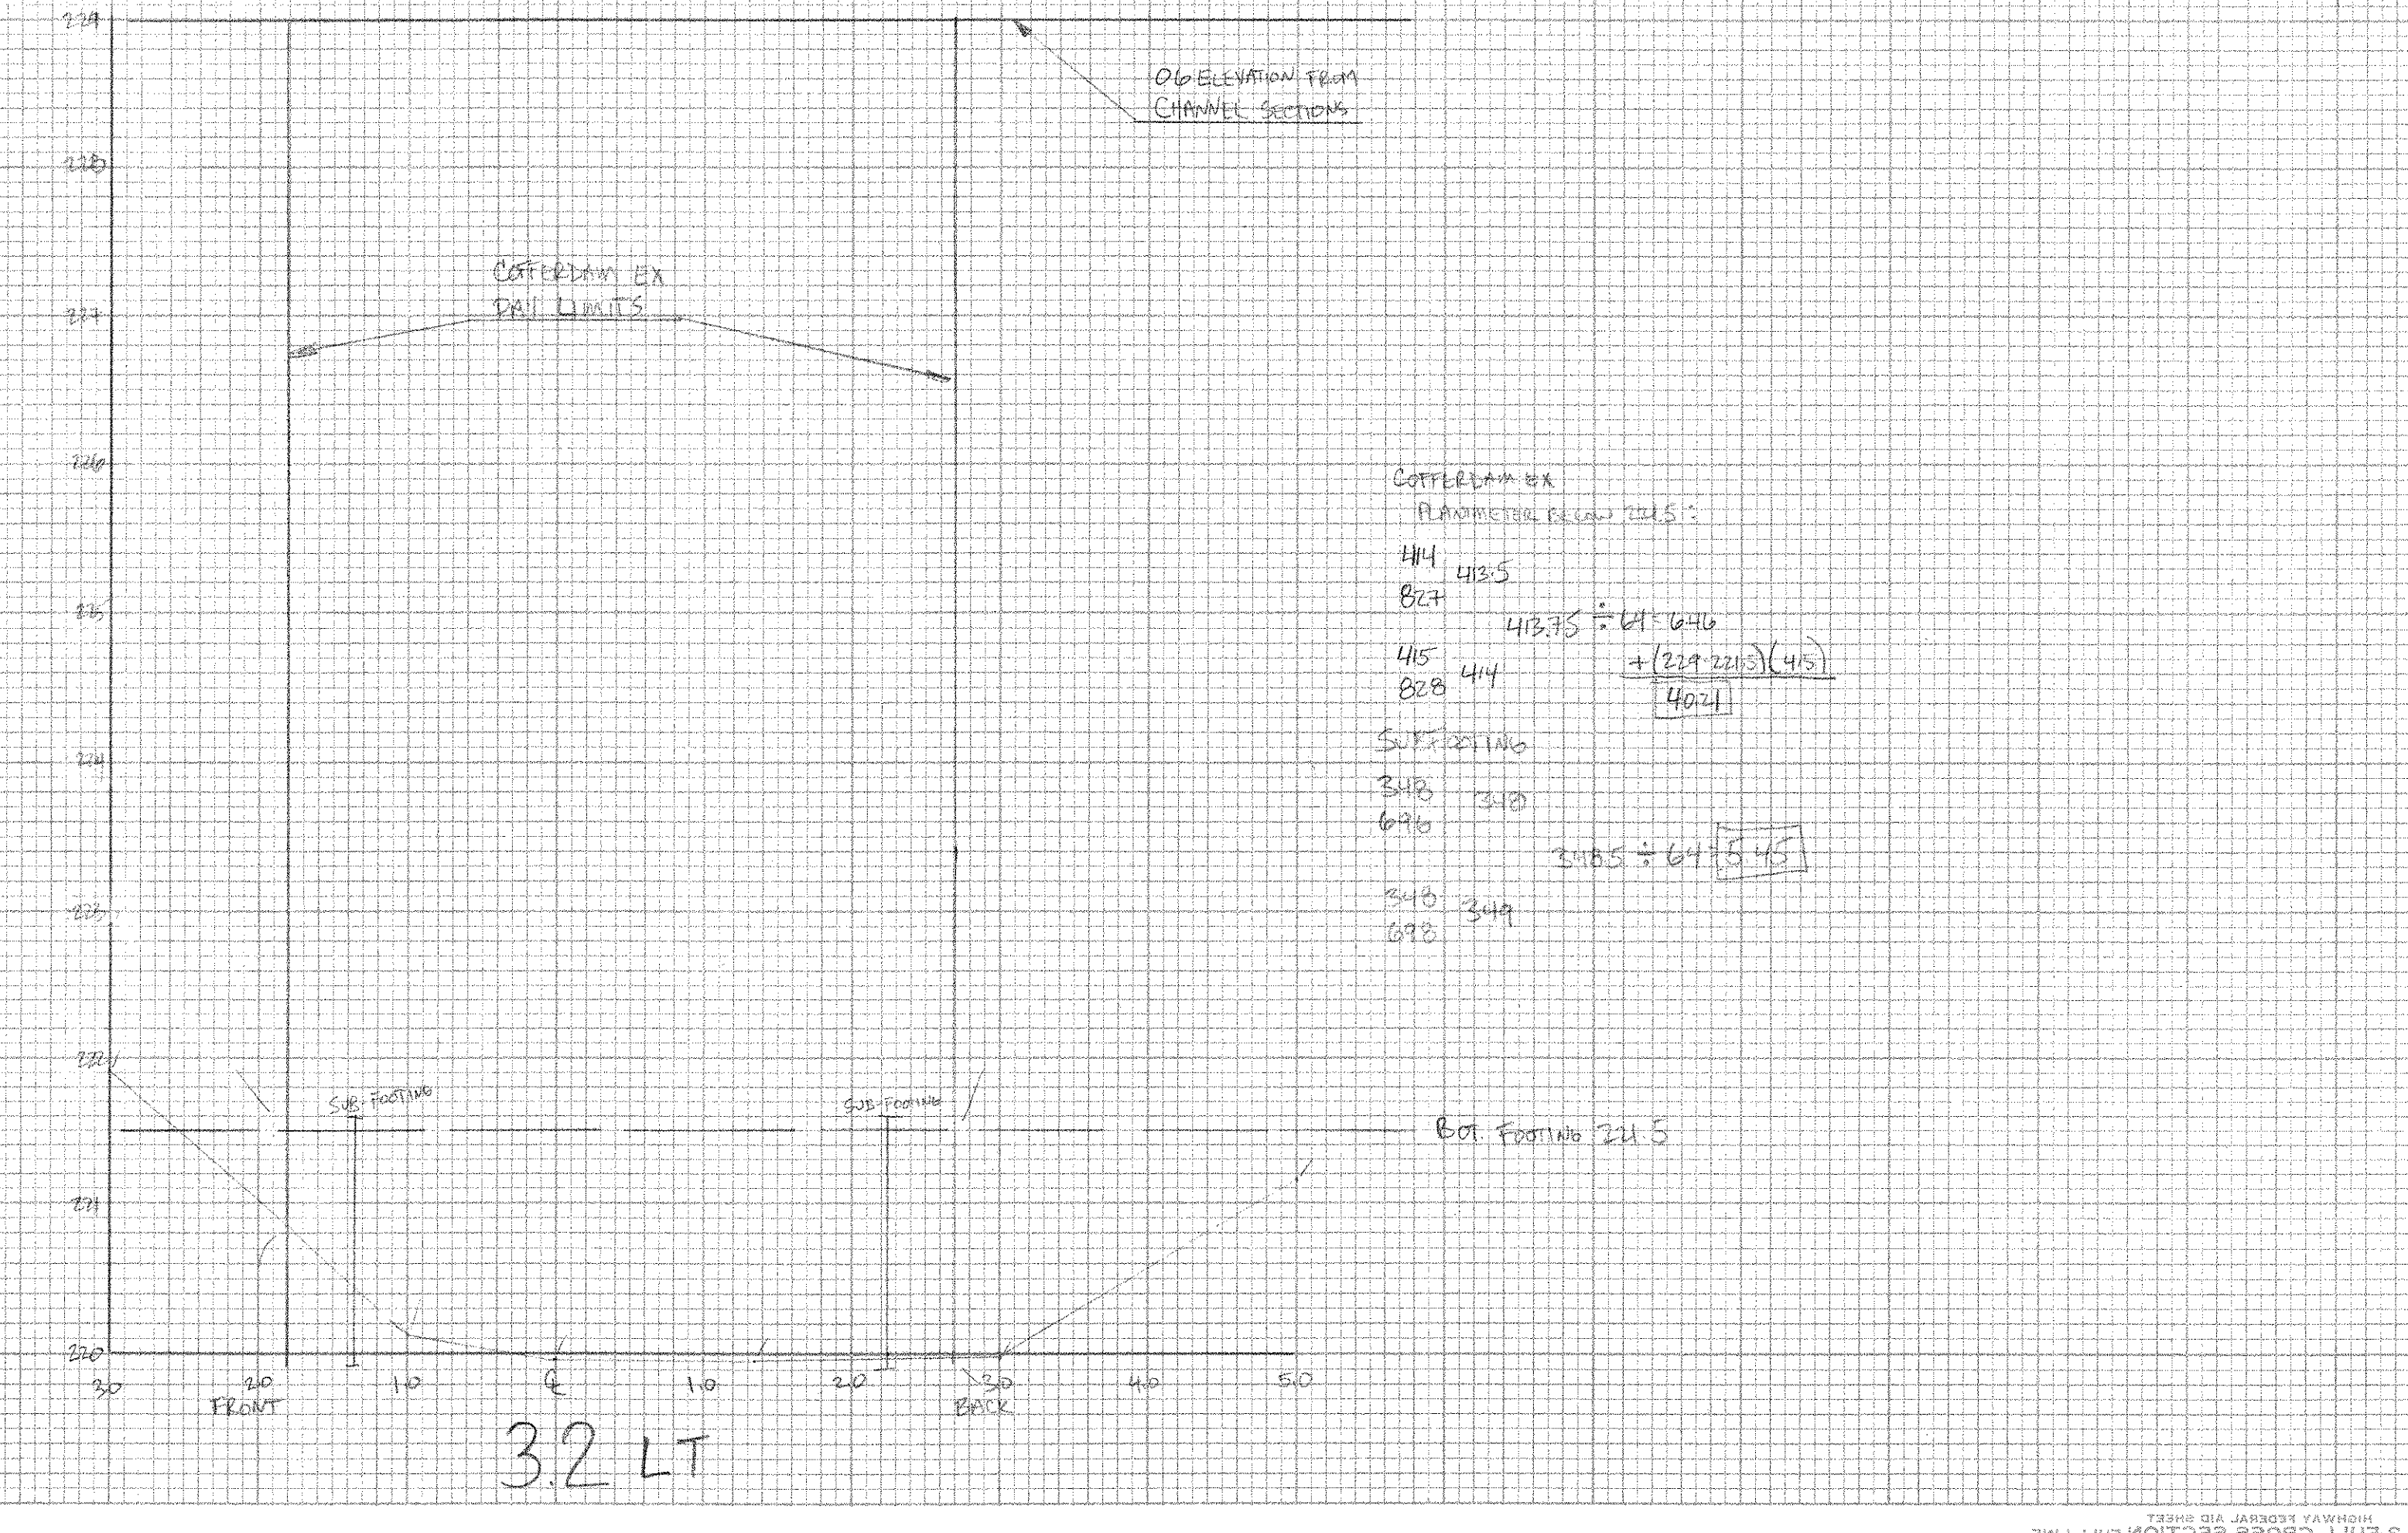
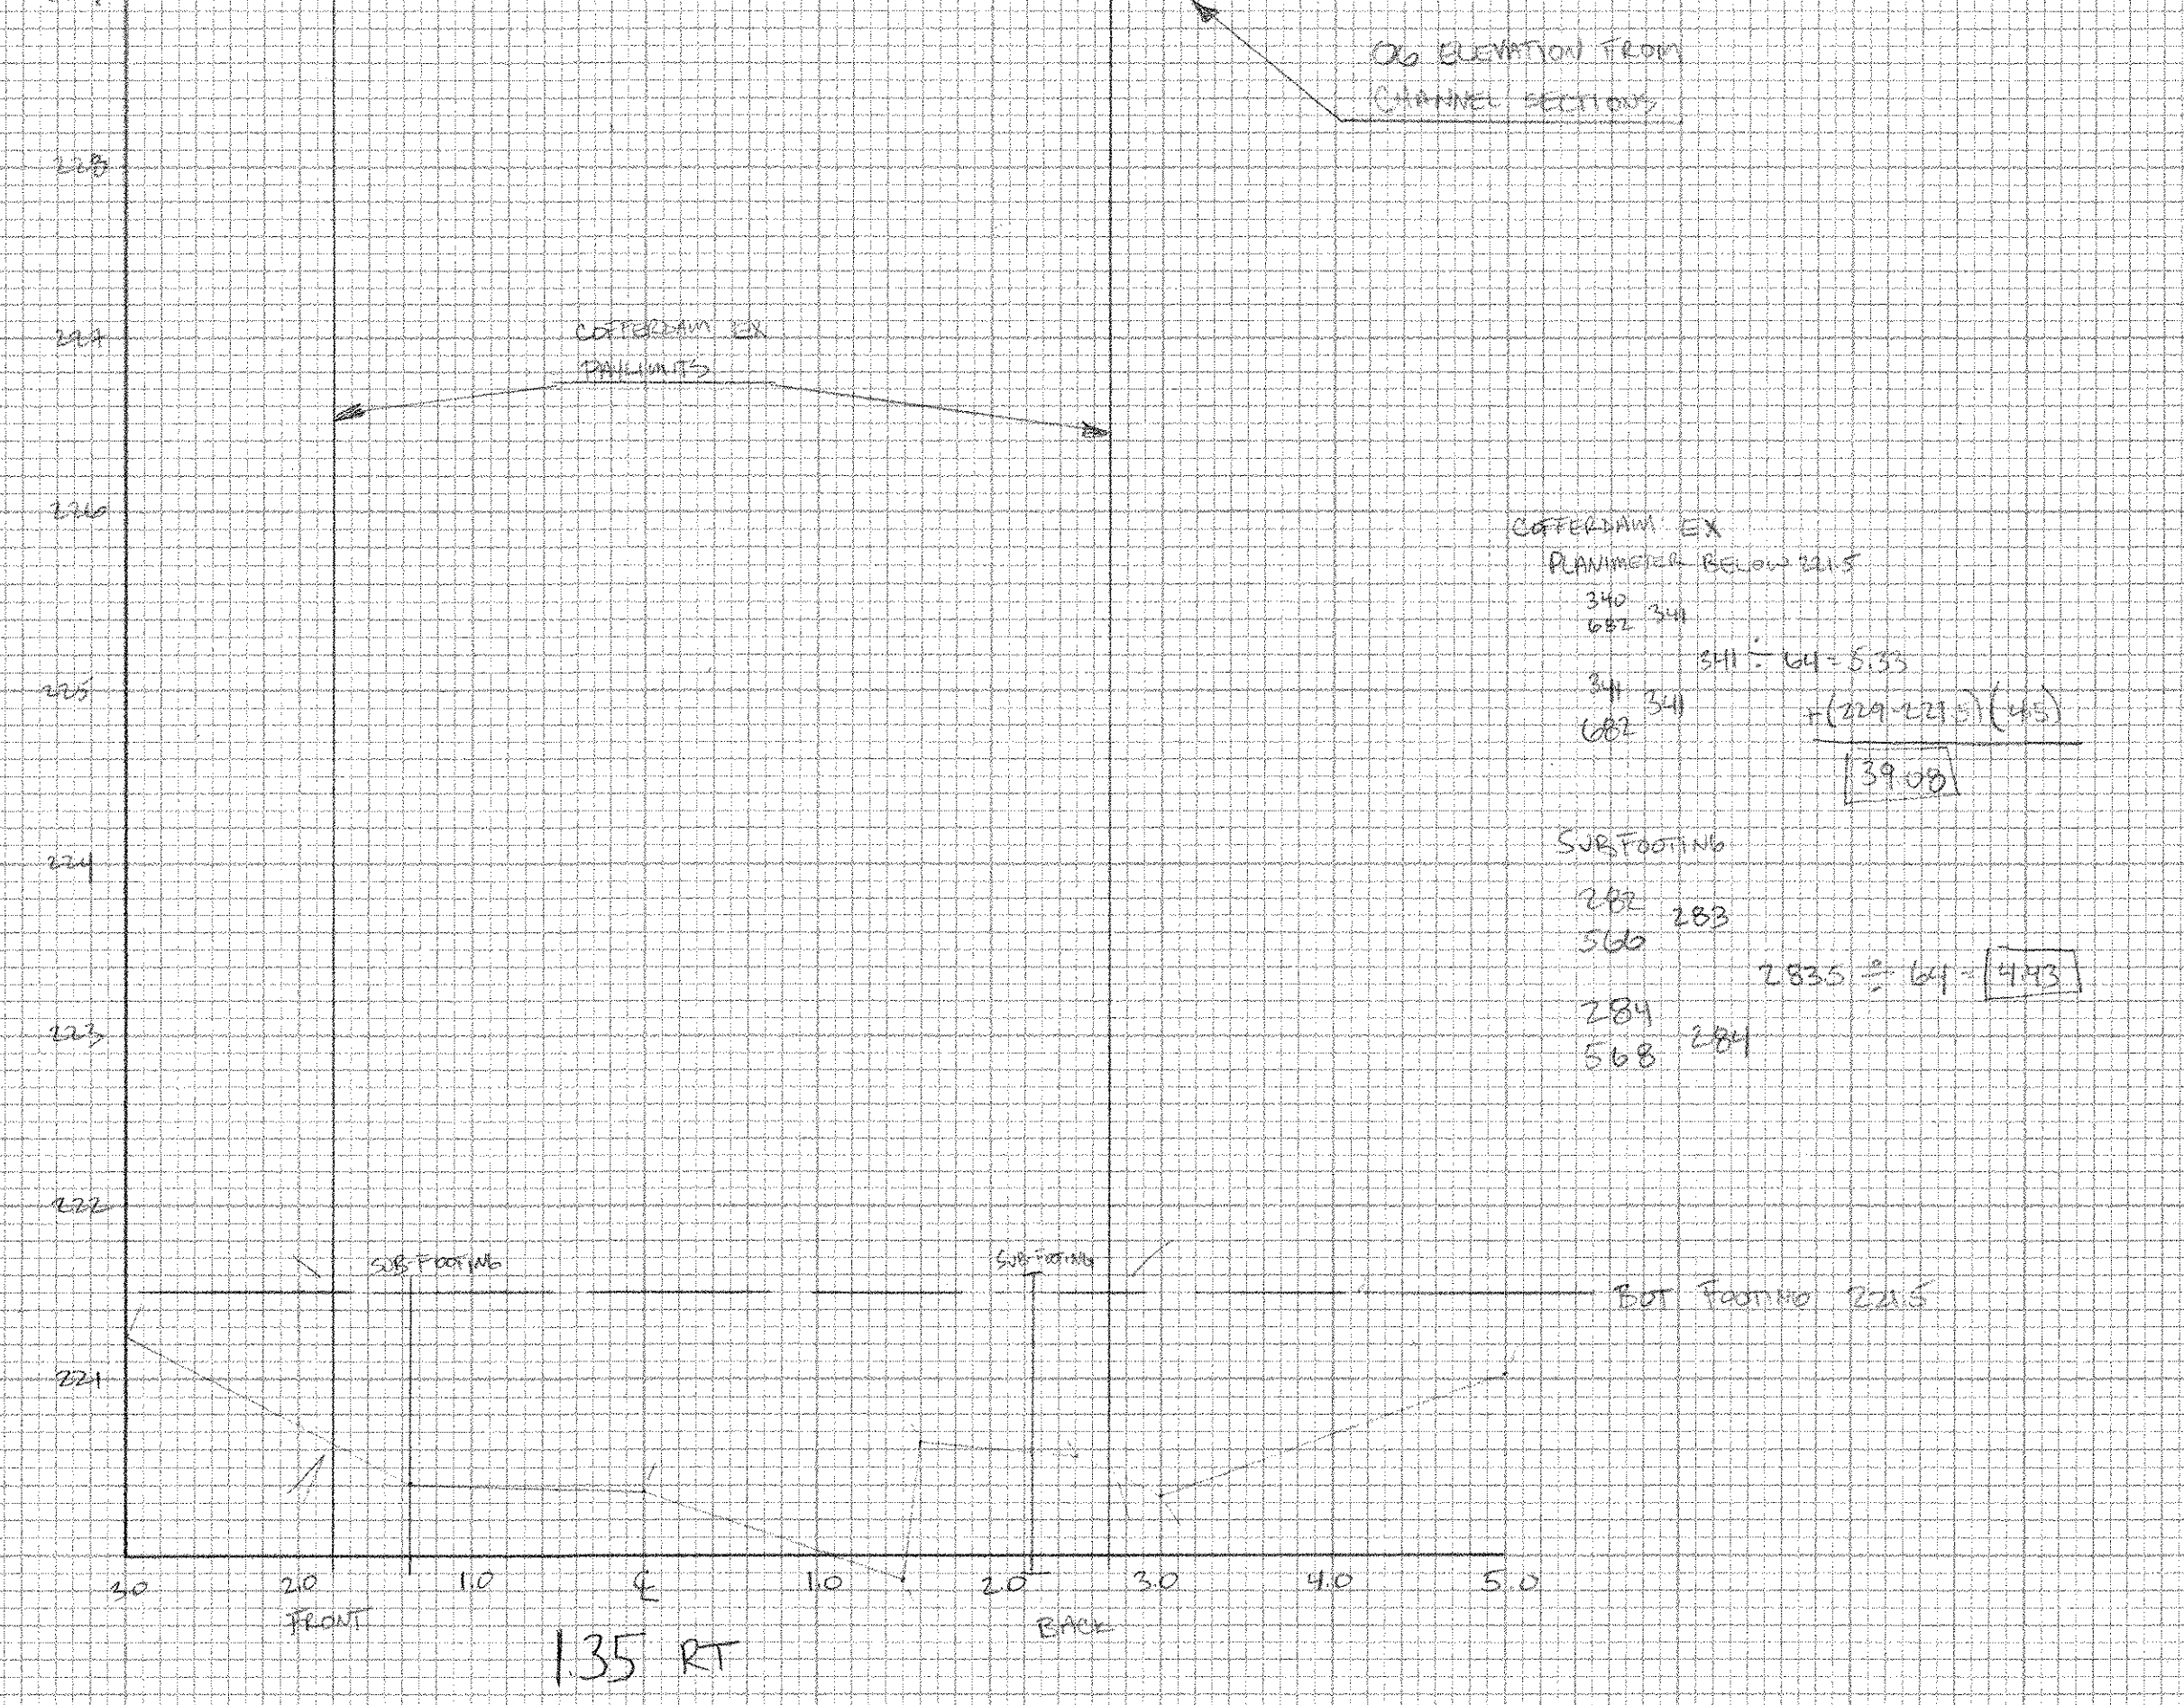
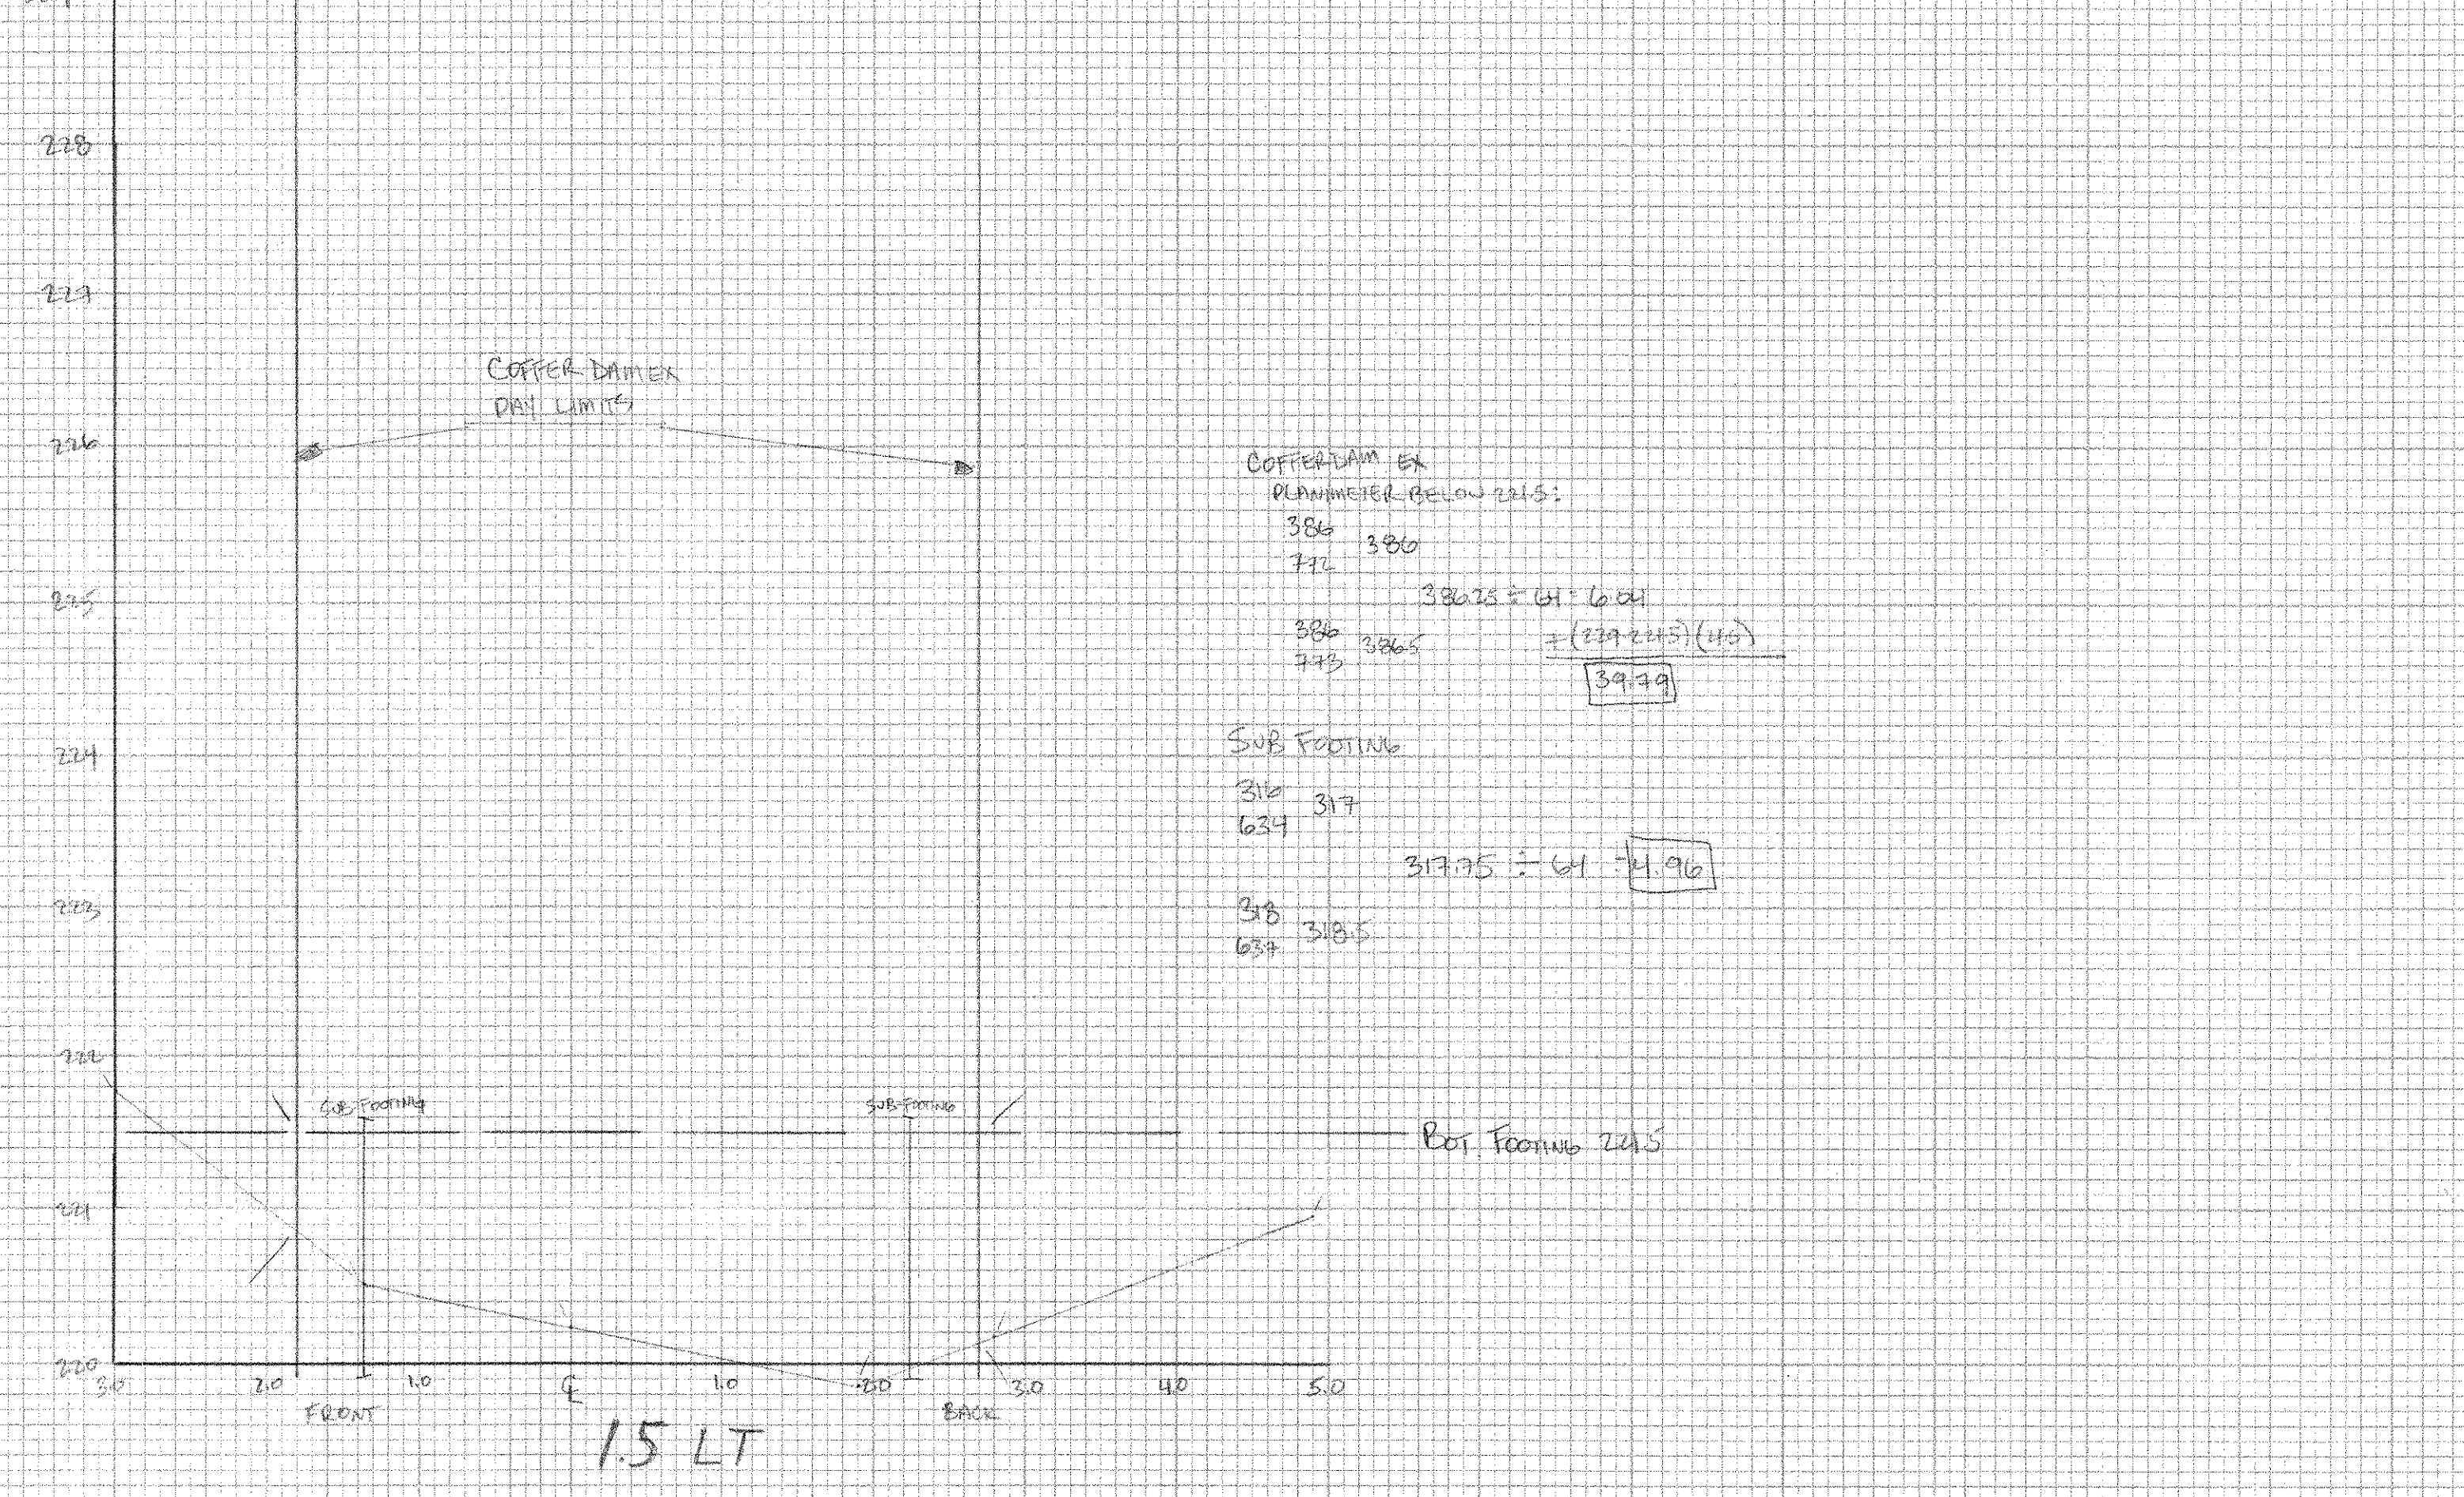


PLATE 3-FULL CROSS SECTION-FRONT VIEW
 DRAWING NUMBER: 0269(B)
 SCALE: AS SHOWN

NO. OF SHEETS: 5
 SHEET NO.: 5
 DATE: 6/19/06

NO. OF SHEETS: 5
 SHEET NO.: 5 OF 7
 DATE: 6/19/06